

T.2S. R.4E. Section 21, W.M.

17 | 16
20 | 21

TL 2 4E 21 500

29.7

Well 3
(CLAC 77226)
and meter

BPA Easement

Well 4
(CLAC 76955)
and meter

26.0

SE Tickle Creek Rd


Well 1
(CLAC 6057)
and meter

W 1/4 corner
Section 21

TL 2 4E 21 600

Unnamed tributary
to Deep Creek

Scale: 1" = 400'

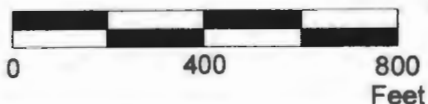

Well 1 (CLAC 6057) is located 455 feet north and 660 feet east from the W 1/4 corner, Section 21.

Well 3 (CLAC 77226) is located 1,910 feet north and 785 feet east from the W 1/4 corner, Section 21.

Well 4 (CLAC 76955) is located 1,265 feet north and 810 feet east from the W 1/4 corner, Section 21.

Area (33.7 Acres) of primary irrigation under T-13574, formerly Certificate 65961, priority date, 5-18-1982.

Area (63.0 Acres) of supplemental irrigation under T-13574, formerly Certificate 65961, priority date, 5-18-1982.
Primary Certificates 24380 & 24381.

----- Tax lot boundary

..... Water main line

MAY 18 2014

SE Tickle Creek Rd

SE Gunderson Rd

85503

DOUGLAS HAMILTON

MAY 10, 2012

STATE OF OREGON

EXPIRES: JUN 30 2015

This map was prepared for the purpose of identifying the location of a water right only and is not intended to provide legal dimensions or location of property ownership lines.

Claim of Beneficial Use Map
T-13574, formerly Certificate 65961

Townsend HB LLC
T.2S. R.4E. Section 21, W.M.

Pacific Hydro-Geology Inc.

12/2023