



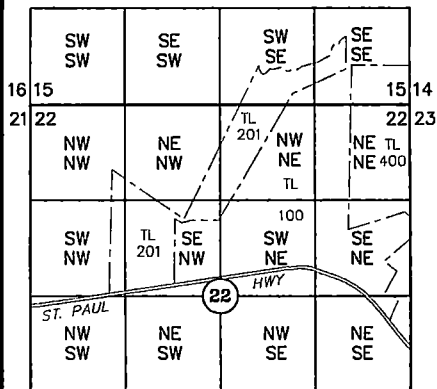


QUARTER-QUARTER SECTION GUIDE

NTS

T4S R2W, WM


MARION COUNTY

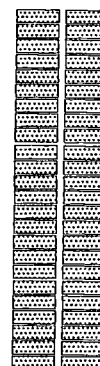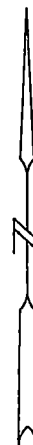

Reservoir 84745

N GREENHOUSE AREA DETAIL

North & South Greenhouse Areas

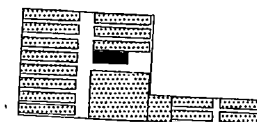

S GREENHOUSE AREA DETAIL


AGRICULTURAL USE
142.1 AC

SHADE & GREEN HOUSES

STRUCTURE

TAX LOT LINE

TAX LOTS:
4 2W 22 100
201
4 2W 23 400

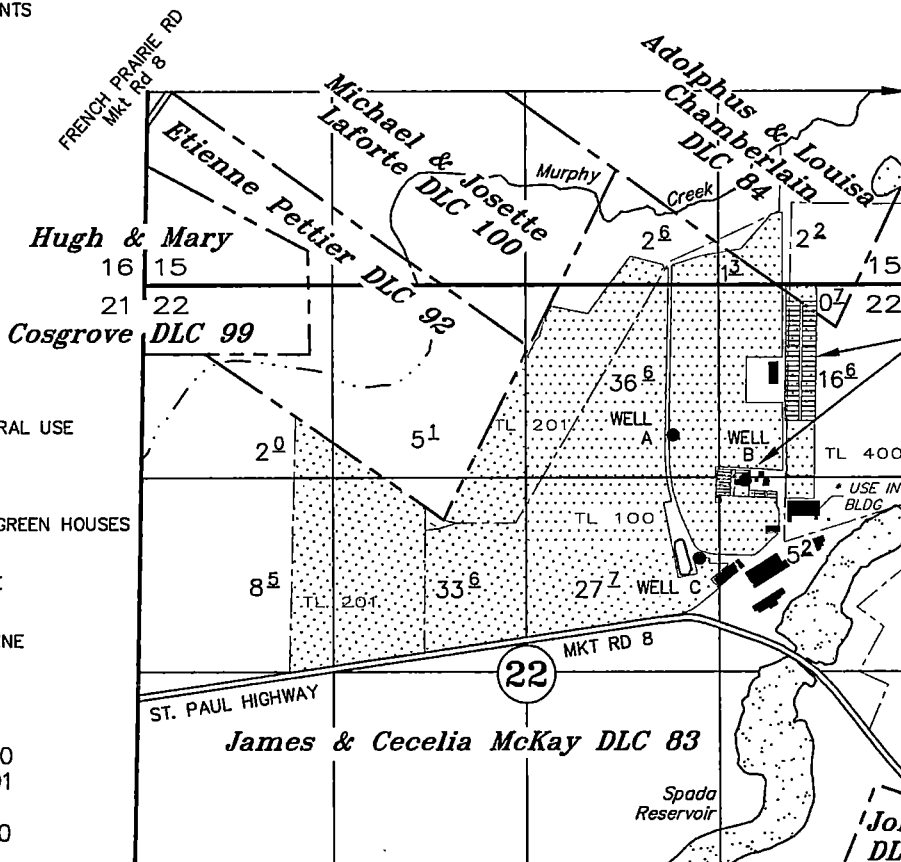

WELL A: 610' NORTH & 1520' EAST OF SE COR ETIENNE PETTIER DLC No. 92
WELL B: 300' NORTH & 2055' EAST OF SE COR ETIENNE PETTIER DLC No. 92
WELL C: 265' SOUTH & 1760' EAST OF SE COR ETIENNE PETTIER DLC No. 92

PLACES OF USE
BASED ON GOOGLE
EARTH PHOTO DATED
06-28-1995

CLAIM OF BENEFICIAL USE

Under

Application No. G-12714 Permit No. G-11673

A&R Spada Farms


Information based on Initial Field Visit: January 3, 1996
Follow-up Visits: December 10, 2007 &
October 19, 2023
SCALE: 1" = 1320'

NOTE: This map is for the purpose of
identifying the location of water rights
and has no intent to dimension or locate
property ownership lines.

Record:



Salem, OR

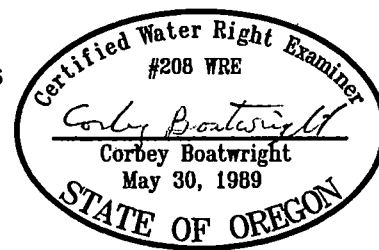

Renewal Date: December 31, 2025

T4S R2W, WM

MARION COUNTY

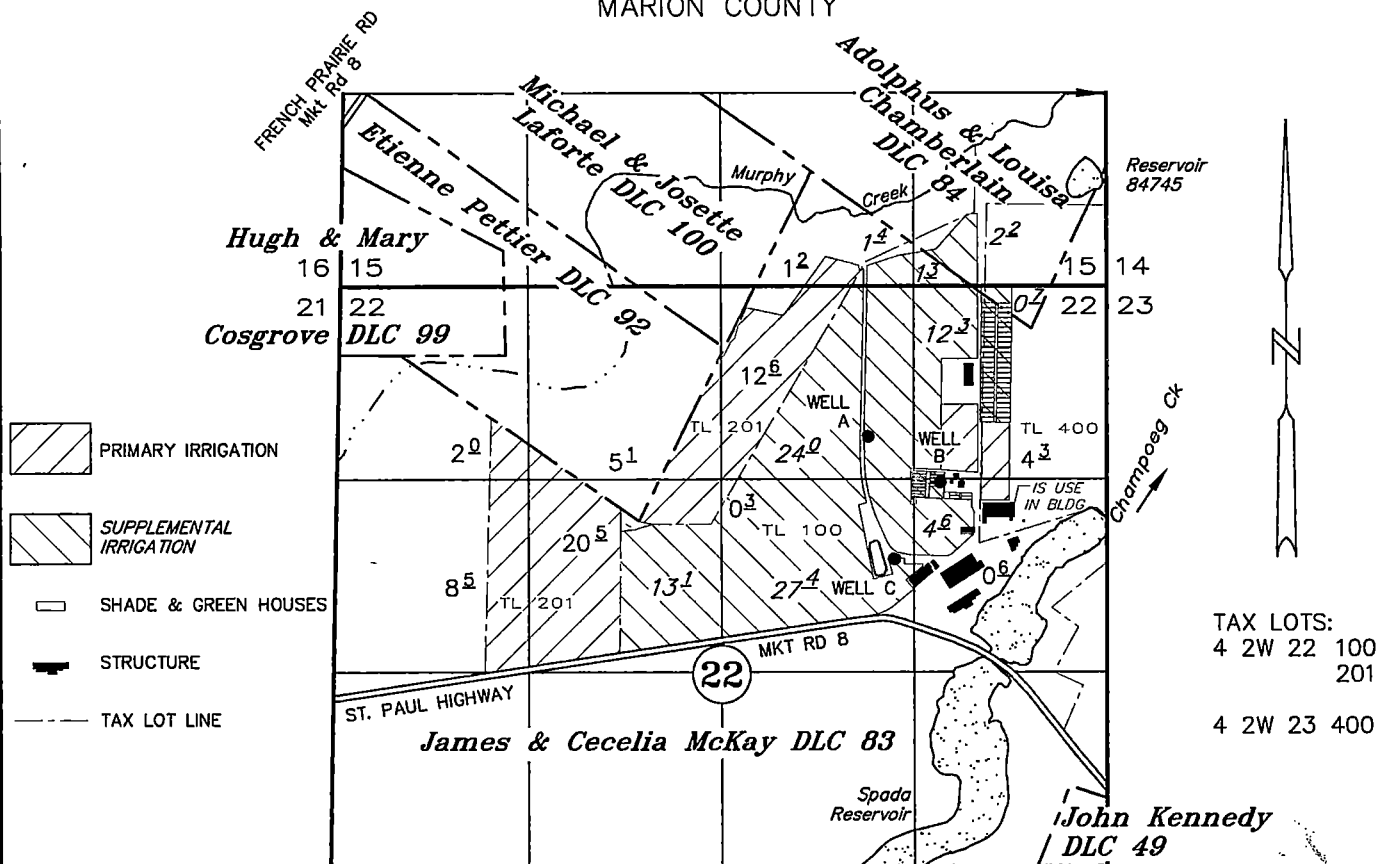

WELL A: 610' NORTH & 1520' EAST OF SE COR ETIENNE PETTIER DLC No. 92
 WELL B: 300' NORTH & 2055' EAST OF SE COR ETIENNE PETTIER DLC No. 92
 WELL C: 265' SOUTH & 1760' EAST OF SE COR ETIENNE PETTIER DLC No. 92

PLACES OF USE
 BASED ON GOOGLE
 EARTH PHOTO DATED
 06-28-1995

CLAIM OF BENEFICIAL USE

Under


Application No. G-12714 Permit No. G-11673

NOV 27 2024

A&R Spada Farms

Information based on Initial Field Visit: January 3, 1996
 Follow-up Visits: December 10, 2007 &
 October 19, 2023
 SCALE: 1" = 1320'


NOTE: This map is for the purpose of
 identifying the location of water rights
 and has no intent to dimension or locate
 property ownership lines.

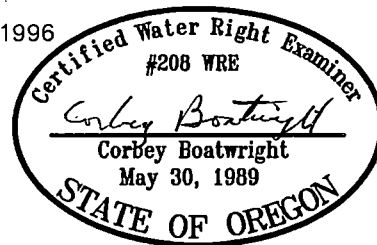

Renewal Date: December 31, 2025

T4S R2W, WM

MARION COUNTY

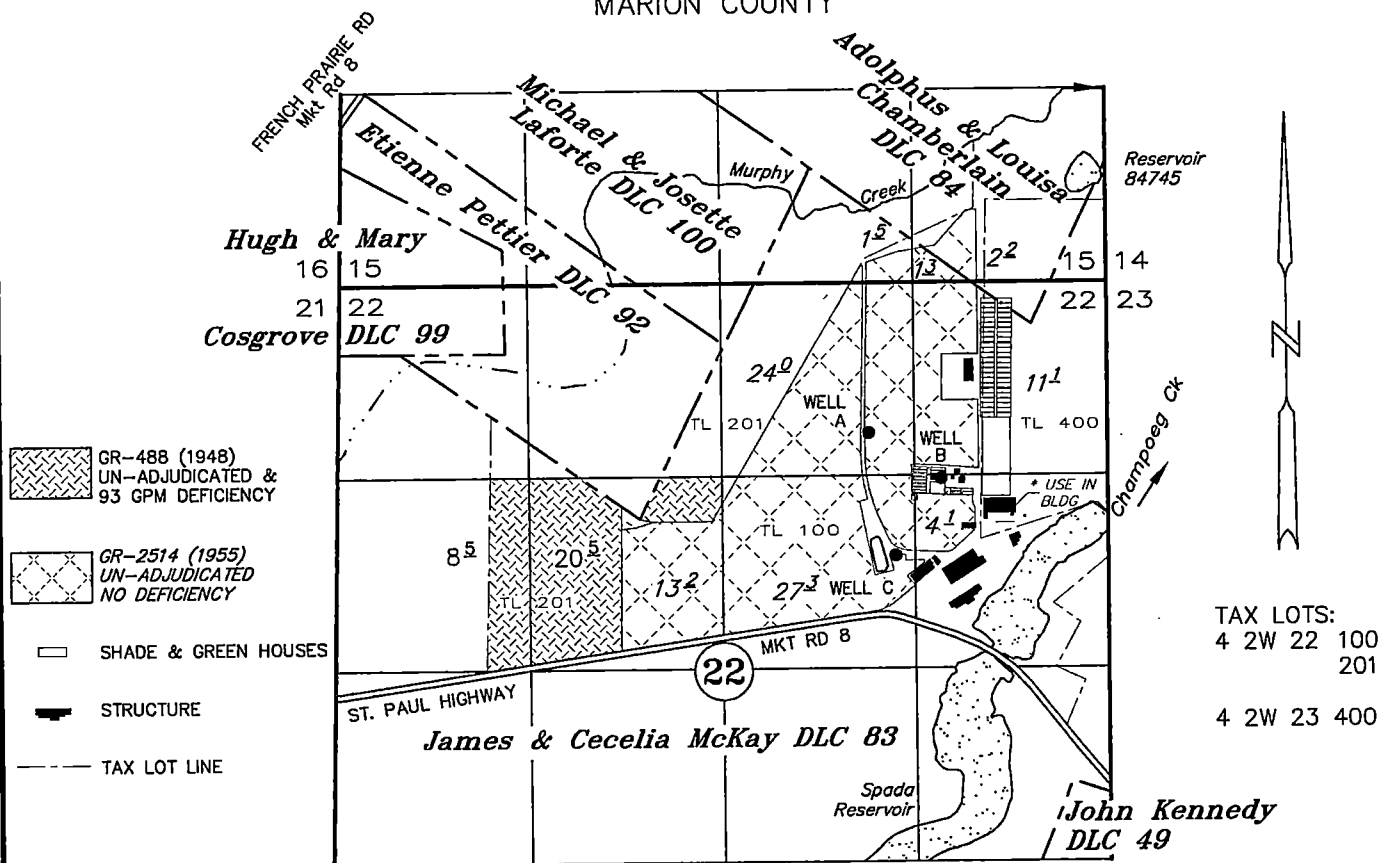

WELL A: 610' NORTH & 1520' EAST OF SE COR ETIENNE PETTIER DLC No. 92
WELL B: 300' NORTH & 2055' EAST OF SE COR ETIENNE PETTIER DLC No. 92
WELL C: 265' SOUTH & 1760' EAST OF SE COR ETIENNE PETTIER DLC No. 92

PLACES OF USE
BASED ON GOOGLE
EARTH PHOTO DATED
06-28-1995

CLAIM OF BENEFICIAL USE

Under

Application No. G-12714 Permit No. G-11673



NOV 27 2024

Siemens, C.

A&R Spada Farms

Information based on Initial Field Visit: January 3, 1996
Follow-up Visits: December 10, 2007 &
October 19, 2023
SCALE: 1" = 1320'


NOTE: This map is for the purpose of identifying the location of water rights and has no intent to dimension or locate property ownership lines.

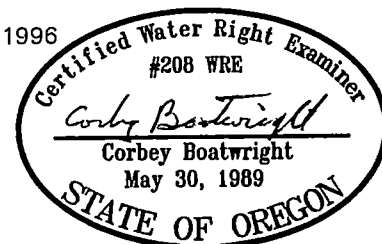

Renewal Date: December 31, 2025

T4S R2W, WM

MARION COUNTY

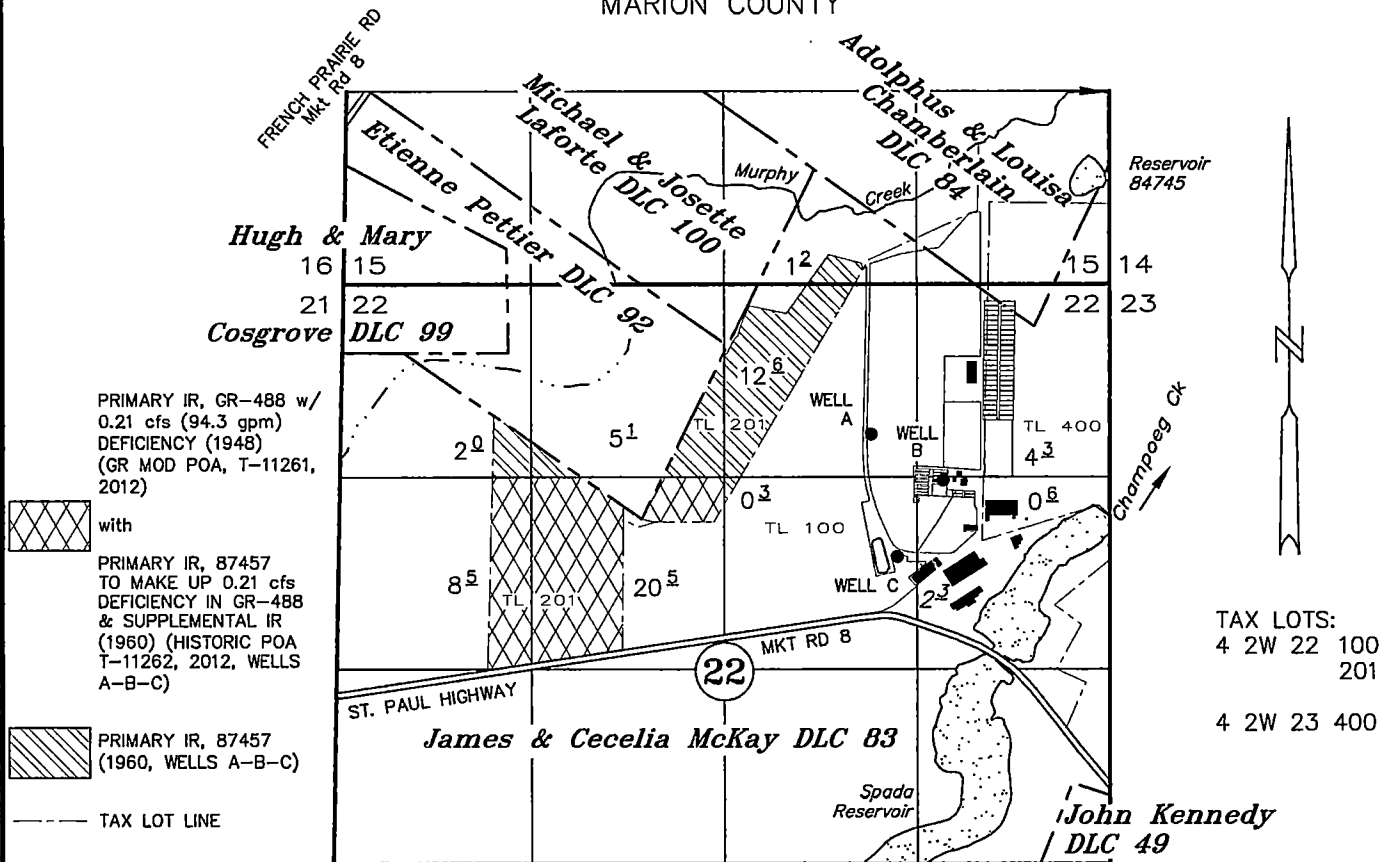

WELL A: 610' NORTH & 1520' EAST OF SE COR ETIENNE PETTIER DLC No. 92
 WELL B: 300' NORTH & 2055' EAST OF SE COR ETIENNE PETTIER DLC No. 92
 WELL C: 265' SOUTH & 1760' EAST OF SE COR ETIENNE PETTIER DLC No. 92

PLACES OF USE
 BASED ON GOOGLE
 EARTH PHOTO DATED
 06-28-1995

CLAIM OF BENEFICIAL USE


Under

Application No. G-12714 Permit No. G-11673

NOV 27 2024

A&R Spada Farms

Information based on Initial Field Visit: January 3, 1996
 Follow-up Visits: December 10, 2007 &
 October 19, 2023
 SCALE: 1" = 1320'

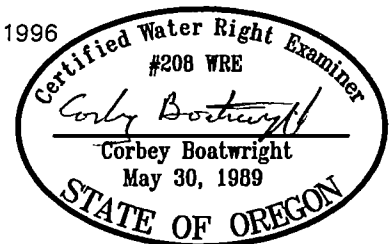


NOTE: This map is for the purpose of identifying the location of water rights and has no intent to dimension or locate property ownership lines.

Renewal Date: December 31, 2025

T4S R2W, WM

MARION COUNTY

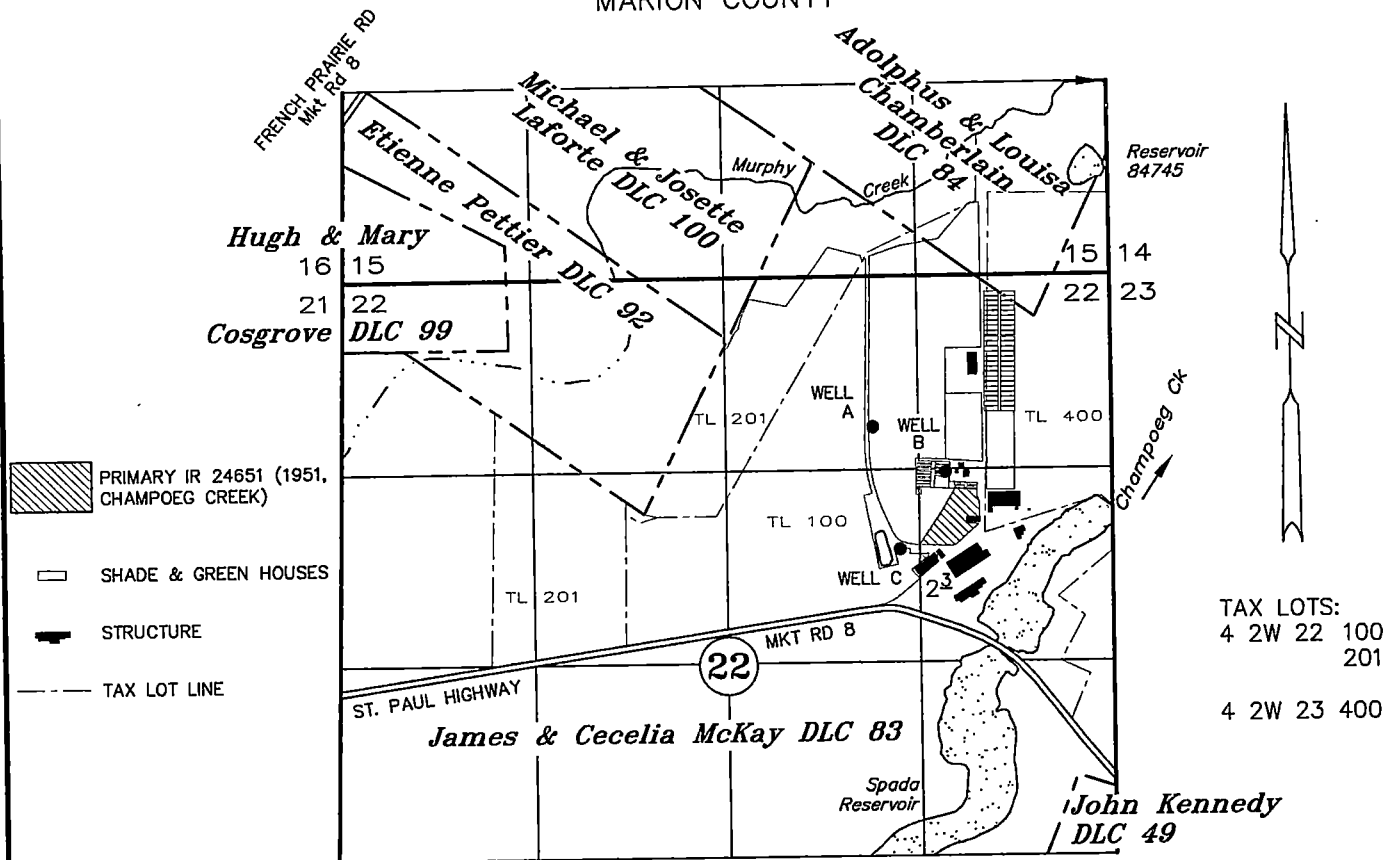

WELL A: 610' NORTH & 1520' EAST OF SE COR ETIENNE PETTIER DLC No. 92
 WELL B: 300' NORTH & 2055' EAST OF SE COR ETIENNE PETTIER DLC No. 92
 WELL C: 265' SOUTH & 1760' EAST OF SE COR ETIENNE PETTIER DLC No. 92

PLACES OF USE
 BASED ON GOOGLE
 EARTH PHOTO DATED
 06-28-1995

CLAIM OF BENEFICIAL USE


Under

Application No. G-12714 Permit No. G-11673

NOV 27 2024

A&R Spada Farms

Information based on Initial Field Visit: January 3, 1996
 Follow-up Visits: December 10, 2007 &
 October 19, 2023
 SCALE: 1" = 1320'

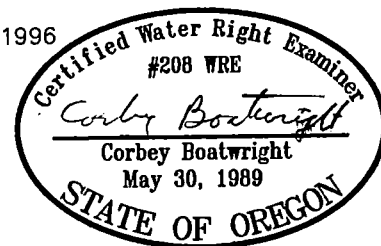


NOTE: This map is for the purpose of identifying the location of water rights and has no intent to dimension or locate property ownership lines.

Renewal Date: December 31, 2025

T4S R2W, WM

MARION COUNTY

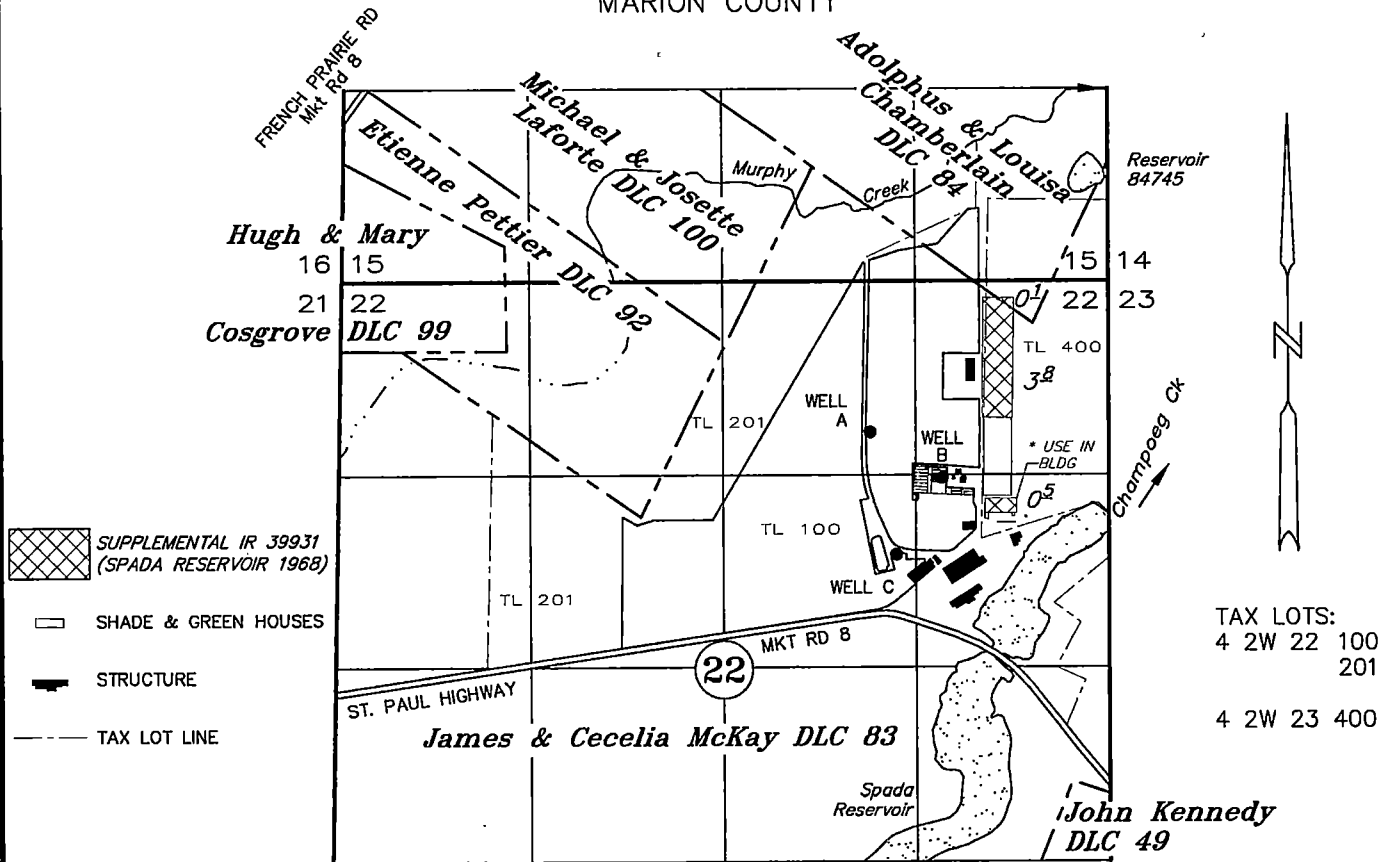

WELL A: 610' NORTH & 1520' EAST OF SE COR ETIENNE PETTIER DLC No. 92
 WELL B: 300' NORTH & 2055' EAST OF SE COR ETIENNE PETTIER DLC No. 92
 WELL C: 265' SOUTH & 1760' EAST OF SE COR ETIENNE PETTIER DLC No. 92

PLACES OF USE
 BASED ON GOOGLE
 EARTH PHOTO DATED
 06-28-1995

CLAIM OF BENEFICIAL USE


Under

Application No. G-12714 Permit No. G-11673

A&R Spada Farms

Information based on Initial Field Visit: January 3, 1996
 Follow-up Visits: December 10, 2007 &
 October 19, 2023
 SCALE: 1" = 1320'

NOTE: This map is for the purpose of identifying the location of water rights and has no intent to dimension or locate property ownership lines.

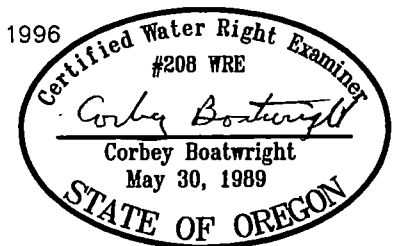

Renewal Date: December 31, 2025

MARION COUNTY

NOTE:
39930 RIGHT IN
THIS AREA WAS
DESIGNATED
"SUPPLEMENTAL"
BASED ON
UNDERLYING (BUT
UN-ADJUDICATED)
GR-2514.

PRIMARY IR, GR-2514
(1954) (GR MOD POA,
T-11257, 2012)



SUPPLEMENTAL IR 39930
(1967 SPADA RES)

☐ SHADE & GREEN HOUSES

STRUCTURE

--- TAX LOT LINE

Reservoir
84745

TAX LOTS:
4 2W 22 100
201
4 2W 23 400

WELL A: 610' NORTH & 1520' EAST OF SE COR ETIENNE PETTIER DLC No. 92
WELL B: 300' NORTH & 2055' EAST OF SE COR ETIENNE PETTIER DLC No. 92
WELL C: 265' SOUTH & 1760' EAST OF SE COR ETIENNE PETTIER DLC No. 92

PLACES OF USE
BASED ON GOOGLE
EARTH PHOTO DATED
06-28-1995

CLAIM OF BENEFICIAL USE

Under

Application No. G-12714 Permit No. G-11673

Approved by OWA:


NOV 27 2024

22 June 1964

A&R Spada Farms

Information based on Initial Field Visit: January 3, 1996
Follow-up Visits: December 10, 2007 &
October 19, 2023
SCALE: 1" = 1320'


NOTE: This map is for the purpose of identifying the location of water rights and has no intent to dimension or locate property ownership lines.

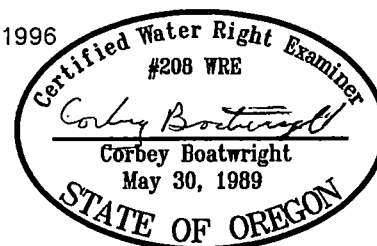

Renewal Date: December 31, 2025

T4S R2W, WM

MARION COUNTY

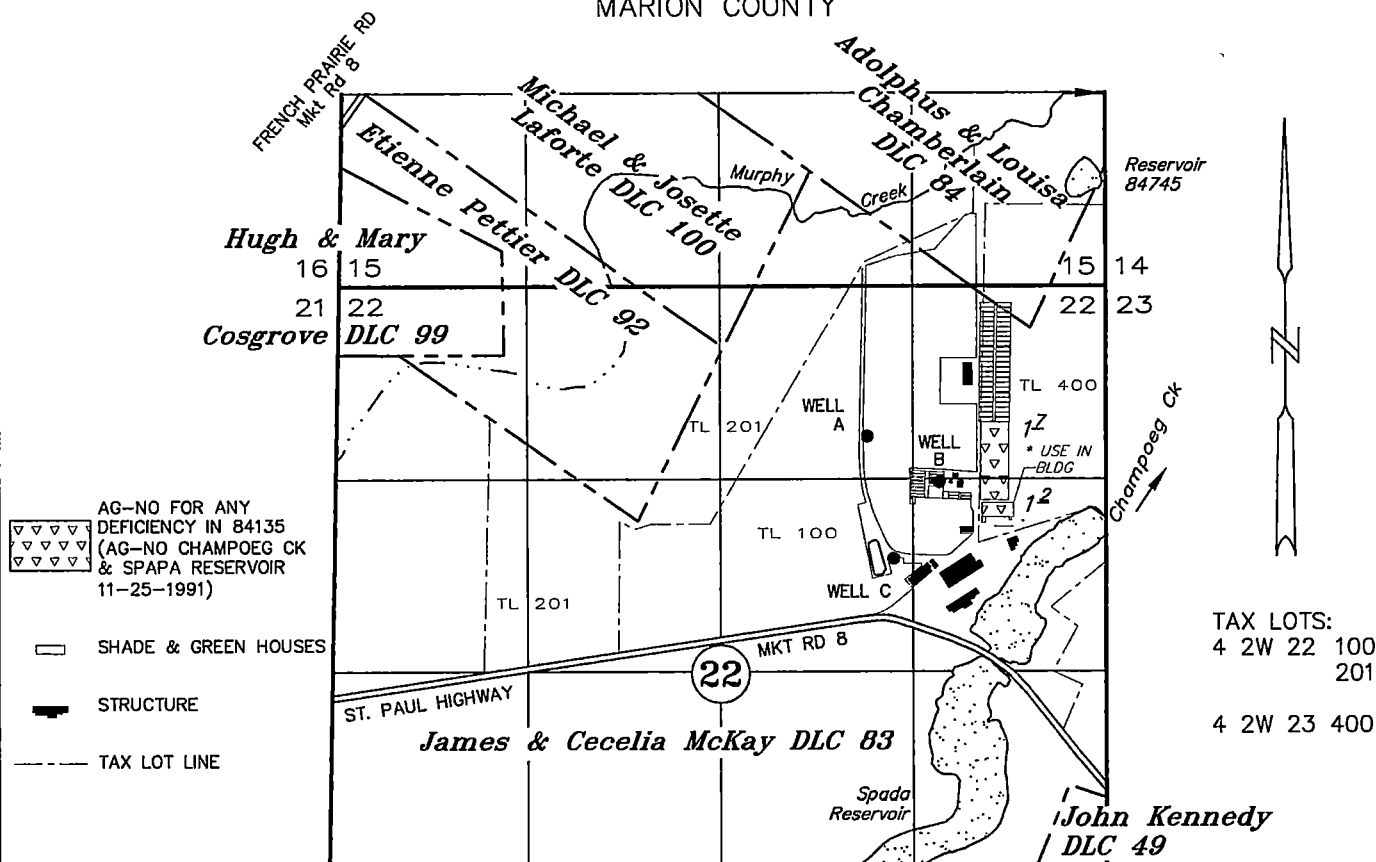

WELL A: 610' NORTH & 1520' EAST OF SE COR ETIENNE PETTIER DLC No. 92
 WELL B: 300' NORTH & 2055' EAST OF SE COR ETIENNE PETTIER DLC No. 92
 WELL C: 265' SOUTH & 1760' EAST OF SE COR ETIENNE PETTIER DLC No. 92

PLACES OF USE
 BASED ON GOOGLE
 EARTH PHOTO DATED
 06-28-1995

CLAIM OF BENEFICIAL USE


Under

Application No. G-12714 Permit No. G-11673

A&R Spada Farms

Information based on Initial Field Visit: January 3, 1996
 Follow-up Visits: December 10, 2007 &
 October 19, 2023
 SCALE: 1" = 1320'


NOTE: This map is for the purpose of identifying the location of water rights and has no intent to dimension or locate property ownership lines.

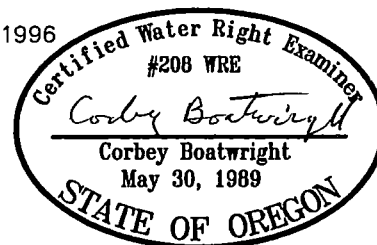

Renewal Date: December 31, 2025

T4S R2W, WM

MARION COUNTY

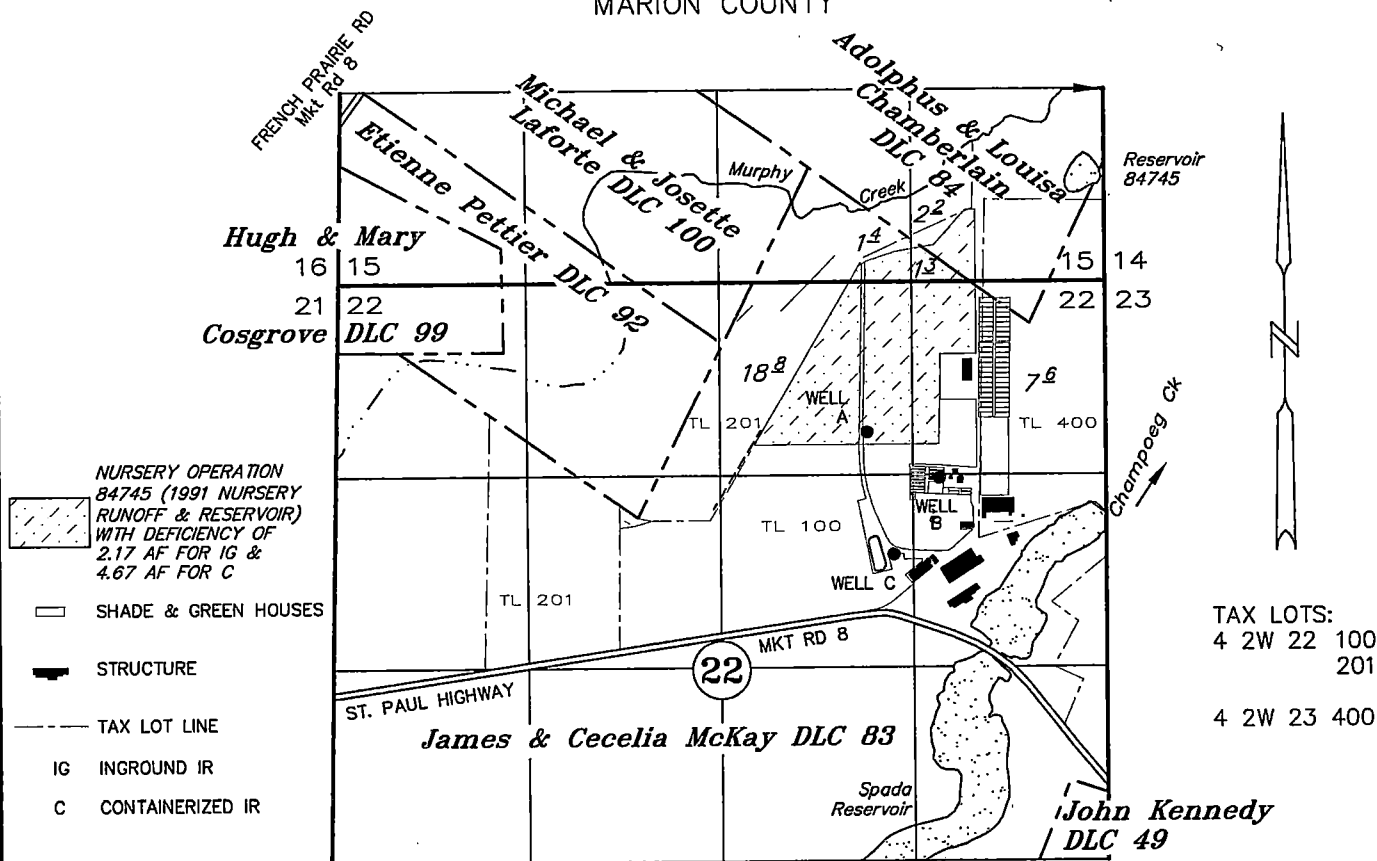

WELL A: 610' NORTH & 1520' EAST OF SE COR ETIENNE PETTIER DLC No. 92
 WELL B: 300' NORTH & 2055' EAST OF SE COR ETIENNE PETTIER DLC No. 92
 WELL C: 265' SOUTH & 1760' EAST OF SE COR ETIENNE PETTIER DLC No. 92

PLACES OF USE
 BASED ON GOOGLE
 EARTH PHOTO DATED
 06-28-1995


CLAIM OF BENEFICIAL USE

Under

Application No. G-12714 Permit No. G-11673

A&R Spada Farms

Information based on Initial Field Visit: January 3, 1996
 Follow-up Visits: December 10, 2007 &
 October 19, 2023
 SCALE: 1" = 1320'


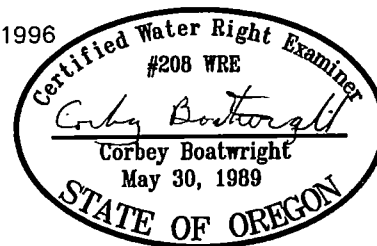


NOTE: This map is for the purpose of identifying the location of water rights and has no intent to dimension or locate property ownership lines.

Renewal Date: December 31, 2025

T4S R2W, WM

MARION COUNTY

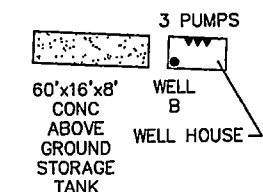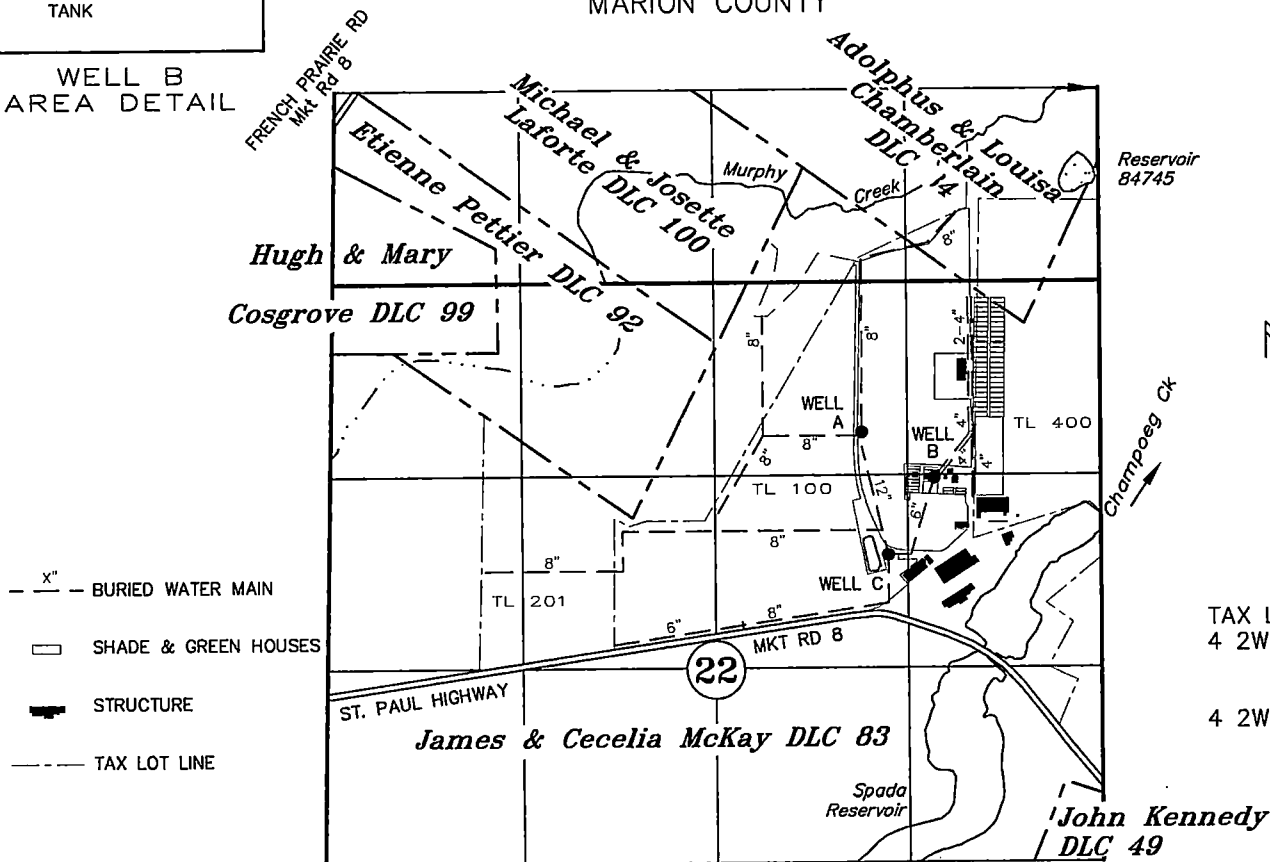WELL B
AREA DETAIL

WELL A: 610' NORTH & 1520' EAST OF SE COR ETIENNE PETTIER DLC No. 92
WELL B: 300' NORTH & 2055' EAST OF SE COR ETIENNE PETTIER DLC No. 92
WELL C: 265' SOUTH & 1760' EAST OF SE COR ETIENNE PETTIER DLC No. 92

PLACES OF USE
BASED ON GOOGLE
EARTH PHOTO DATED
06-28-1995

BURIED WATER MAINS

CLAIM OF BENEFICIAL USE


Under

Application No. G-12714 Permit No. G-11673

A&R Spada Farms

Information based on Initial Field Visit: January 3, 1996
Follow-up Visits: December 10, 2007 &
October 19, 2023
SCALE: 1" = 1320'

NOTE: This map is for the purpose of
identifying the location of water rights
and has no intent to dimension or locate
property ownership lines.

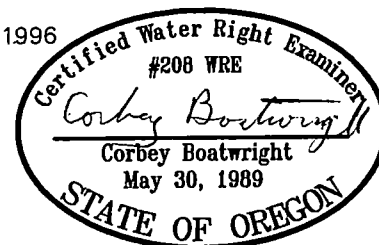

Renewal Date: December 31, 2025