
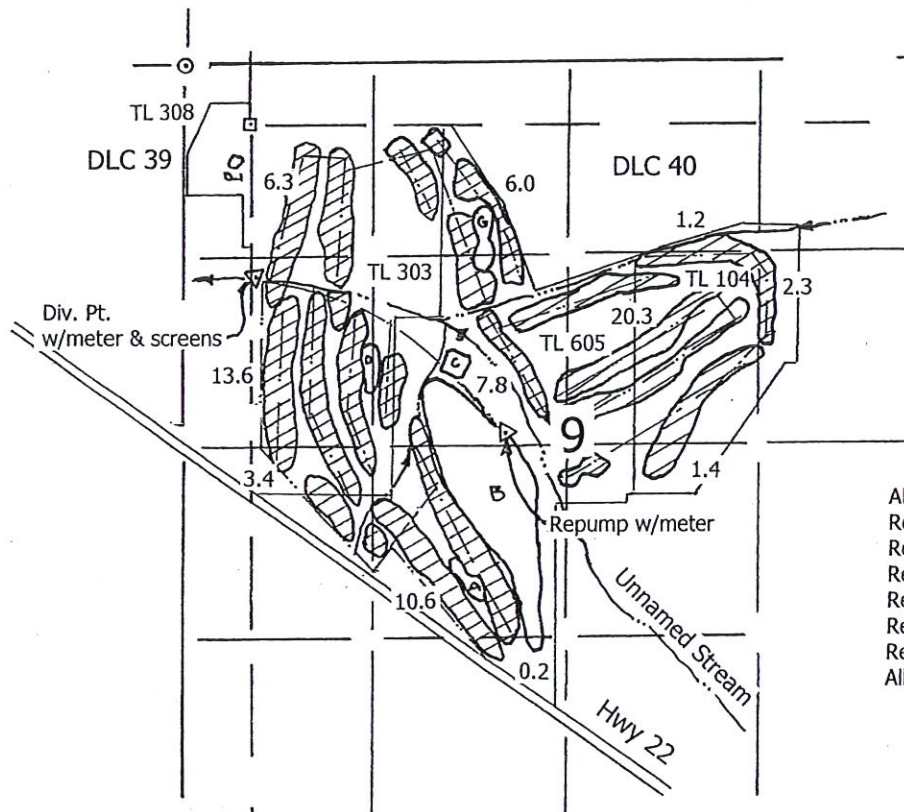


FINAL PROOF SURVEY MAP

Timothy & Kathleen Tarpley

Section 9, T 7 S R 5 W, W.M.

R-72926/R-11548 & S-72927/S-51613

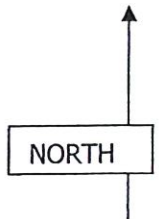

ALL RESERVOIRS ARE OFF-CHANNEL:
 Res. A: 3500' S & 1400' E
 Res. B: 1800' S & 1300' E
 Res. C: 1600' S & 1400' E
 Res. D: 1600' S & 800' E
 Res. D-1: 200' S & 100' W
 Res. G: 600' S & 1600' E
 All from the NW corner DLC 40

RECEIVED

JUL 06 2015

WATER RESOURCES DEPT
 SALEM, OREGON

RECEIVED

JUL 07 2015


WATER RESOURCES DEPT
 SALEM, OREGON

Div.Pt.: 1090' S & 30' E from the NW corner DLC 40
 Repump: 2120' S & 1740' E from the NW corner DLC 40

Scale 4" = 1 mile

This map is not intended to provide legal
 dimensions or locations of property ownership lines.

Section line ————
 DLC line ————
 1/4 1/4 line ————
 Tax Lot line ————
 Pipe line ————

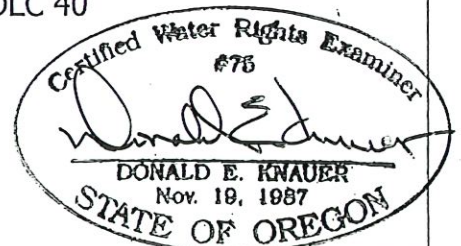

RENEWAL DATE: 6/30/2015