
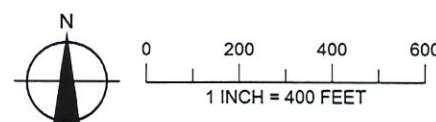


- LEGEND**
- Point of Diversion (POD)
 - Place of Use (POU)
 - Tax Lot
 - Donation Land Survey (DLC)
 - Watercourse
 - Waterbody

Claim of Beneficial Use Map
Application S-70215; Transfer T-13455
Yamhill County
Township 2 South, Range 4 West (W.M.)

Received
OCT 11 2024
OWRD

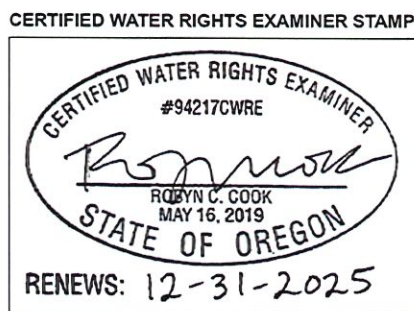

DISCLAIMER
This map was prepared for the purpose of identifying the location of a water right only and it is not intended to provide legal dimensions or location of property ownership lines.
Date: October 7, 2024
Data Sources: BLM, ESRI, OWRD, USGS

