


FINAL CLAIM MAP TRANSFER T-11369
SECTION 14
TOWNSHIP 38 SOUTH, RANGE 7 WEST, W.M.
JOSEPHINE COUNTY, OREGON
FOR
PHILLIP E. SICHENEDER
7911 DEER CREEK ROAD - SELMA, OR 97538

Map 1 of 2

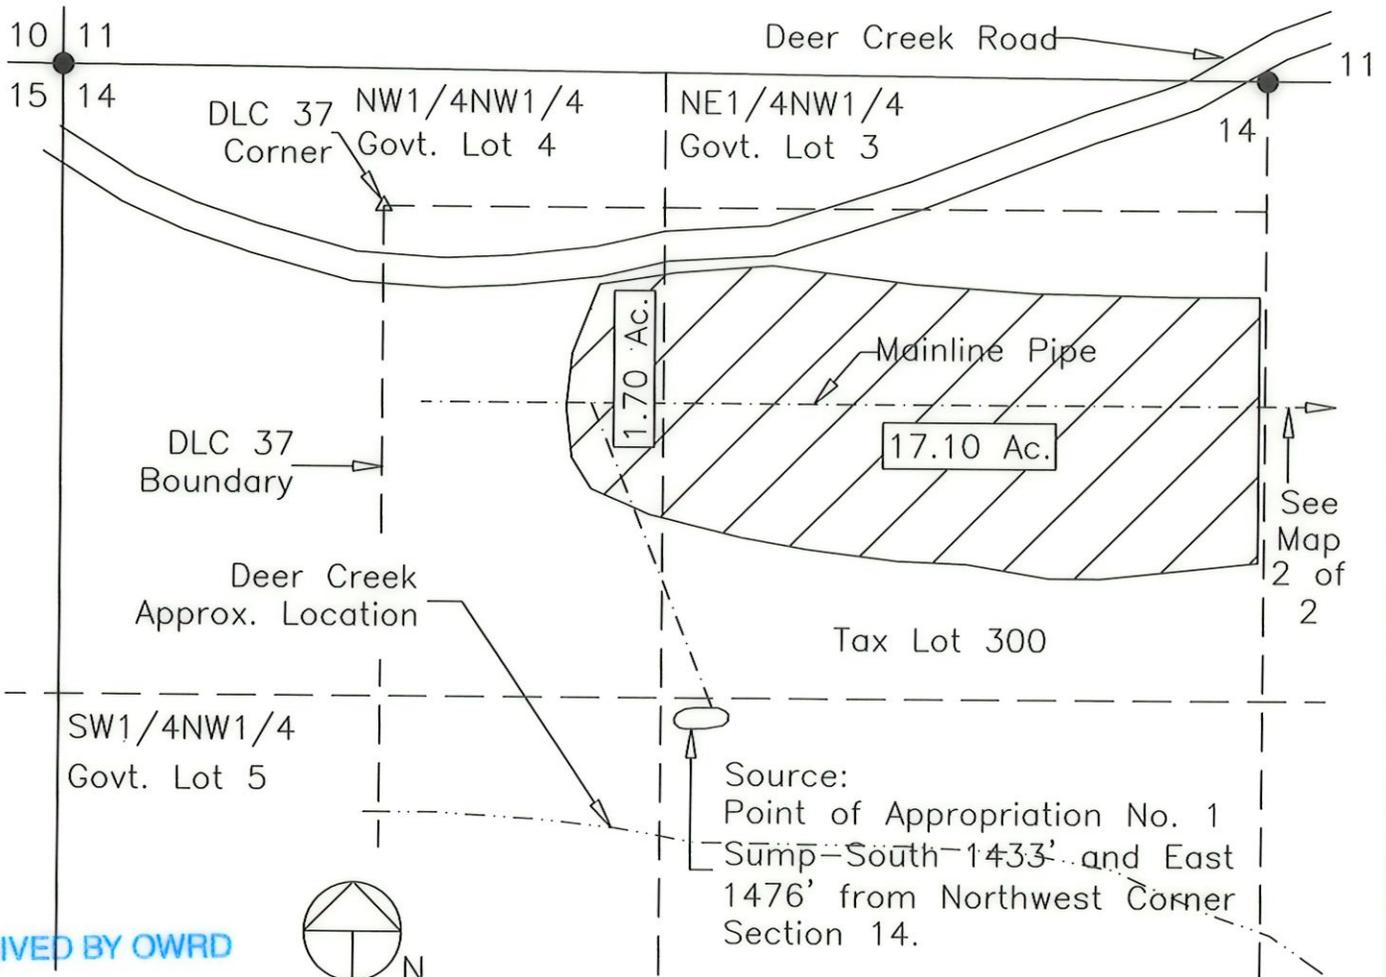

RECEIVED BY OWRD



AUG 03 2015

Scale: 1"=400'
Date: July 6, 2015


SALEM, OR

LEGEND

- Denotes Found Survey Monument
-  Denotes Area P.O.A. No. 1, Primary Irrigation Certificate 66470
- Denotes Mainline Pipe

This map was prepared for the purpose of identifying the location of a water right only and is not intended to provide legal dimensions or location of property ownership.

PROJECT: 15-09 SICHENEDER (SICH1.DWG)

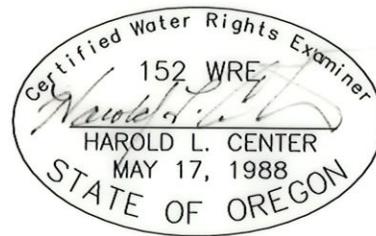



Renews: 12/31/15

HAROLD L. CENTER P.L.S., C.W.R.E.
2604 David Lane
Medford, OR. 97504
Phone 541-535-6108
Oregon Certificate No. 152

MAP 929

FINAL CLAIM MAP TRANSFER T-11369
SECTION 13
TOWNSHIP 38 SOUTH, RANGE 7 WEST, W.M.
JOSEPHINE COUNTY, OREGON
FOR
PHILLIP E. SICHENER
7911 DEER CREEK ROAD - SELMA, OR 97538

Section 18, T.38S., R.6W., W.M. Map 2 of 2

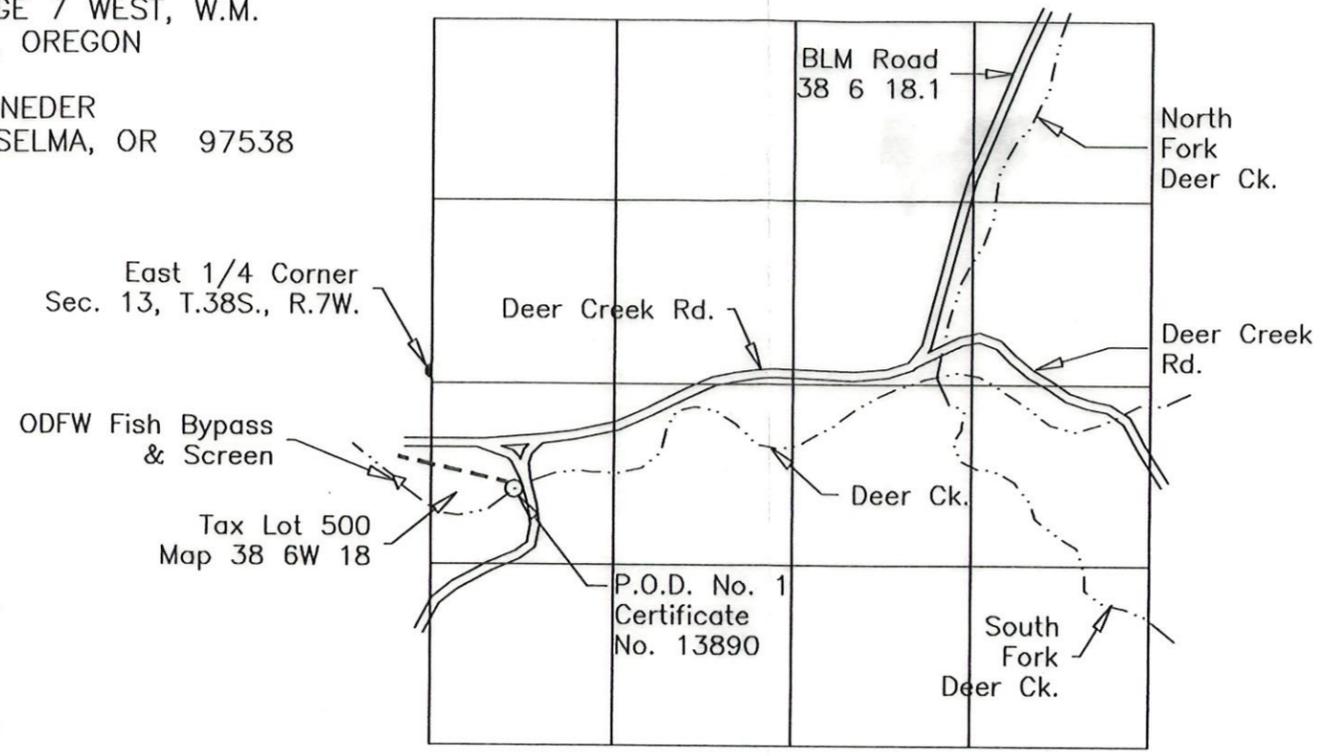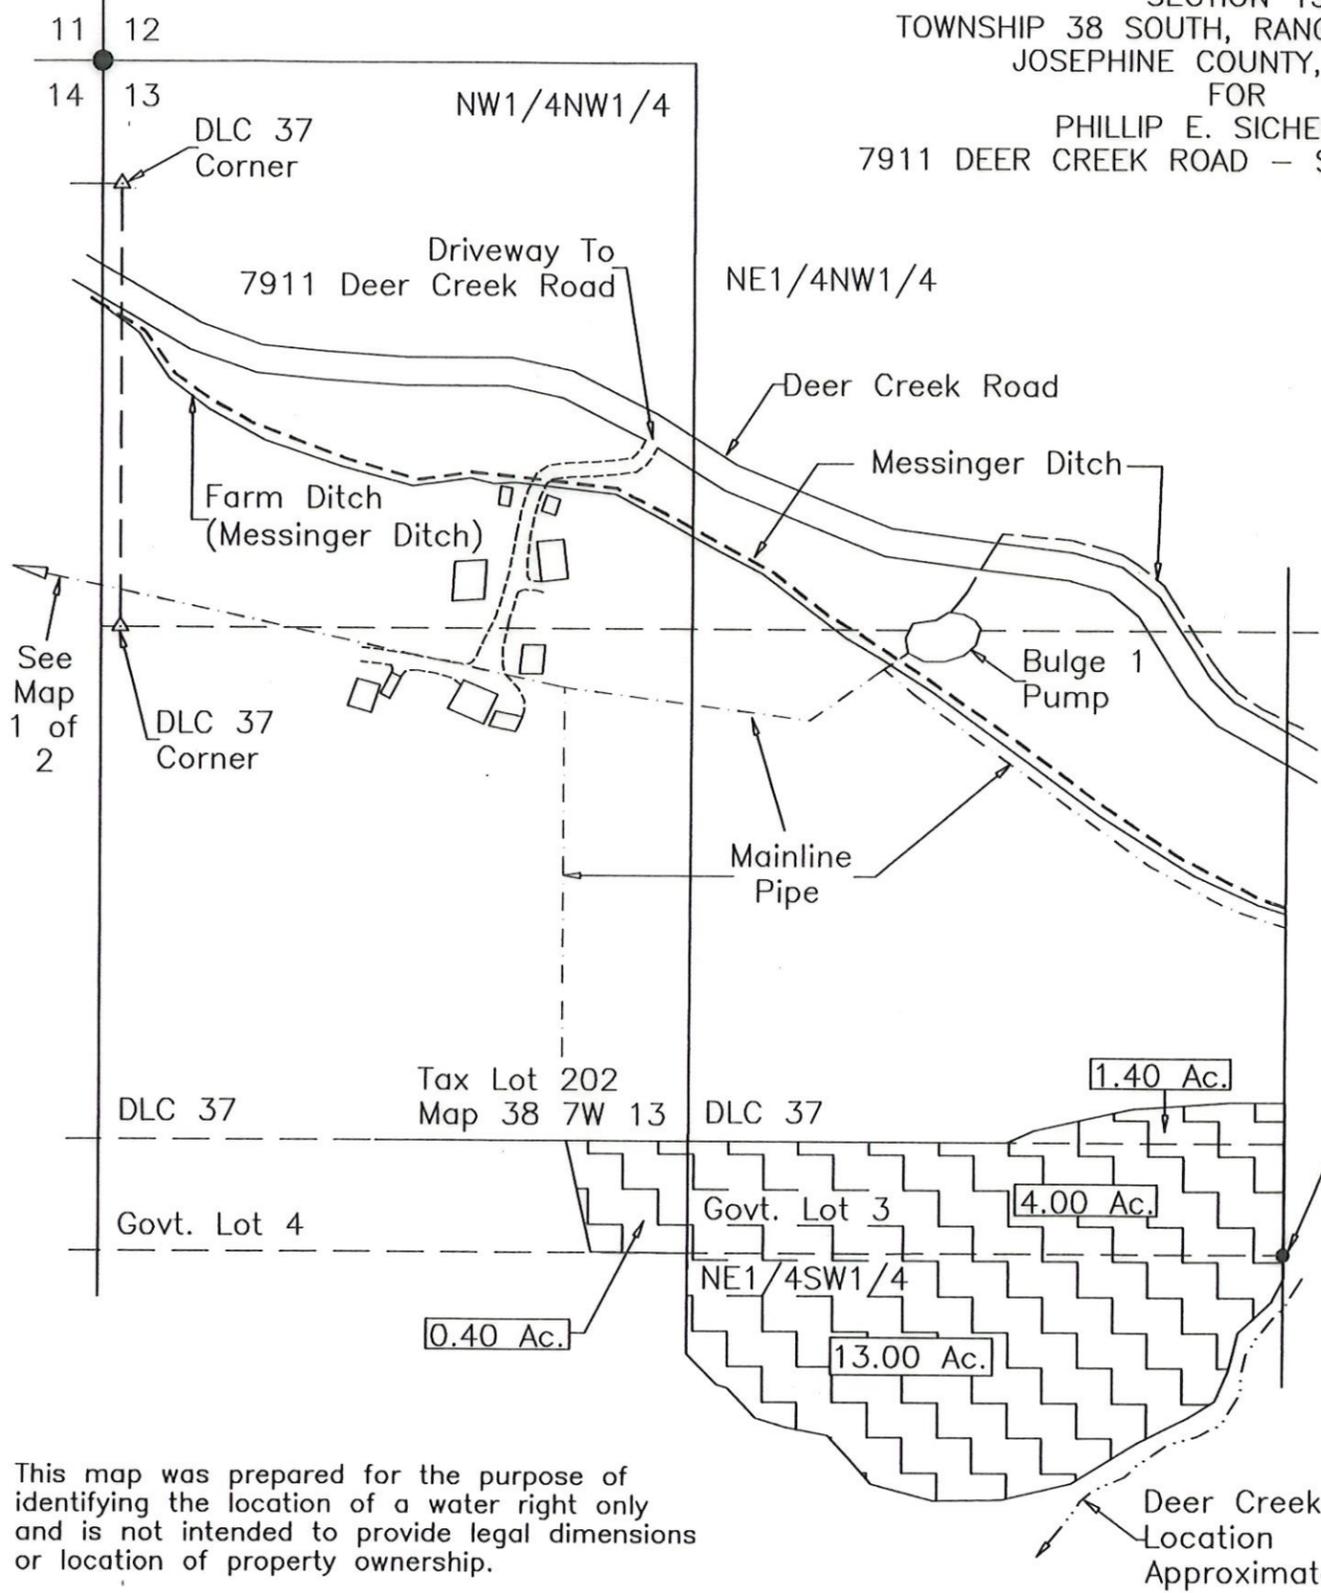


○ Authorized Point of Diversion No. 1
Messinger Ditch, Bears South 715'
and East 3360' from the Center
1/4 Corner Section 13, T.39S.,
R.7W., Source: Deer Creek

RECEIVED BY OWRD
AUG 03 2015
SALEM, OR

Center 1/4 Cor.
Section 13

Scale: 1"=400'
Date: July 6, 2015

- LEGEND**
- Denotes Area P.O.D. No. 1 Primary Certificate 13890, POA No. 1 Supplemental Certificate 66470
 - Denotes Building/Structure
 - Found Survey Monument
 - Denotes Mainline

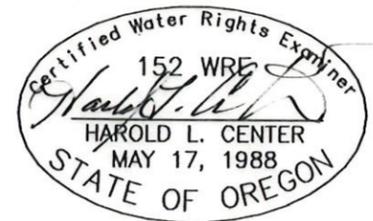

Renews: 12/31/15

HAROLD L. CENTER, P.L.S., C.W.R.E.
2604 David Lane
Medford, OR. 97504
Phone 541-535-6108
Oregon Certificate No. 152

This map was prepared for the purpose of identifying the location of a water right only and is not intended to provide legal dimensions or location of property ownership.