


Claim of Beneficial Use

Permit S-46813, Application S-61486

A Water Right held by Daniel Arriola
Coos County

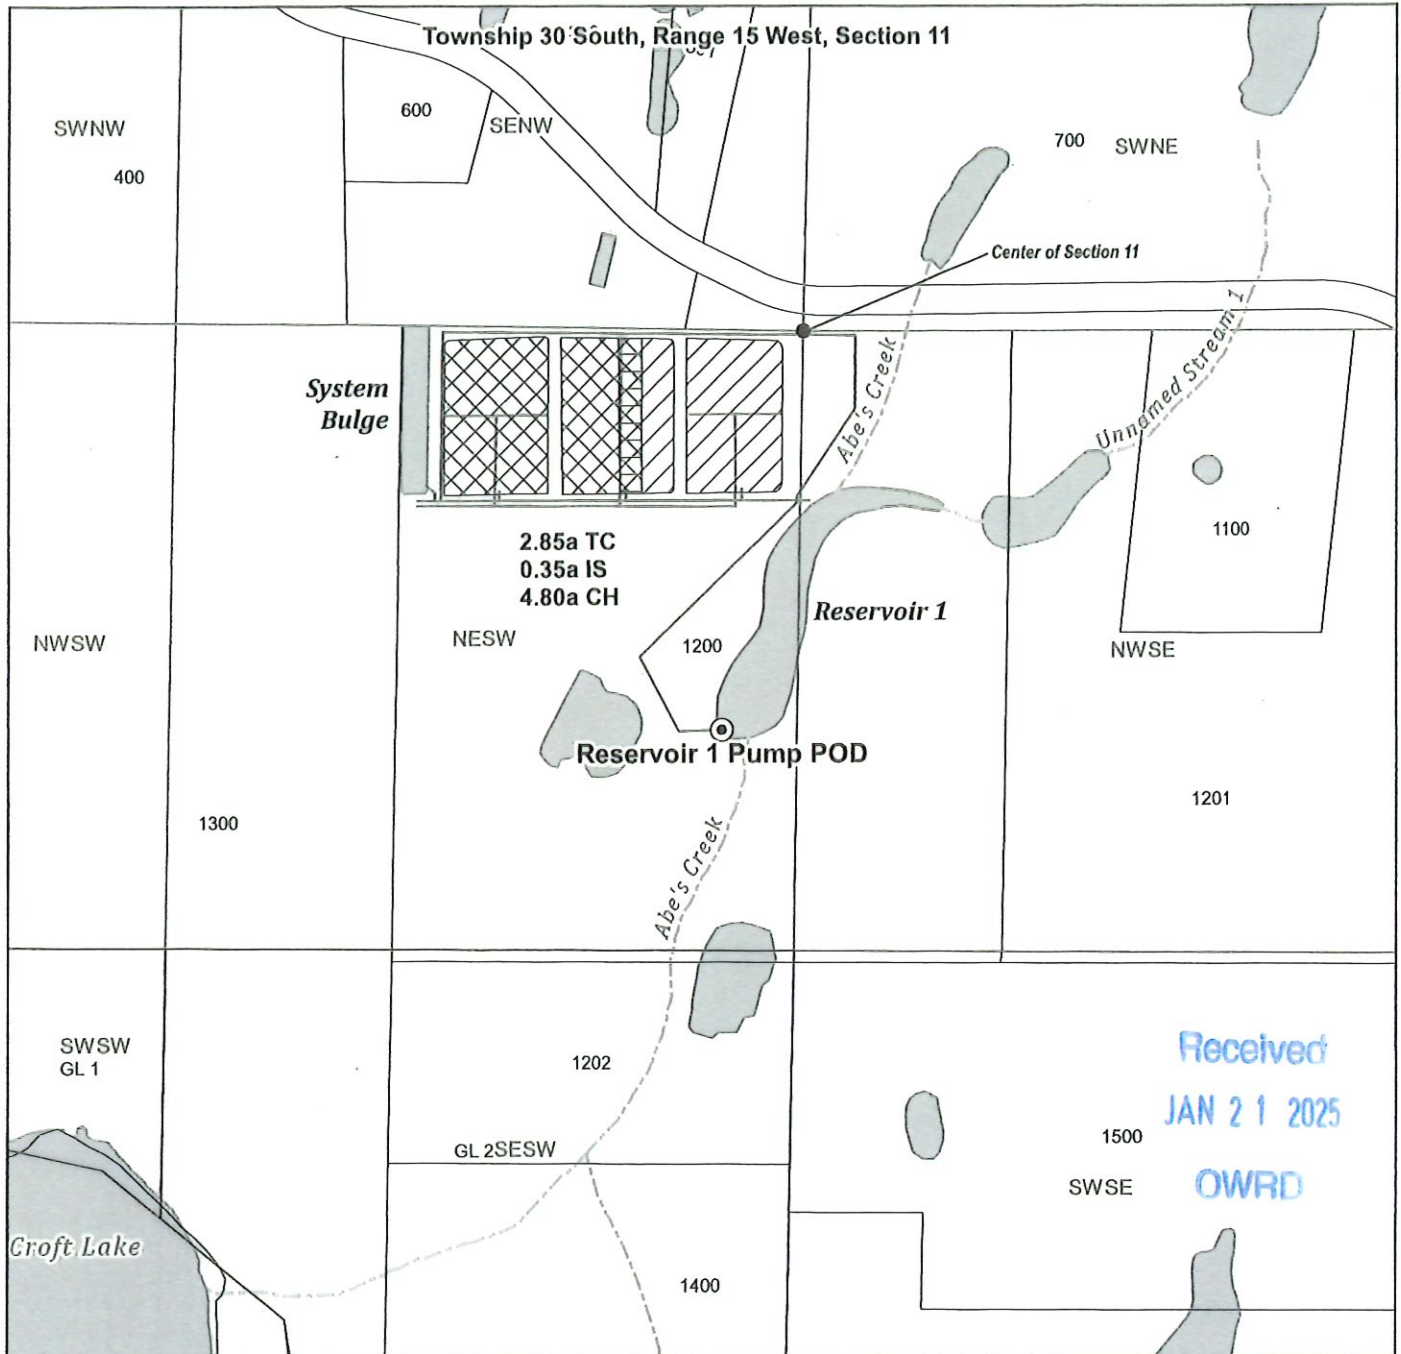


Received
JAN 21 2025
OWRD

LEGEND

- Tax lots
- Intermittent Watercourse
- Water Conveyance Mainlines
- Point of Diversion (POD)
- Place of Use (POU)**
 - Supplemental Irrigation (IR under Cert. 51557)
 - Temperature Control
 - Flood Harvest

POD Location Description

Reservoir 1 Pump POD
Located 820 feet South and 165 feet West from center of Section 11 (NESW), Township 30 South, Range 15 West, W.M.

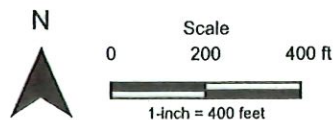

Date: 9/2/2024
Data Sources: BLM, OWRD, OGEO, USGS, Coos County.
Disclaimer: This map is not intended to provide legal dimensions or property ownership lines.

