


Claim of Beneficial Use

Permit R-8453, Application R-61485

A Water Right held by Daniel Arriola
Coos County

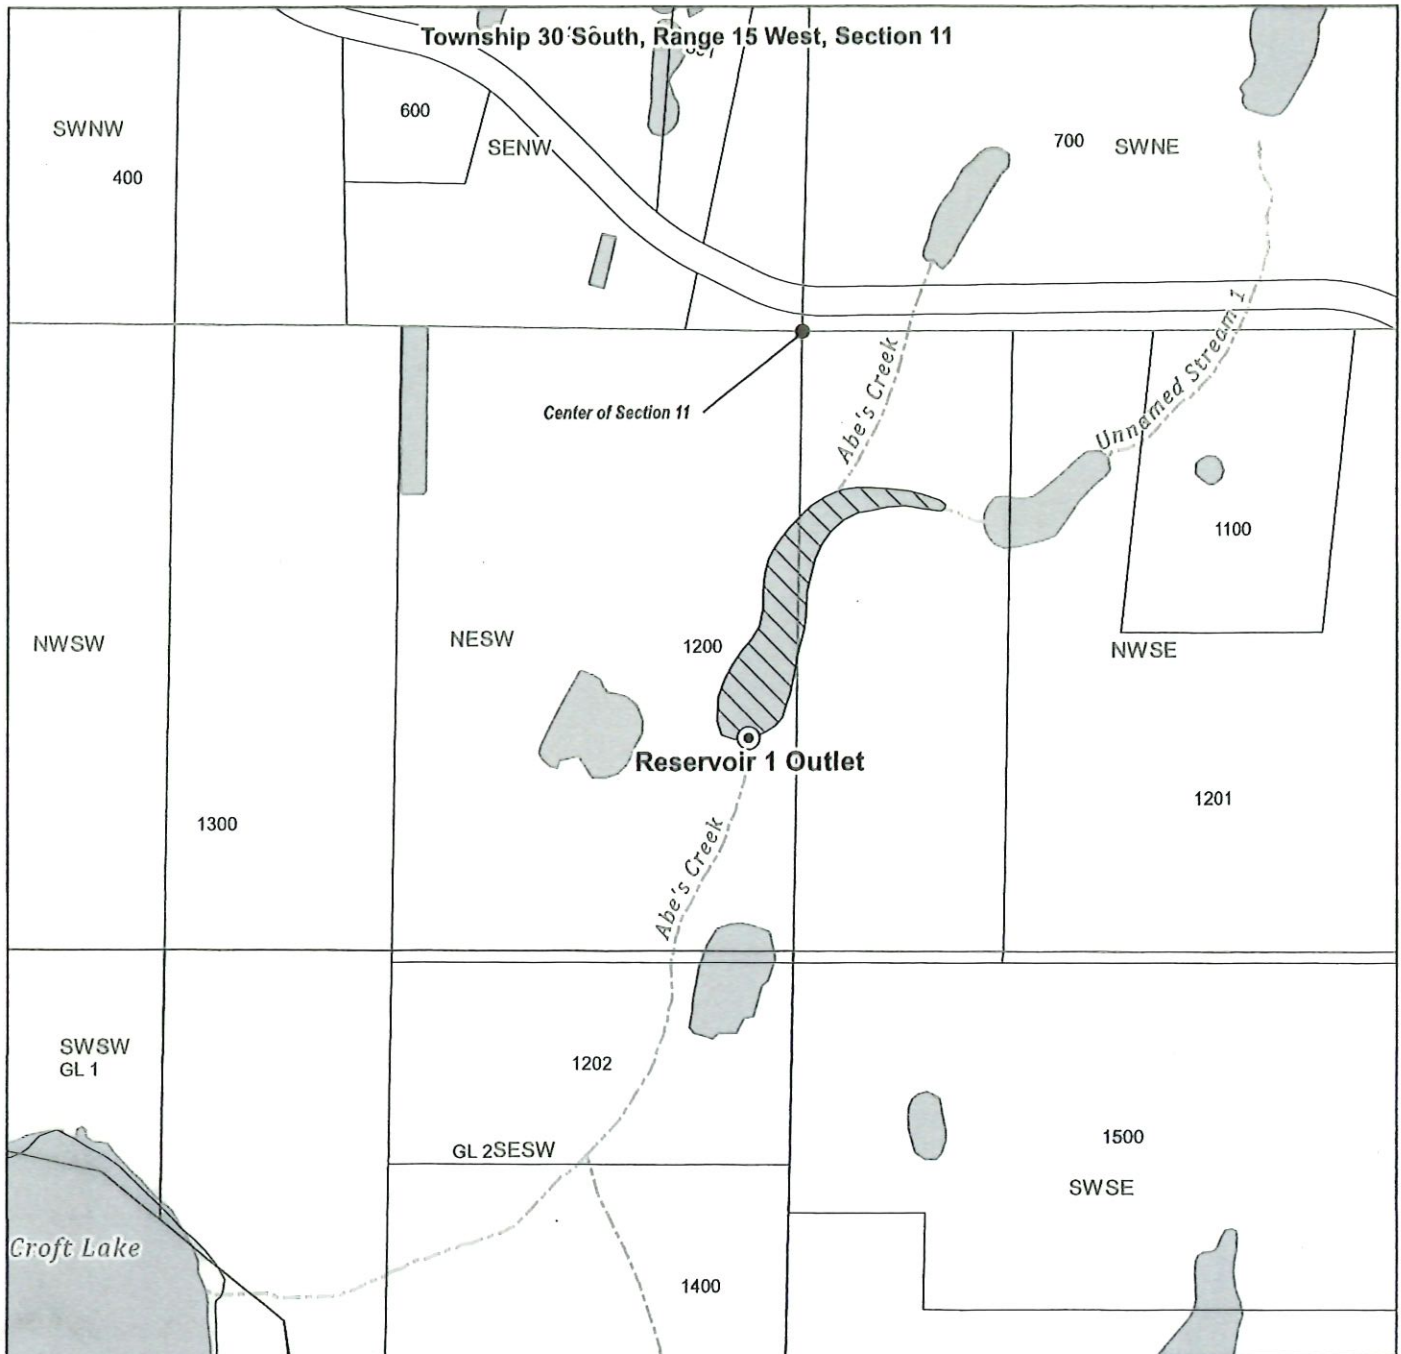

LEGEND



- Point of Diversion (POD)
- Place of Use (POU)
- Intermittent Watercourse
- Tax lots

POD Location Description

Dam Outlet
Located 840 feet South and 105 feet West from center of Section 11 (NESW), Township 30 South, Range 15 West, W.M.

Received
JAN 21 2025

OWRD

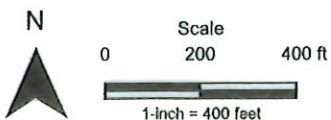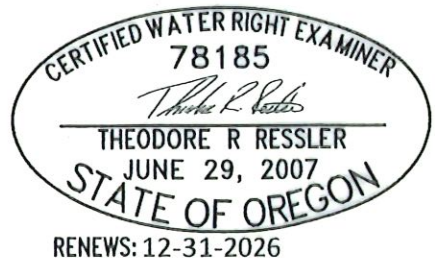

Date: 9/2/2024
Data Sources: BLM, OWRD, OGEO, USGS, Coos County.
Disclaimer: This map is not intended to provide legal dimensions or property ownership lines.

