


Southeast Quarter T39SR5W Sec24

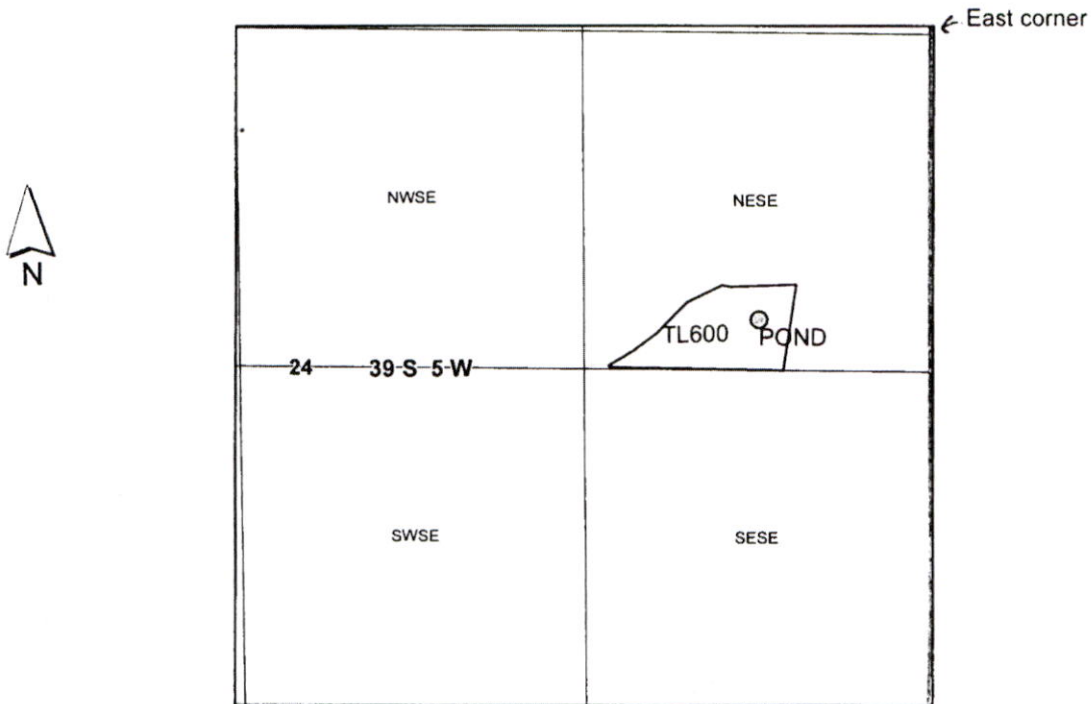

1 inch = 660 feet

Pond is 657 ft west and 1112 ft south of the east corner.

RECEIVED BY OWRD

OCT 25 2013

SALEM, OR

R87937

Received
MAY 19 2015
OWRD