


Claim of Beneficial Use - Jubitz

Application R-87708, Permit R-14939

Township 3S, Range 1E, Sec. 19, W.M.

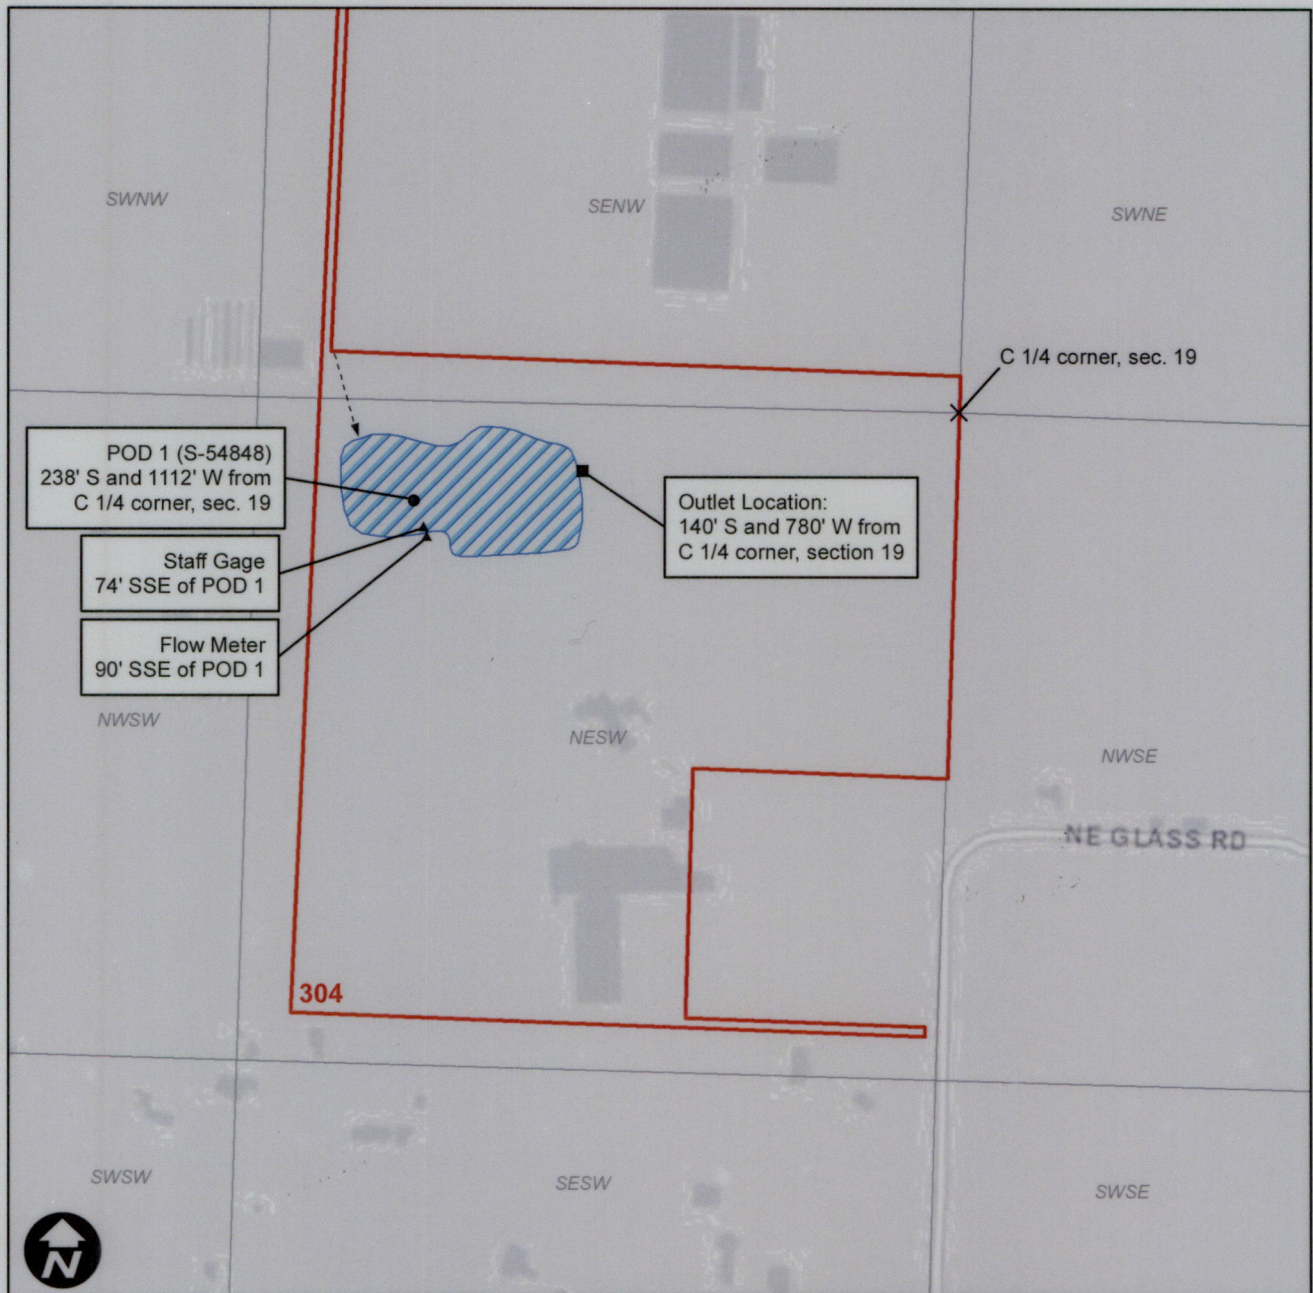

0 200 400 800 Feet

This map is not intended to provide legal dimensions or locations of property ownership lines.

Legend

-  French Hill Reservoir
-  Taxlot
-  Inlet Pipe



Received
DEC 23 2024

OWRD