


Township 5 North, Range 28 East, W.M.
NW1/4 SE1/4 of SECTION 36
UMATILLA COUNTY

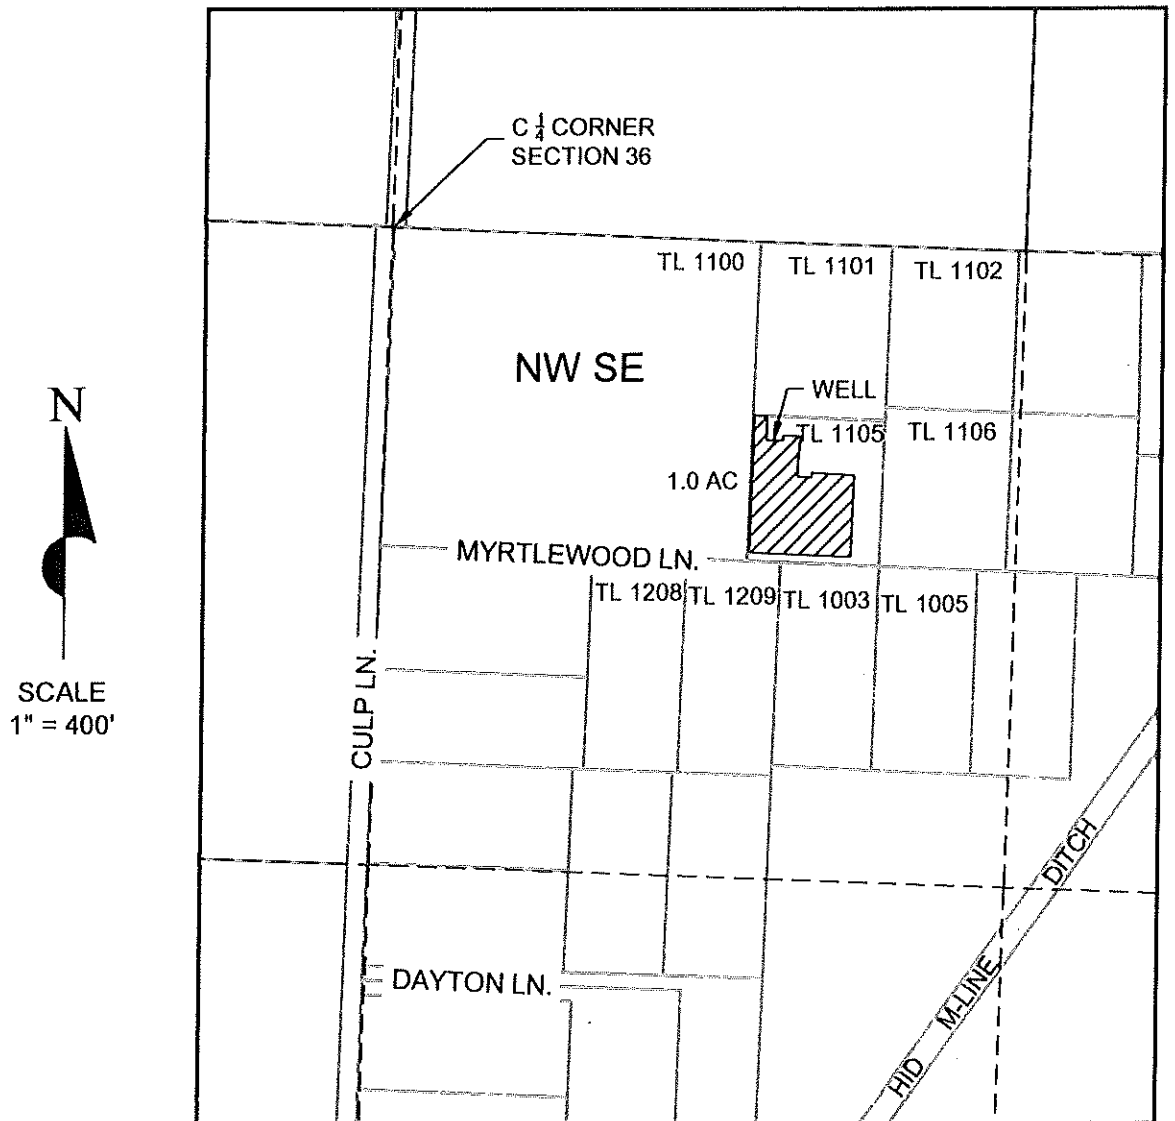


POA - WELL LOCATED 420' SOUTH & 810' EAST OF C 1/4 CORNER, SECTION 36.

LEGEND

----- Q-Q SECTION LINES


----- TAX LOTS

TL 1105 TAX LOT NUMBERS

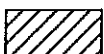

1.0 IRRIGATED ACRES.

COBU MAP
Application G-16094
Permit G-15937
in the names of
Fernado Benitez Diaz
& Lucia Garcia Urenda
September 25, 2020

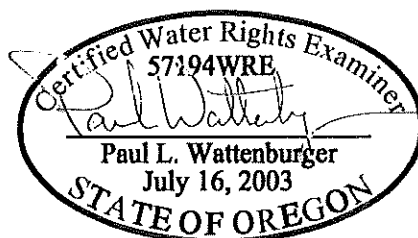

THIS MAP WAS PREPARED FOR THE PURPOSE OF IDENTIFYING THE LOCATION OF A WATER RIGHT ONLY AND IS NOT INTENDED TO PROVIDE LEGAL DIMENSIONS OR LOCATION OF PROPERTY OWNERSHIP LINES.

EXPIRES: 6/30/22