


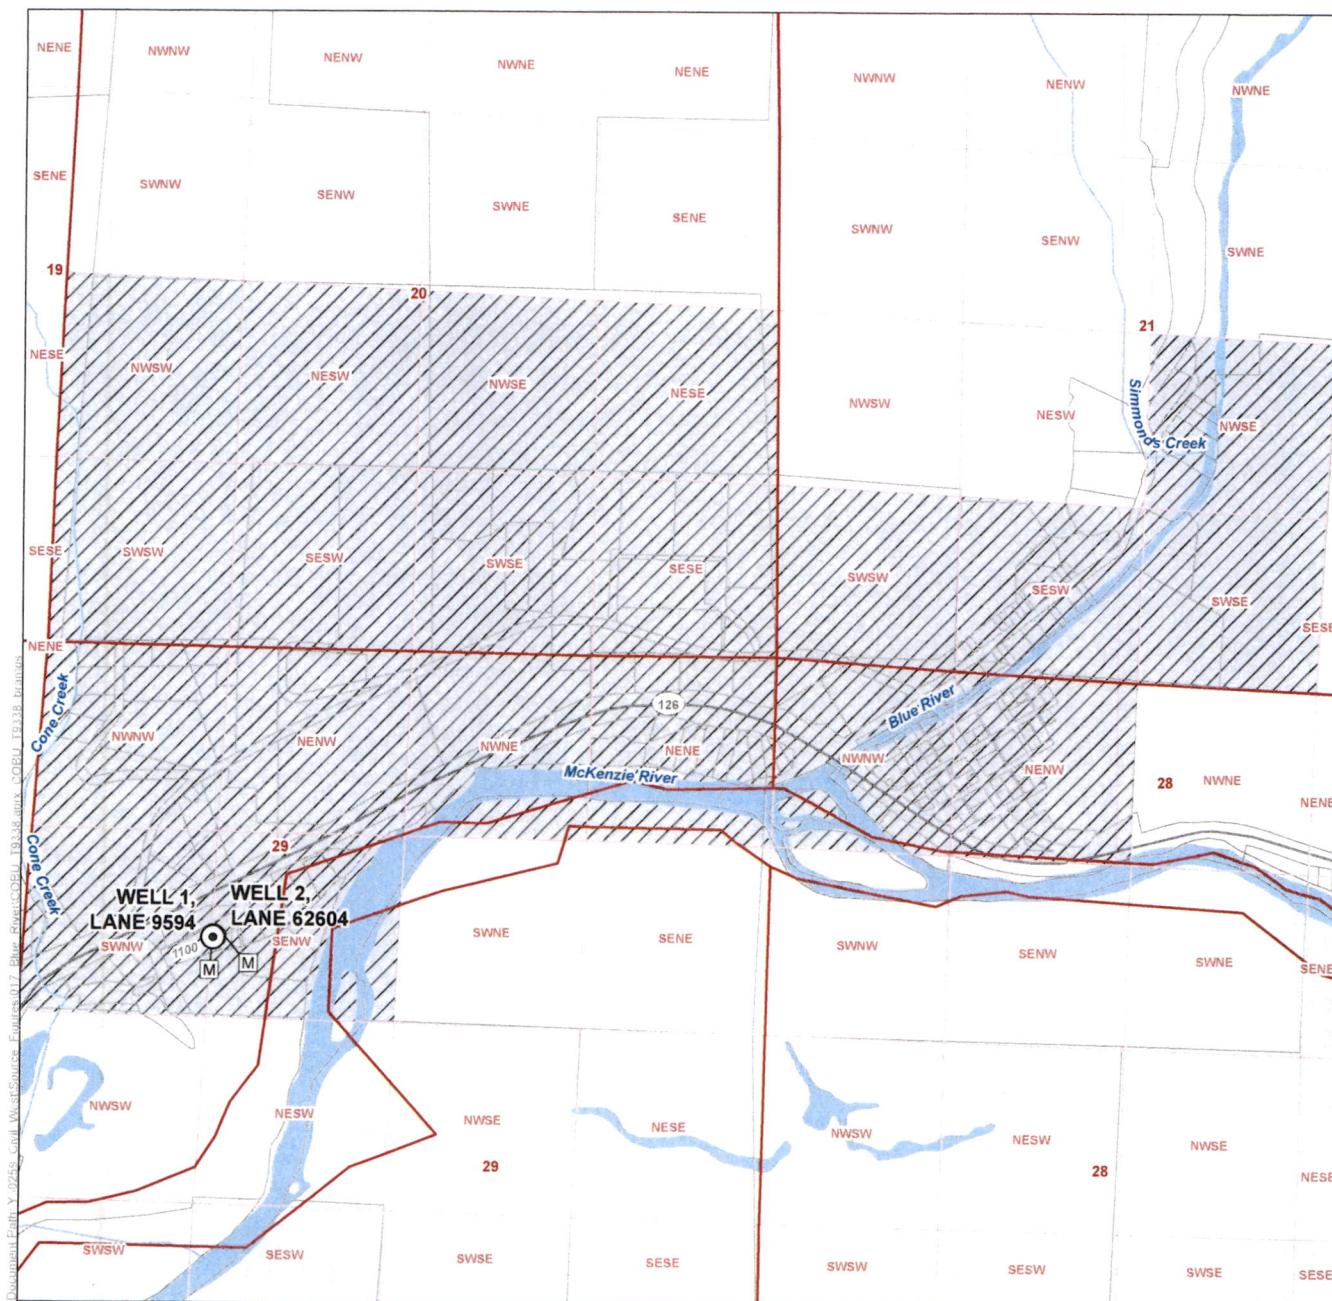

### LEGEND

-  Point of Appropriation (POA)
  Major Road
-  Meter
  Watercourse
-  Place of Use (POU)
  Waterbody

### All Other Features

- Tax Lot


**Claim of Beneficial Use Map  
Blue River Water District  
T-9338**

Lane County  
Township 16 South, Range 4 East (W.M.)

Received by OWRD

JAN 21 2025

**Salem, OR**

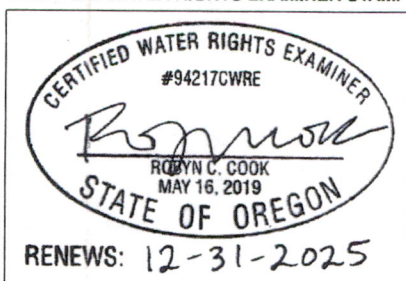

### LOCATION DESCRIPTION


Located 757 feet South and 38 feet West from the SW corner of  
NENW, of Section 29, Township 16 South, Range 4 East (W.M.)

Well 2, LANE 62604

Located 752 feet South and 30 feet West from the SW corner of NENW, of Section 29, Township 16 South, Range 4 East (W.M.)

## DISCLAIMER

**DISCLAIMER**  
This map was prepared for the purpose of identifying the location of a water right only and it is not intended to provide legal dimensions or location of property ownership lines.

Date: December 10, 2024

Date: December 10, 2024  
Data Sources: BLM, ESRI, OWRD, USGS

