


Section 25, T1S, R4W & Section 30, TS1, R3W., W.M.
Washington County, Oregon

CLAIM OF BENEFICIAL USE MAP FOR T-13695
Certificates 16900, 22091, 27473
Metro Regional Government

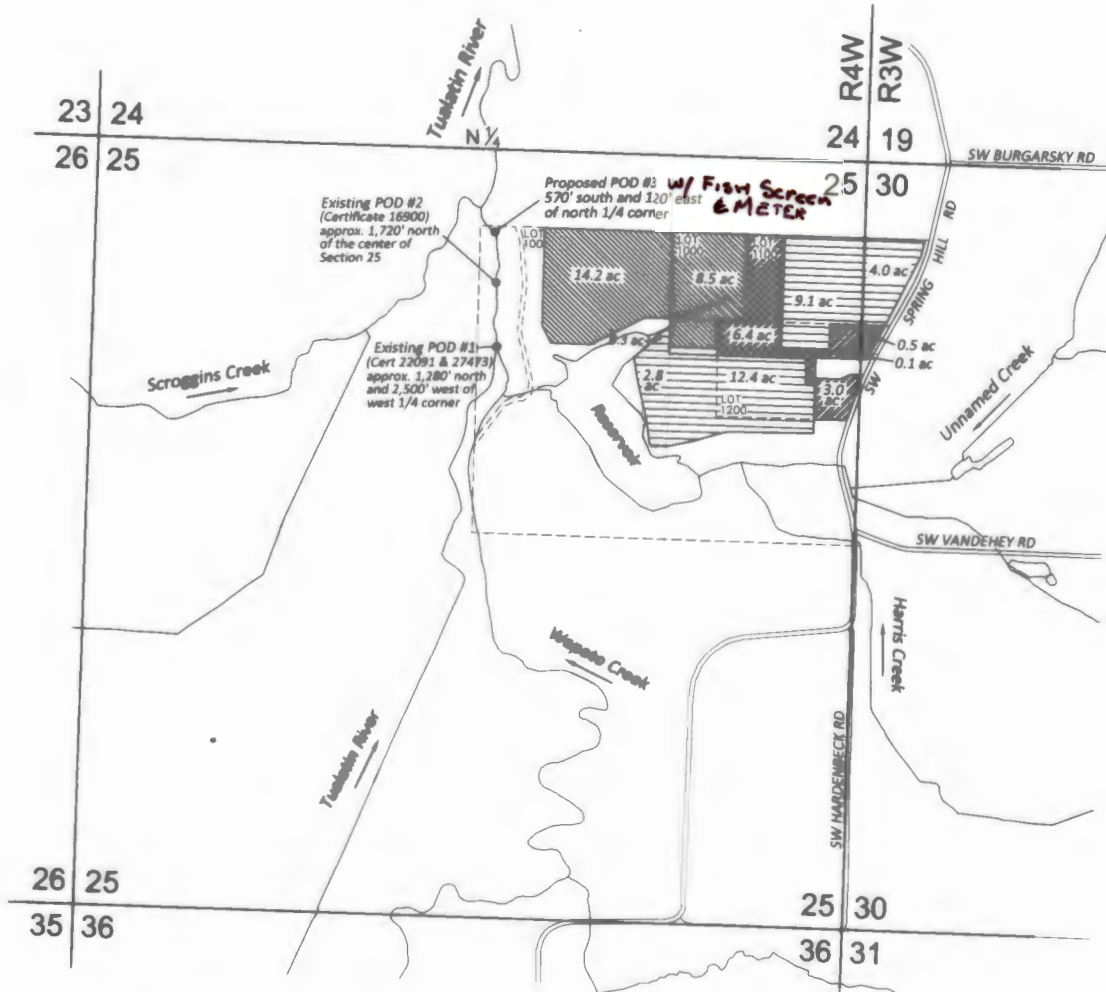

TRANSFER TO LANDS

CERTIFICATE 27473 - PRIORITY: 4/18/1956
PRIMARY IRRIGATION
10.0 acres

REMAINING LANDS

CERTIFICATE 16900 - PRIORITY: 12/15/1944
PRIMARY IRRIGATION
22.7 acres

CERTIFICATE 22091 - PRIORITY: 2/8/1953
PRIMARY IRRIGATION
28.6 acres

Received


SEP 23 2024

OWRD


This map is not intended to provide legal
dimensions of locations of property
ownership lines.



4014 SE Ankeny Street • Portland, Oregon 97214
ph: 503-956-3473 • adam@zuckerengineering.com

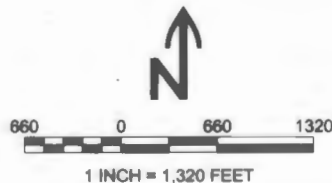


September 2024

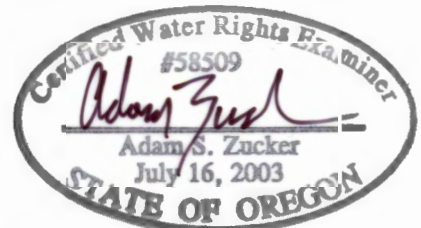

Expiration Date: 6-30-26

T. 1 S. R. 4 W. W. M.

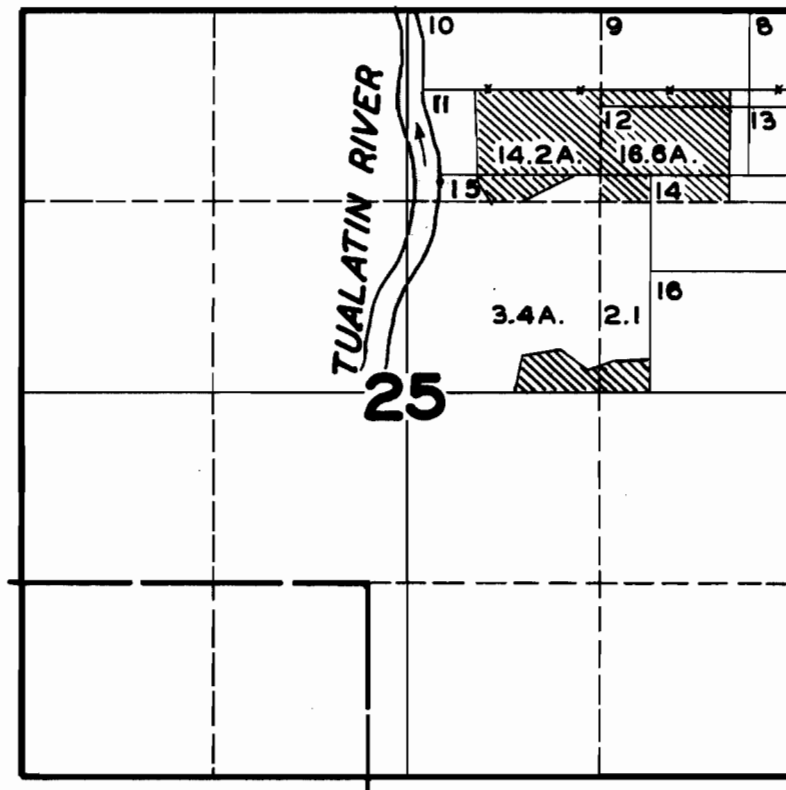

FINAL PROOF SURVEY
UNDER

Application No. 20607 Permit No. 16100
IN NAME OF

C.B. BUCHANAN, JR.

Surveyed MAY 18 1948, by JAS. E. BUNNELL