


Section 25, T1S, R4W & Section 30, TS1, R3W., W.M.
Washington County, Oregon

CLAIM OF BENEFICIAL USE MAP FOR T-13695
Certificates 16900, 22091, 27473
Metro Regional Government

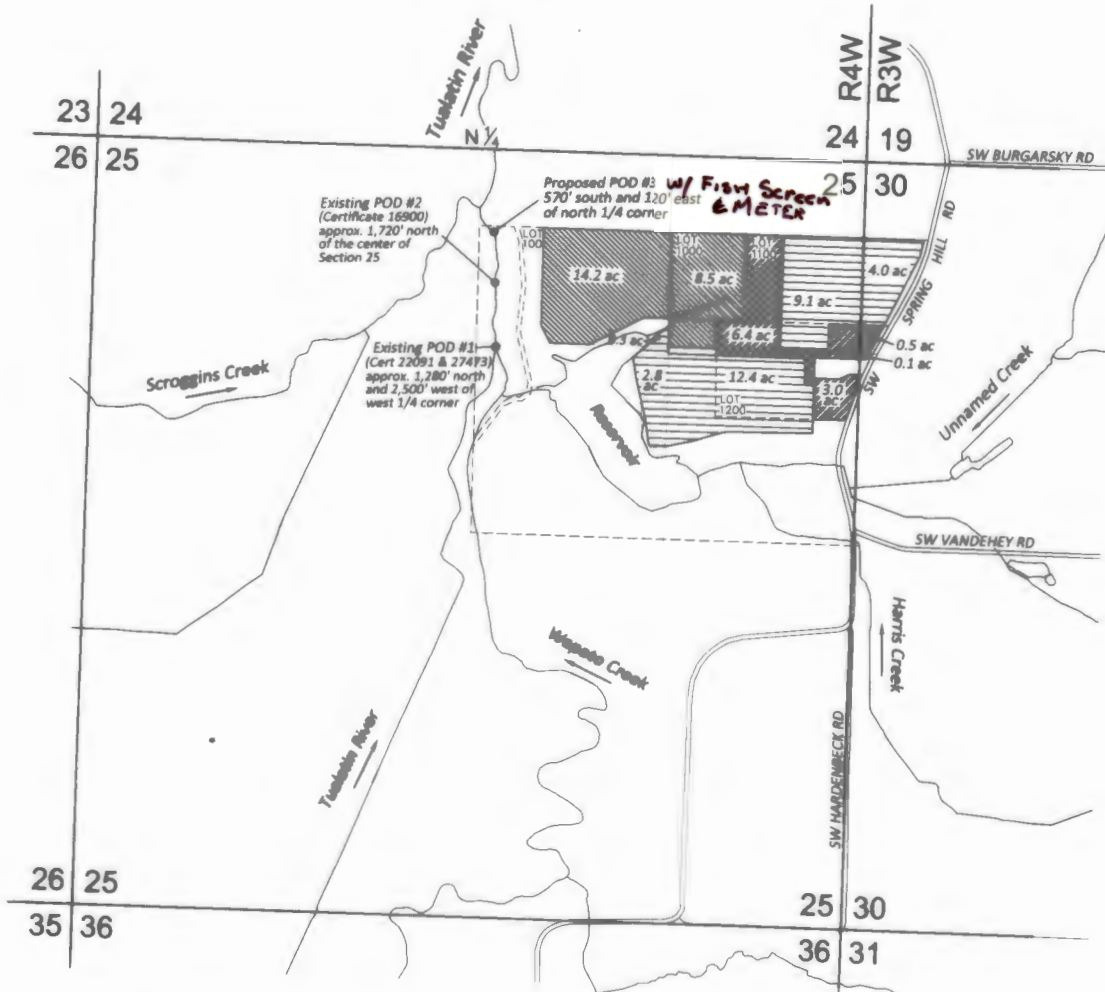

TRANSFER TO LANDS



CERTIFICATE 27473 - PRIORITY: 4/18/1956
PRIMARY IRRIGATION
10.0 acres

REMAINING LANDS



CERTIFICATE 16900 - PRIORITY: 12/15/1944
PRIMARY IRRIGATION
22.7 acres



CERTIFICATE 22091 - PRIORITY: 2/8/1953
PRIMARY IRRIGATION
28.6 acres

Received

SEP 23 2024


OWRD

This map is not intended to provide legal
dimensions of locations of property
ownership lines.




ZUCKER
engineering & design

4014 SE Ankeny Street • Portland, Oregon 97214
ph: 503-956-3473 • adam@zuckerengineering.com

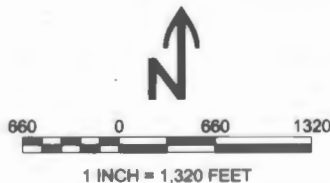

September 2024

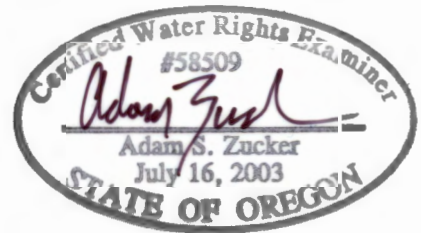

Expiration Date: 6-30-26