


T.6S. R.2W. Sec. 24 & 25, W.M.

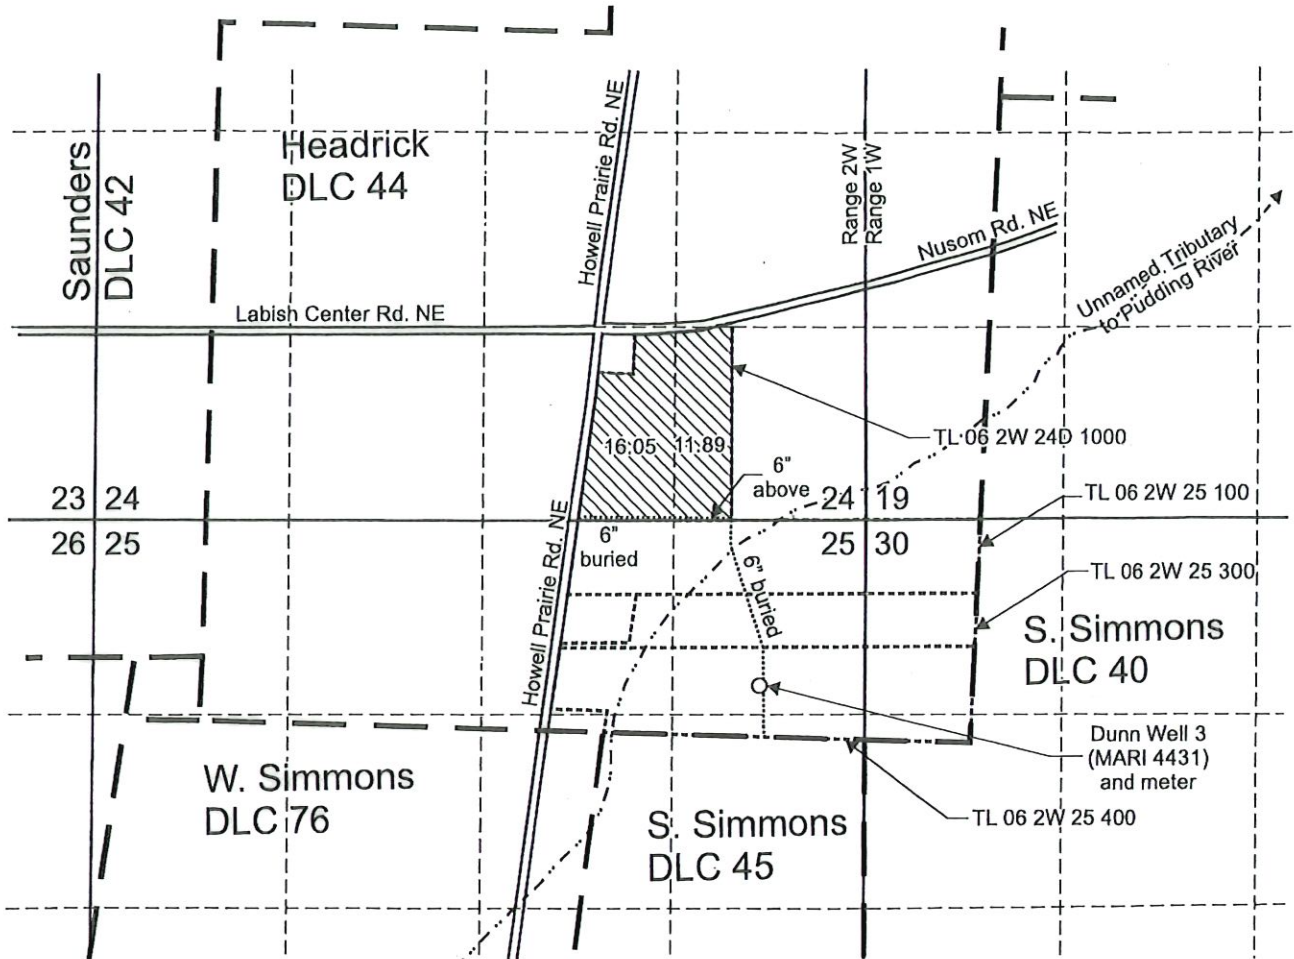

Dunn Well 3 (MARI 4431) is located 1,120 feet south and 720 feet west from the NE corner, Section 25.

Area (27.94 Acres) irrigated under Application G-16739, Permit G-16635.

Tax lot boundary

Donation Land Claim boundary

Water main line



EXPIRES: June 30, 2013

Scale: 1" = 1,320'



This map was prepared for the purpose of identifying the location of a water right only and is not intended to provide legal dimensions or location of property ownership lines.

Claim of Beneficial Use Map
Application G-16739, Permit G-16635

Pacific Hydro-Geology Inc.

01/2022

Ditchen Land Co. LLC
T.6S. R.2W. Sec. 24 & 25, W.M.