

MAP TO ACCOMPANY
WATER RIGHT TRANSFER
FOR
MICHAEL & HEIDI HANSON

SECTION 30, T26S R16E W.M.

SECTION 5, T27S R16E W.M.

LAKE COUNTY, OREGON


LEGEND

SECTION LINE

1/4 SECTION LINE

1/16 SECTION LINE


TRANSFER NO. T-

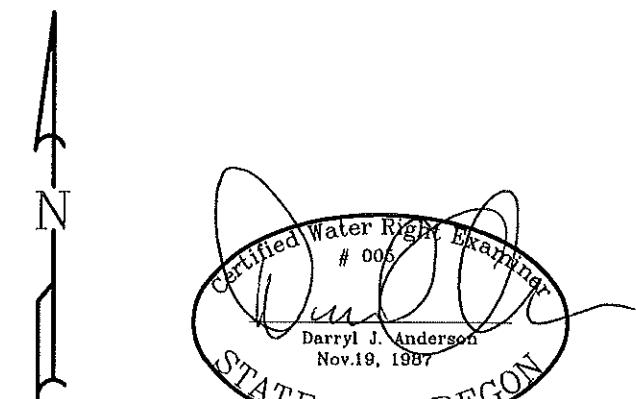


SCALE: 1"=1320'

RENEWAL 12/31/23

NOTE:
PREPARATION OF THIS MAP IS FOR IDENTIFYING WATER RIGHTS ONLY. IT
HAS NO INTENT TO PROVIDE LOCATIONS OR DIMENSIONS OF PROPERTY
BOUNDARIES.

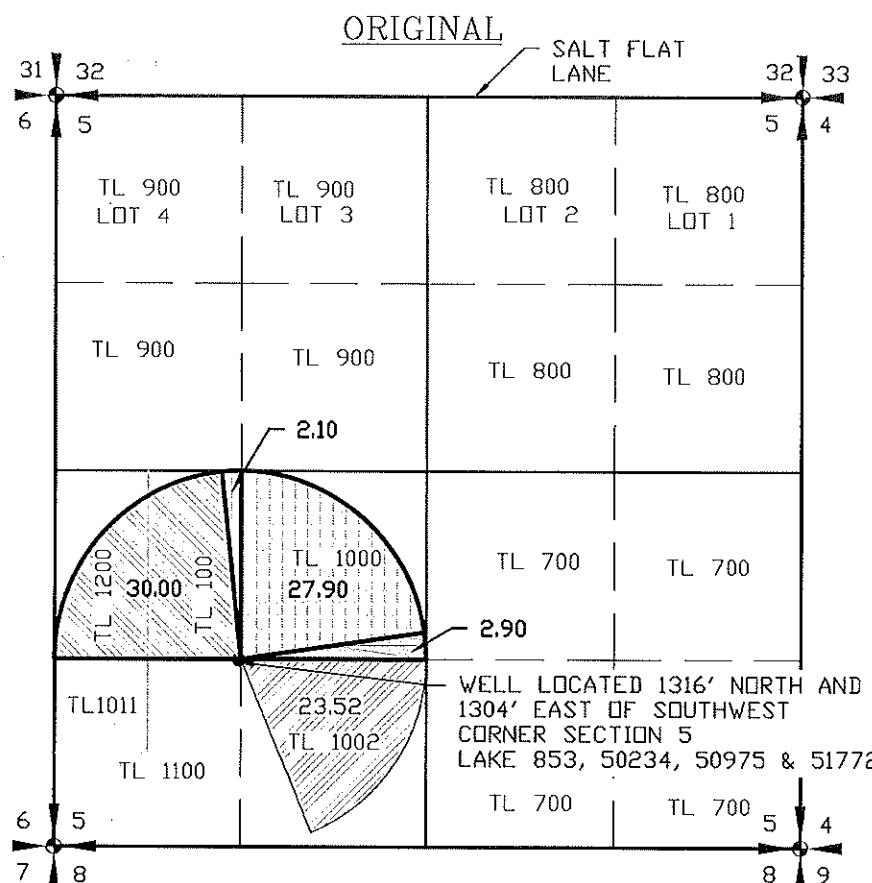

- PLACE OF USE CERTIFICATE 88736
TO TRANSFER - 2.90 ACRES
- PLACE OF USE CERTIFICATE 88736
TO REMAIN - 23.52 ACRES
- PLACE OF USE CERTIFICATE 88673
TO TRANSFER - 30.00 ACRES
- PLACE OF USE CERTIFICATE 88622
TO TRANSFER - 30.00 ACRES

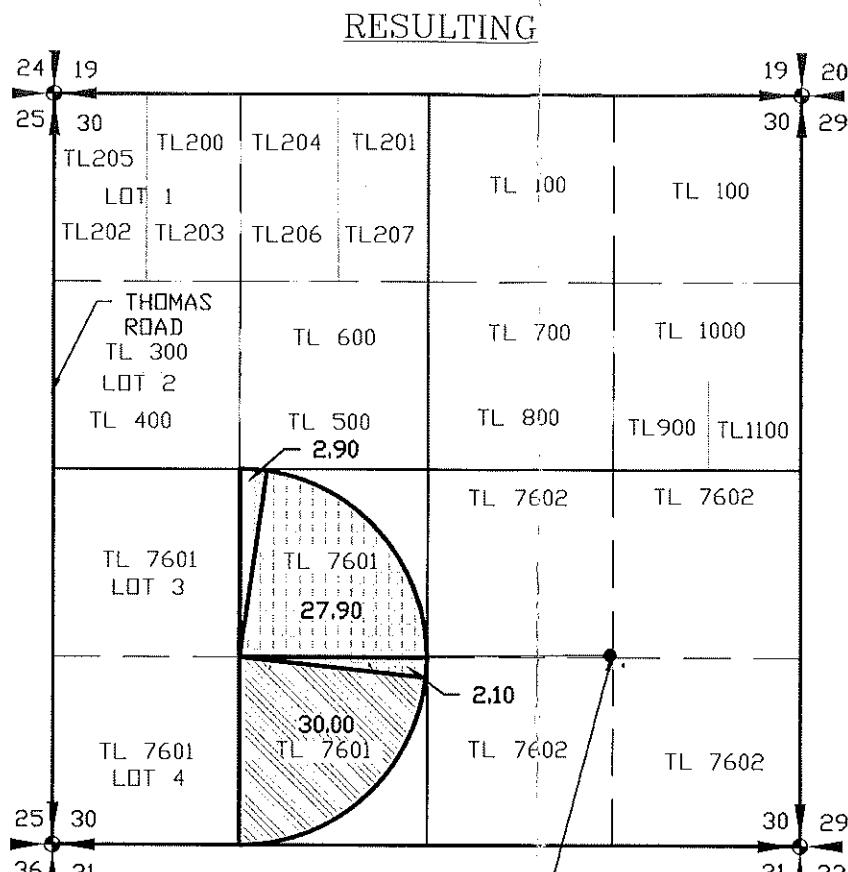

- PLACE OF USE CERTIFICATE 88736
PROPOSED - 2.90 ACRES
- PLACE OF USE CERTIFICATE 88673
PROPOSED - 30.00 ACRES
- PLACE OF USE CERTIFICATE 88622
PROPOSED - 30.00 ACRES

REVISION	BY

ANDERSON ENGINEERING
AND SURVEYING, INC.
P.O. BOX 28
LAKEVIEW, OREGON 97630
(541) 947-4407/FAX: 947-2321
WWW.ANDERSONENGINEERING.COM

FOR:
MICHAEL & HEIDI HANSON
P.O. BOX 130
FORT ROCK, OR 97621

MAP TO ACCOMPANY WATER
RIGHT TRANSFER
SEC. 30, T26S, R16E W.M.

DATE: 10/31/2023
SCALE: 1" = 1320'
DWG. BY: R.C.
JOB: 2023-054
FILE: 2023-054
SHEET: 1 OF 1

RECEIVED RECEIVED

FEB 20 2024 JAN 23 2024

OWRD OWRD

CLAIM OF BENEFICIAL USE MAP FOR T-9375

LOCATED WITHIN THE SW1/4 OF SECTION 5
TOWNSHIP 27 SOUTH, RANGE 16 EAST, W.M.,
LAKE COUNTY, OREGON

FOR
CORNELL BROTHERS INC.

LEGEND

- LAND SURVEY MONUMENT
FOUND AS NOTED.
- EXISTING WELL
- ▨ 26.42 ACRES BEING IRRIGATED
AS SHOWN AS PER T-9375.
- ▨ 7.68 ACRES BEING IRRIGATED
AS SHOWN AS PER T-9375.

WELL LOCATION


- WELL IS LOCATED IN THE SW1/4SW1/4 OF
SECTION 5.
WELL IS LOCATED 1316 FEET NORTH AND
1304 FEET EAST FROM THE SOUTHWEST CORNER
OF SECTION 5,
TOWNSHIP 27 SOUTH, RANGE 16 EAST, W.M.,
LAKE COUNTY, OREGON.



SCALE 1"=1320'



1320 FEET | 1320 FEET

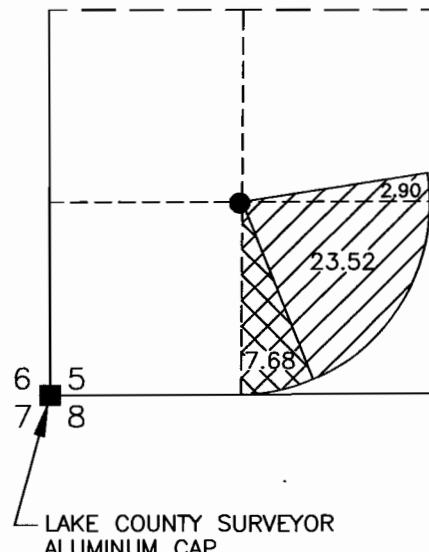


RECEIVED

SEP 18 2006

WATER RESOURCES DEPT
SALEM, OREGON

TAX LOTS

TAX LOT 27-16-1000
TAX LOT 27-16-1002

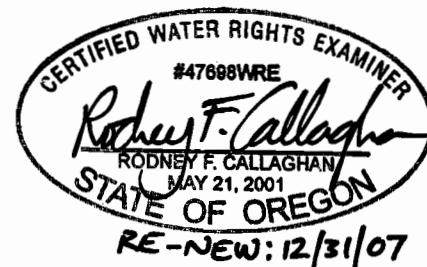

THIS MAP IS FOR THE PURPOSE OF LOCATING
A WATER RIGHT ONLY AND HAS NO INTENT TO
PROVIDE LEGAL DIMENSIONS OR THE LOCATION
OF BOUNDARY LINES.

PREPARED FOR: CORNELL BROTHERS INC.
C/O PAT CORNELL
P.O. BOX 533
CHRISTMAS VALLEY, OR 97601

PREPARED BY:
CALLAGHAN LAND SURVEYING
427 SOUTH H STREET
LAKEVIEW, OR 97630
(541) 947-5841

CLS

DATE: 9/12/2006 DRAWING: 200547