

Received by OWRD

JUL 25 2024

Salem, OR


T. 32 S., R. 5 W., W.M.

SCALE: 1" = 400'

THE PURPOSE OF THIS MAP IS TO IDENTIFY THE
LOCATION OF THE WATER RIGHT. IT IS NOT INTENDED TO
PROVIDE INFORMATION RELATIVE TO THE LOCATION OF
PROPERTY OWNERSHIP BOUNDARY LINES.



POD IS LOCATED 629 FEET WEST
AND 45 FEET SOUTH OF THE
EAST QUARTER CORNER

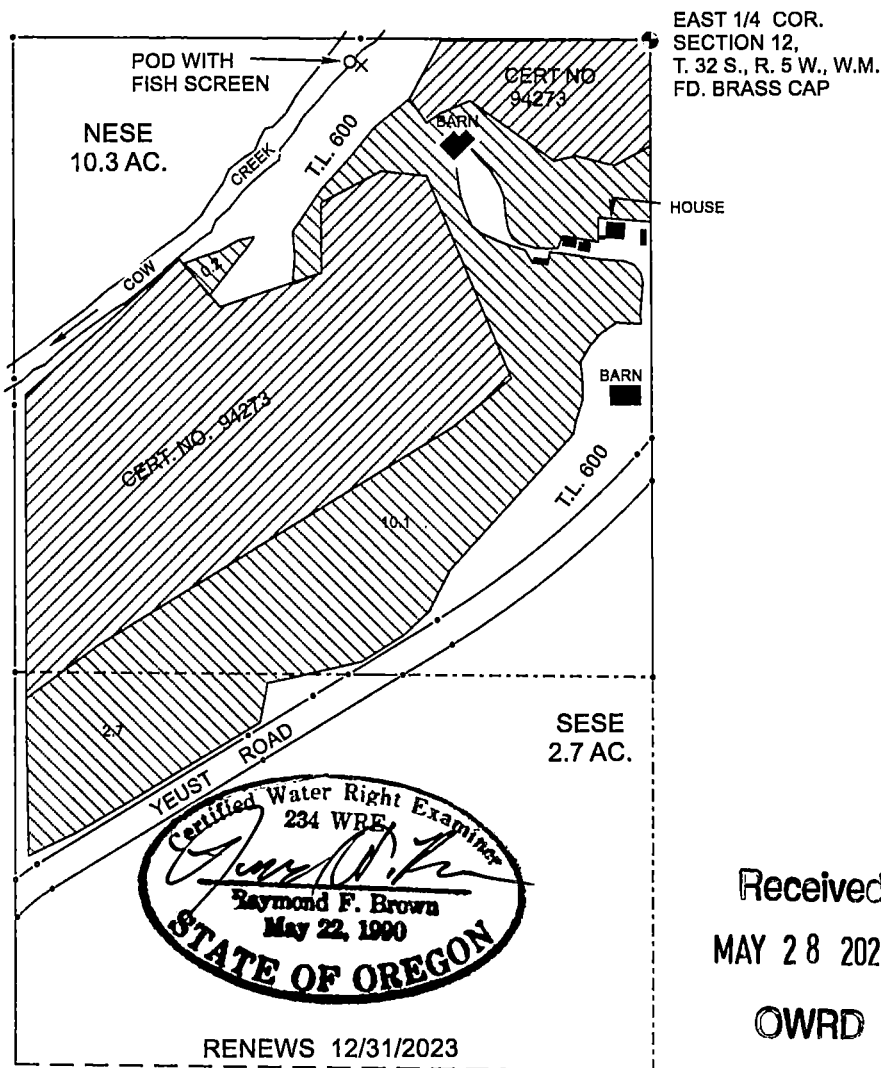

LEGEND

- COMPUTED POINT
- P.O.D.W/ FISH SCREEN
- × PUMP W/METER
- GOVN. CORNER
- ▨ CERT. 94273
- ▨ PERMIT S-55217
- STRUCTURES
- 40 LINE

FINAL PROOF SURVEY

UNDER

Application No. S-88671

Permit No. S-55217

IN NAME OF

ROGER MCMUNN

Surveyed Sept. 12, 2023

by R.F. BROWN