


SW1/4SW1/4 of Section 5, Township 29 South, Range 14 West, W.M.

APPLICATION: R-72130
APPLICATION: S-72131

PERMIT: R-11625
PERMIT: S-51905

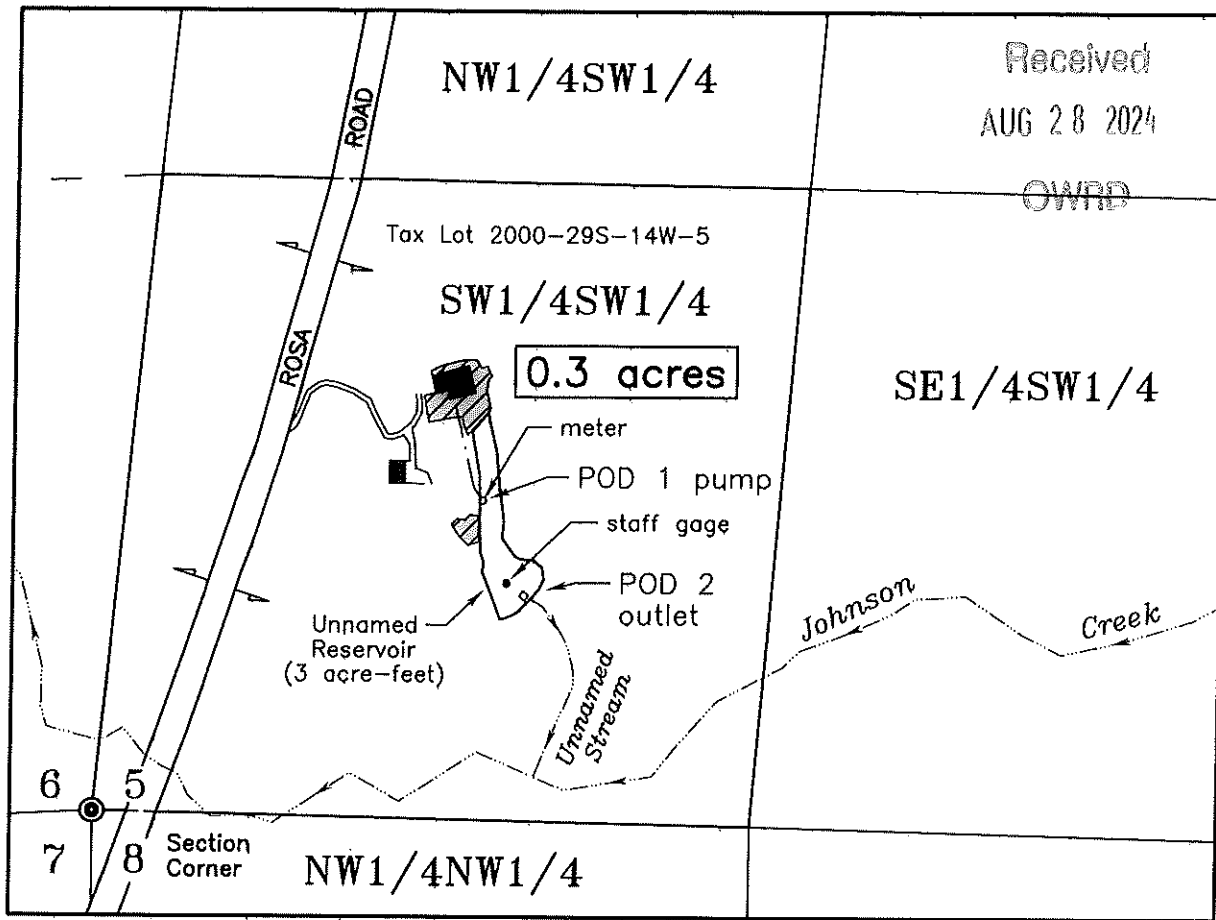

LEGEND:



Place of Use: 0.3 Acres

POD Point of Diversion

POD 1: 645 feet north and 805 feet east of the SW Corner of Section 5

POD 2: Dam outlet, 445 feet north and 900 feet east of the SW Corner of Section 5

This map is not intended to provide legal dimensions or locations of property ownership lines.

gent COBU.dwg


PROJECT NO.
1435-24-877

DRAWING NO.
234-8.5.11

DATE:
July 29, 2024

SCALE:
1" = 400'

SHEET NO.
1 of 1

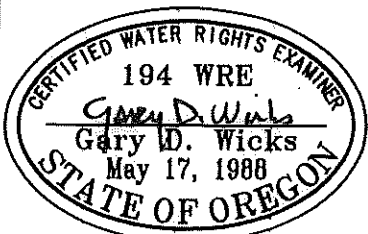

RENEWAL DATE: 6-30-28

PLAT FOR CLAIM OF BENEFICIAL USE

LOCATED IN:

SW1/4SW1/4 of Section 5,
Township 29 South, Range 14 West, W.M.
Coos County, Oregon

PREPARED FOR:
STEVE GANT
P.O. Box 1587
Bandon, OR 97411

Tel: 541-404-3113

PREPARED BY:
WICKS ENGINEERING & SURVEYING
311 N.E. "D" Street
Grants Pass, OR 97526

Tel: 541-479-3436