


SW1/4SW1/4 of Section 5, Township 29 South, Range 14 West, W.M.

APPLICATION: R-72130  
APPLICATION: S-72131

PERMIT: R-11625  
PERMIT: S-51905

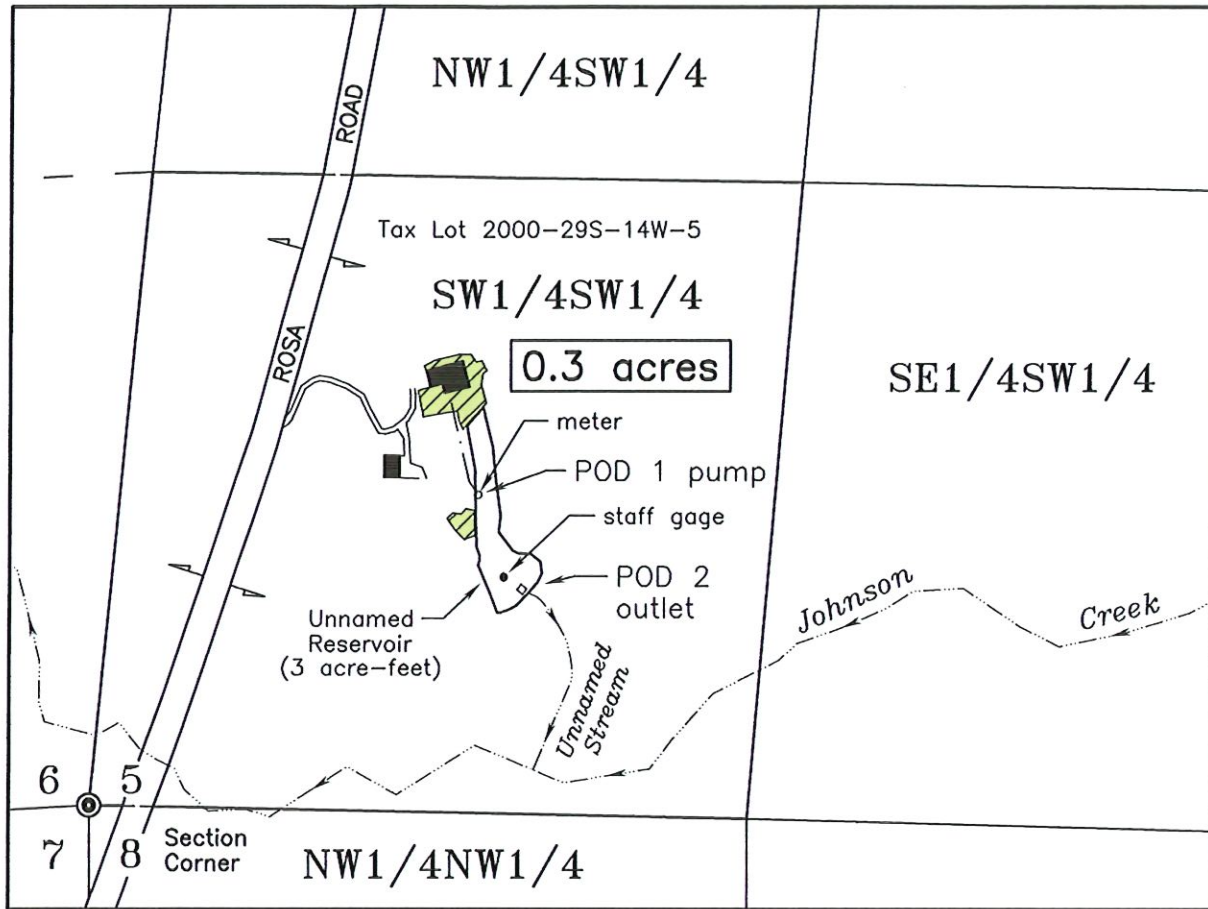

**LEGEND:**



Place of Use: 0.3 Acres

POD Point of Diversion

POD 1: 645 feet north and 805 feet east of the SW Corner of Section 5

POD 2: Dam outlet, 445 feet north and 900 feet east of the SW Corner of Section 5

Received

AUG 28 2024

OWRD

This map is not intended to provide legal dimensions or locations of property ownership lines.

gant COBU.dwg


PROJECT NO.  
1435-24-877

DRAWING NO.  
234-8.5.11

DATE:  
July 29, 2024

SCALE:  
1" = 400'

SHEET NO.  
1 of 1

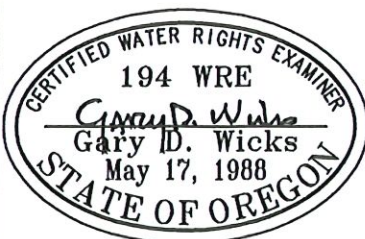

RENEWAL DATE: 6-30-26

**PLAT FOR CLAIM OF BENEFICIAL USE**

LOCATED IN:

SW1/4SW1/4 of Section 5,  
Township 29 South, Range 14 West, W.M.  
Coos County, Oregon

PREPARED FOR:  
STEVE GANT  
P.O. Box 1587  
Bandon, OR 97411

Tel: 541-404-3113

PREPARED BY:  
WICKS ENGINEERING & SURVEYING  
311 N.E. "D" Street  
Grants Pass, OR 97526

Tel: 541-479-3436