


SW NE	SE NE	SW NW	SE NW
NW SE	NE SE TL 100	NW SW	NE SW
SW SE	SE SE 32 33	SW SW	SE SW
NW NE	NE NE 5 4	NW NW	NE NW

QUARTER-QUARTER SECTION GUIDE

NTS

T6S, R5W, WM

POLK COUNTY

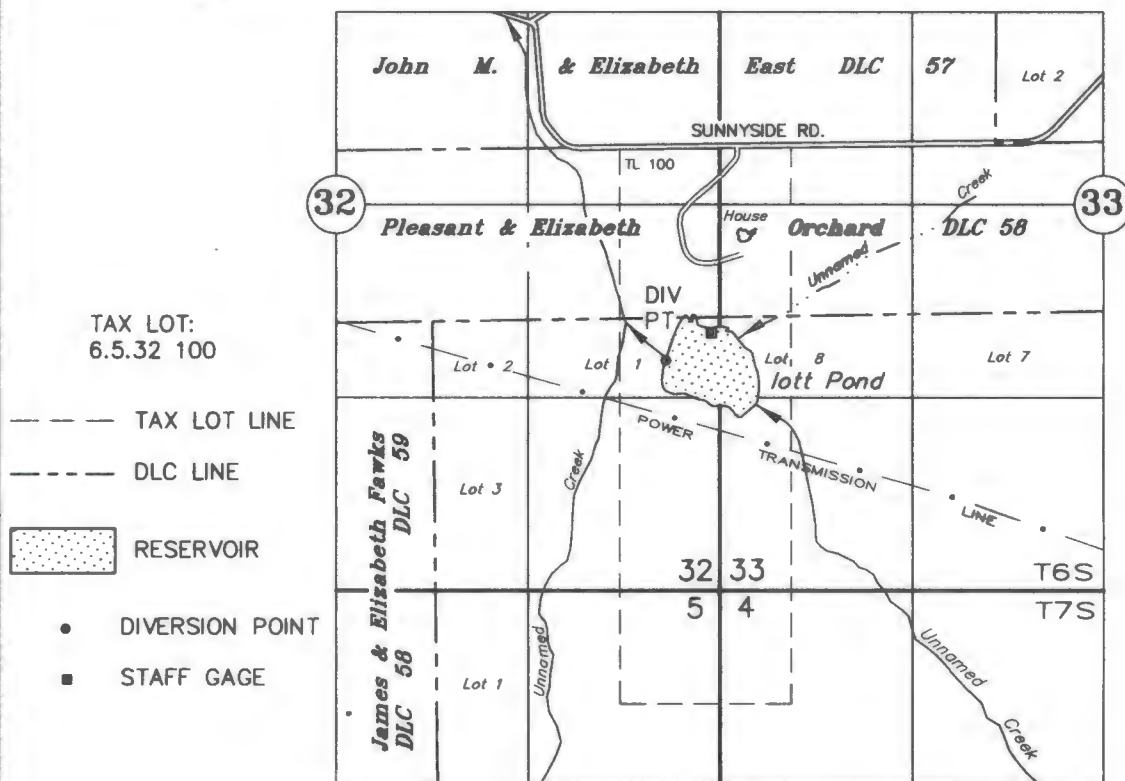

DIV PT: 1475' S AND 2265' W OF THE SE CORNER OF THE EAST DLC 57
STAFF GAGE: 1255' S AND 1950' W OF THE SE CORNER OF THE EAST DLC 57

CLAIM OF BENEFICIAL USE

UNDER

Application No. R-85749

Permit No. R-14029

Salem, OR

IN THE NAME OF

Gwenn Iott


September 16, 2023

SCALE: 1" = 1320'

NOTE: This map is for the purpose of identifying the location of water rights and has no intent to dimension or locate property ownership lines.

Received by OWRD

NOV 08 2024

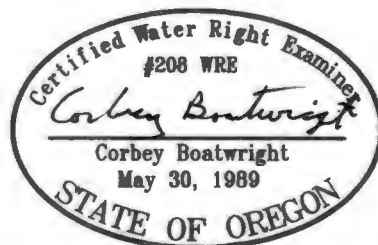

EXPIRES 12-31-2025