

NE NW	NW NE	NE NE	1 6 NW NW
SE NW	SW NE	SE NE	SW NW
NE SW	NW SE	NE SE	NW SW
SE SW	SW SE	SE SE	SW SW

QUARTER-QUARTER SECTION GUIDE


NTS

T6S R4W, WM
T6S R5W, WM
YAMHILL COUNTY

Received

Salem, OR

TAX LOTS:
6.5.01 100
300

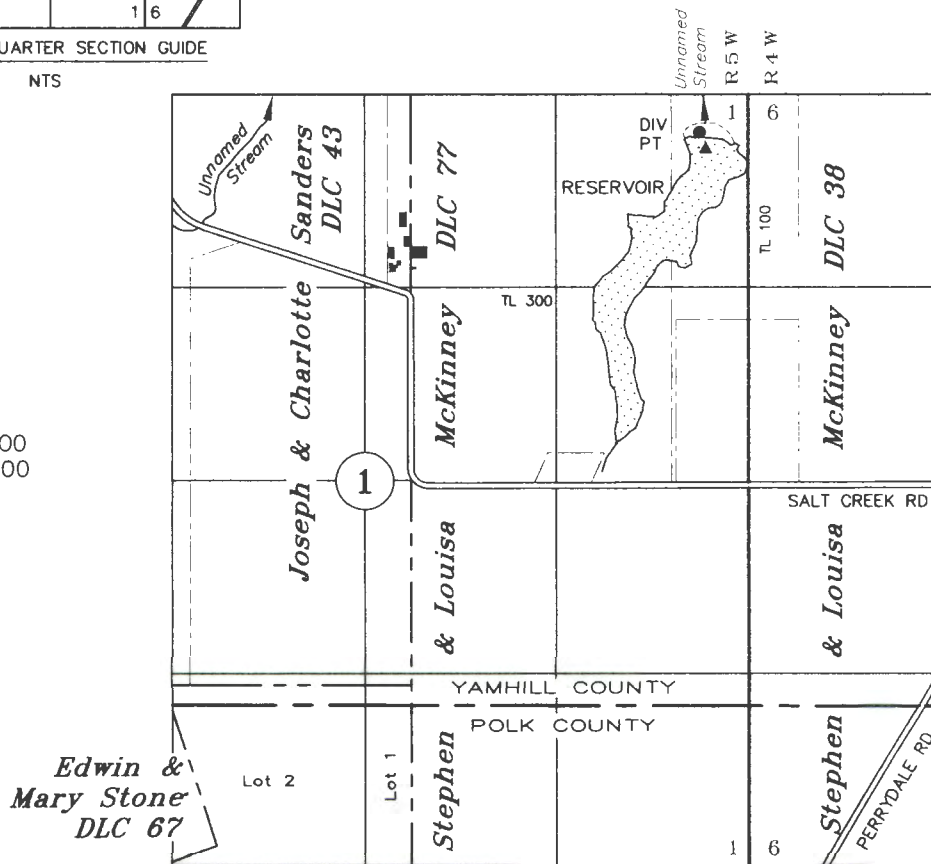

- DIV PT
- ▲ STAFF GAGE
- HOME & FARM BUILDINGS

----- TAX LOT LINE

DIV PT: 257' S AND 325' W OF THE NE CORNER SEC 1
STAFF GAGE: AT DIVERSION POINT, INSIDE 60" MH

CLAIM OF BENEFICIAL USE


Application No. R-86226 Permit No. R-14320

Bruce & Helle Ruddenklau
NW Farm Credit Services

December 10, 2019

SCALE: 1" = 1320'

NOTE: This map is for the purpose of identifying the location of water rights and has no intent to dimension or locate property ownership lines.

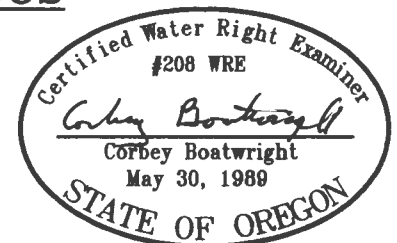

Renews: December 31, 2025