


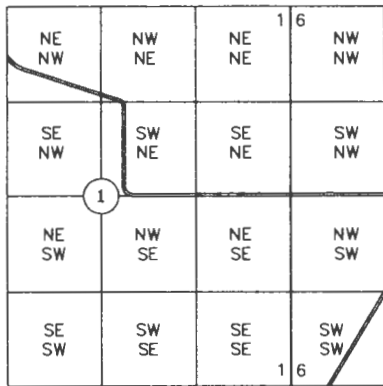

QUARTER-QUARTER SECTION GUIDE


NTS

T6S R4W, WM
T6S R5W, WM

YAMHILL COUNTY

TAX LOTS:

6.5.01 100
200
300
600
1200

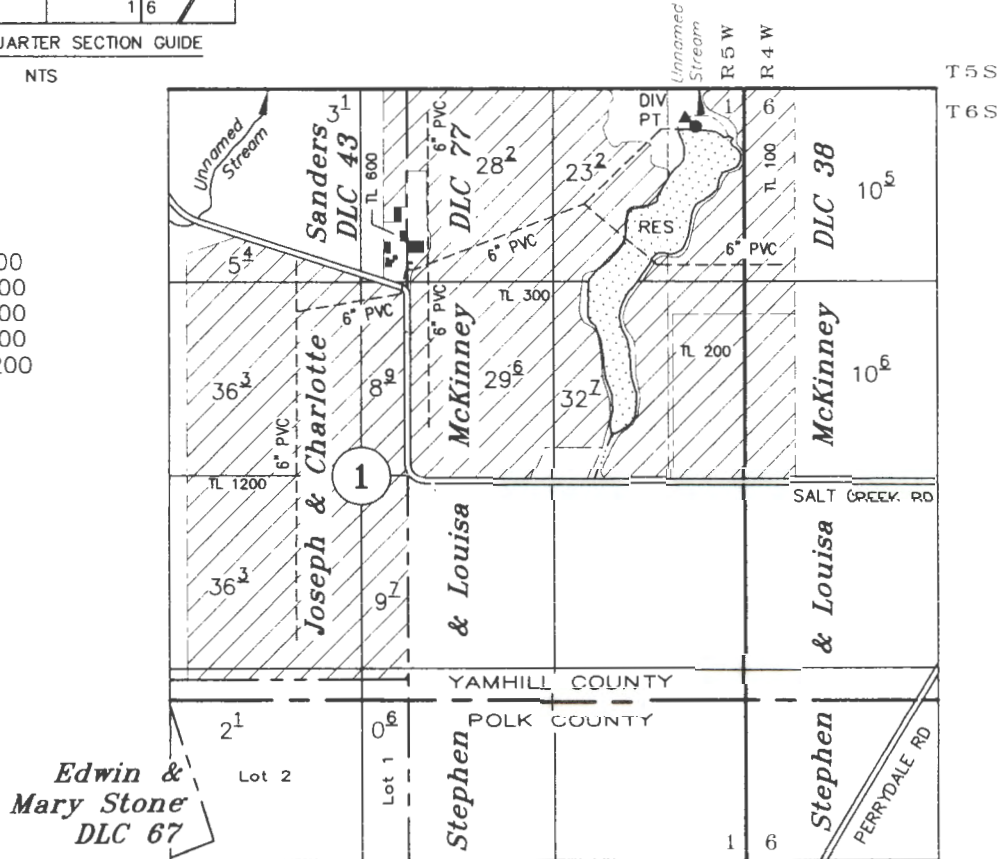

DIV PT: 257' S AND 325' W OF THE NE CORNER SEC 1
METER: 252' S AND 329' W OF THE NE CORNER SEC 1

CLAIM OF BENEFICIAL USE

Application No. S-86117

Permit No. S-54340

Bruce & Helle Ruddenklau
NW Farm Credit Services

December 10, 2019

SCALE: 1" = 1320'

NOTE: This map is for the purpose of identifying the location of water rights and has no intent to dimension or locate property ownership lines.



Renews: December 31, 2025