


RECEIVED

MAR 05 2021

OWRD

COBU MAP #1283

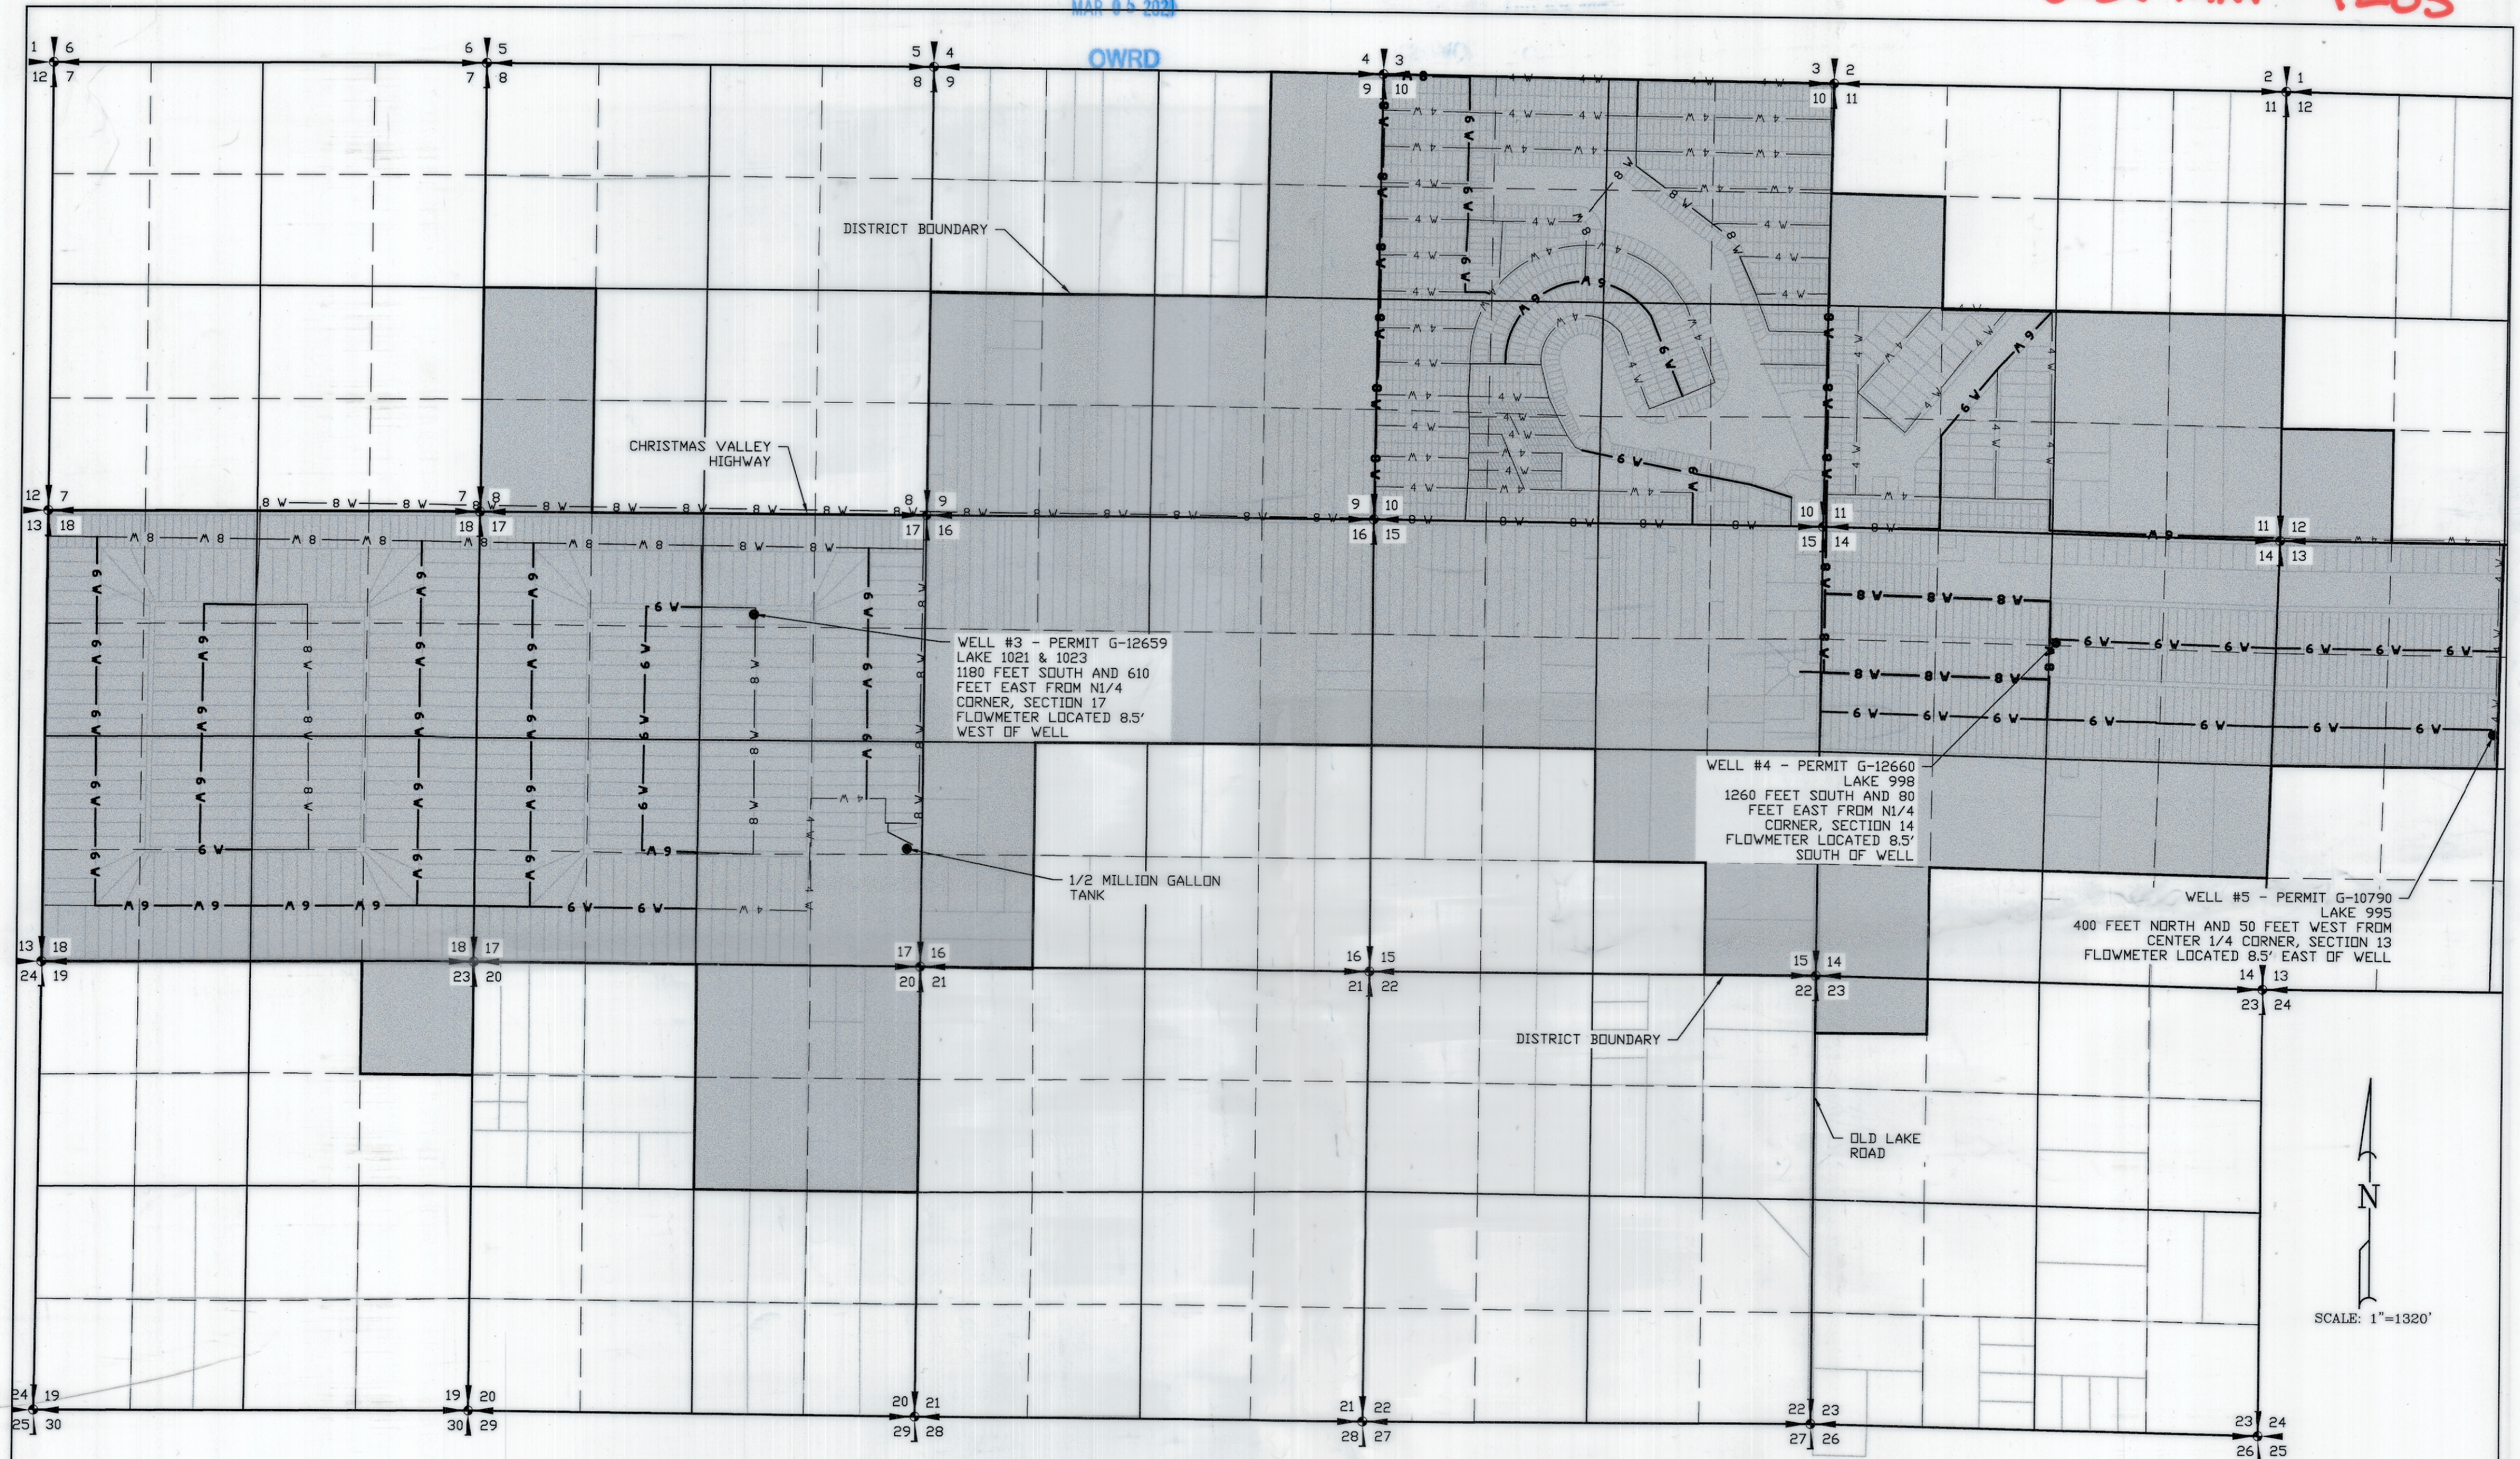

CLAIM OF BENEFICIAL USE MAP  
FOR  
CHRISTMAS VALLEY DOMESTIC  
WATER SUPPLY DISTRICT

SECTIONS 8, 9, 10, 11, 12, 13, 14, 15,  
16, 17, 18, 19, 20 & 23  
TOWNSHIP 27 SOUTH,  
RANGE 17 EAST, W.M.  
LAKE COUNTY, OREGON


APPLICATION NO. G-12864

PERMIT NO. G-12660

NOTE:  
PREPARATION OF THIS MAP IS FOR IDENTIFYING PROPOSED  
WATER RIGHTS ONLY. IT HAS NO INTENT TO PROVIDE  
LOCATIONS OR DIMENSIONS OF PROPERTY BOUNDARIES.


LEGEND

- SECTION LINE
- 1/4 SECTION LINE
- 1/16 SECTION LINE
- TAXLOT LINE
- 4" WATER LINE
- 6" WATER LINE
- 8" WATER LINE

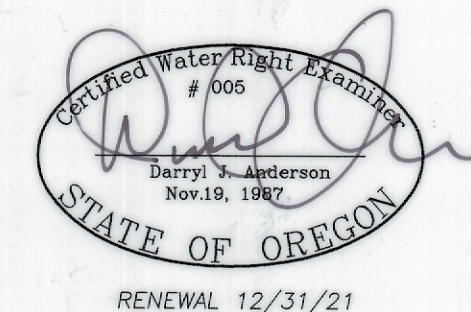

PREPARED FOR:  
CHRISTMAS VALLEY DOMESTIC  
WATER SUPPLY DISTRICT  
PO BOX 142  
CHRISTMAS VALLEY, OR 97638

PREPARED BY:  
ANDERSON ENGINEERING & SURVEYING, INC.

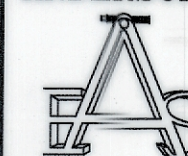

P.O. BOX 28  
LAKEVIEW, OREGON 97630  
(541) 947-4407 / FAX 947-2321  
WWW.ANDERSONENGINEERING.COM

DATE: 2/16/2021

DWG. FILE: 2021-016

JOB NO.: 2021-016

SHEET 1 OF 1