

TOWNSHIP 26 SOUTH, RANGE 5 WEST, WM  
SW 1/4 SW 1/4 SECTION 19

DOUGLAS COUNTY OREGON


CLAIM OF BENEFICIAL USE  
APPLICATION S-87824 PERMIT S-54797

IN THE NAME OF:

Gary and Louise Reed

P.O. Box 747

Winchester, OR 97495

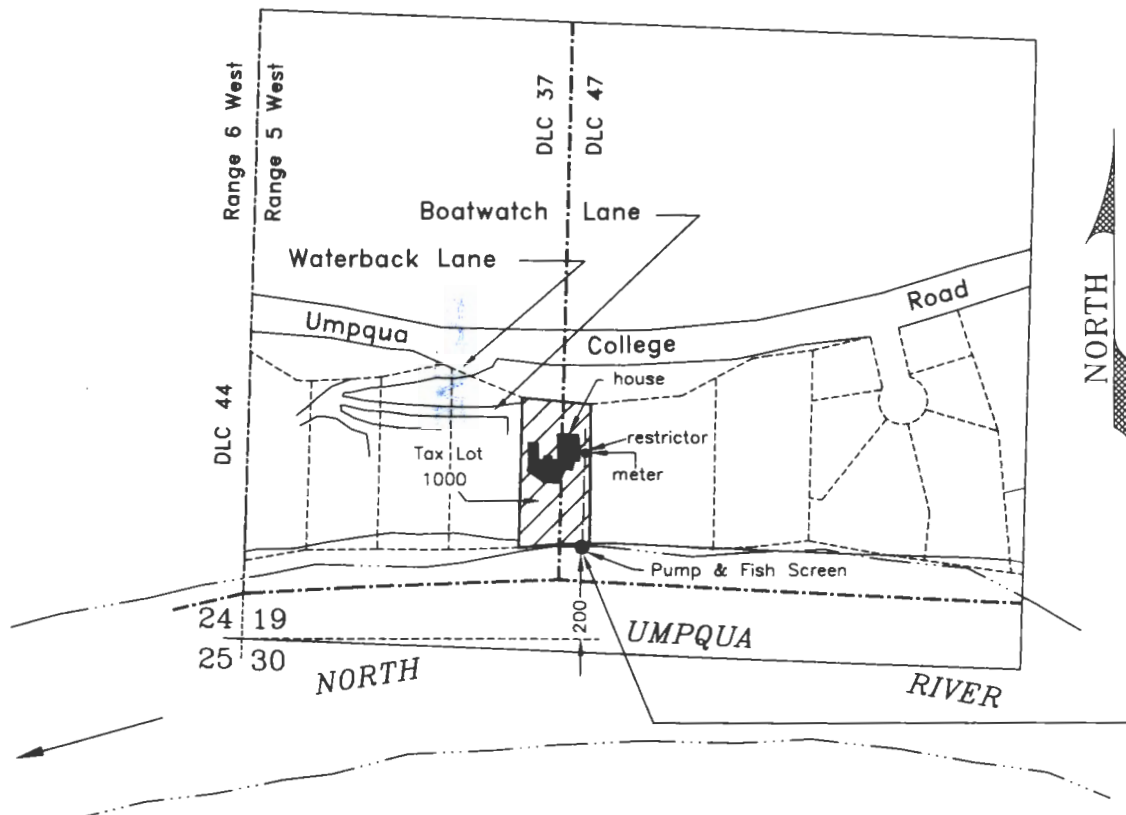


RECEIVED

NOV 17 2023

OWRD

POD - 200 feet north and 700 feet east from the SW corner section 19, being within the SW/SW section 19 and in DLC 47.

Legend

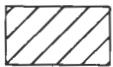
- Pipeline
- - - DLC Line
-  Domestic Expanded Tax Lot 1000

Scale

1 inch = 400 feet



This map is not intended to provide legal dimensions or locations of property ownership lines

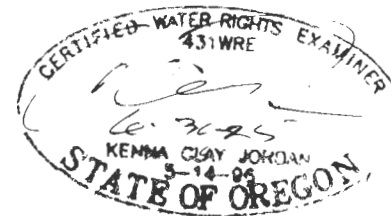

map prepared using County GIS  
tax lots over current ORmap,  
scaled & oriented to  
survey M154-39

JORDAN ENGINEERING  
460 JORDAN LANE  
ROSEBURG, OR 97471  
(541) 673-1931

9/23/2022 - n.e.d.  
Rev. 11/1/2023 - n.e.d.