


CLAIM OF BENEFICIAL USE MAP  
APPLICATION G-16362, PERMIT G-16022  
SECTION 30 & 31, TOWNSHIP 31 SOUTH, RANGE 15 WEST, &  
SECTION 25, TOWNSHIP 31 SOUTH, RANGE 16 WEST W.M.  
CURRY COUNTY, OREGON

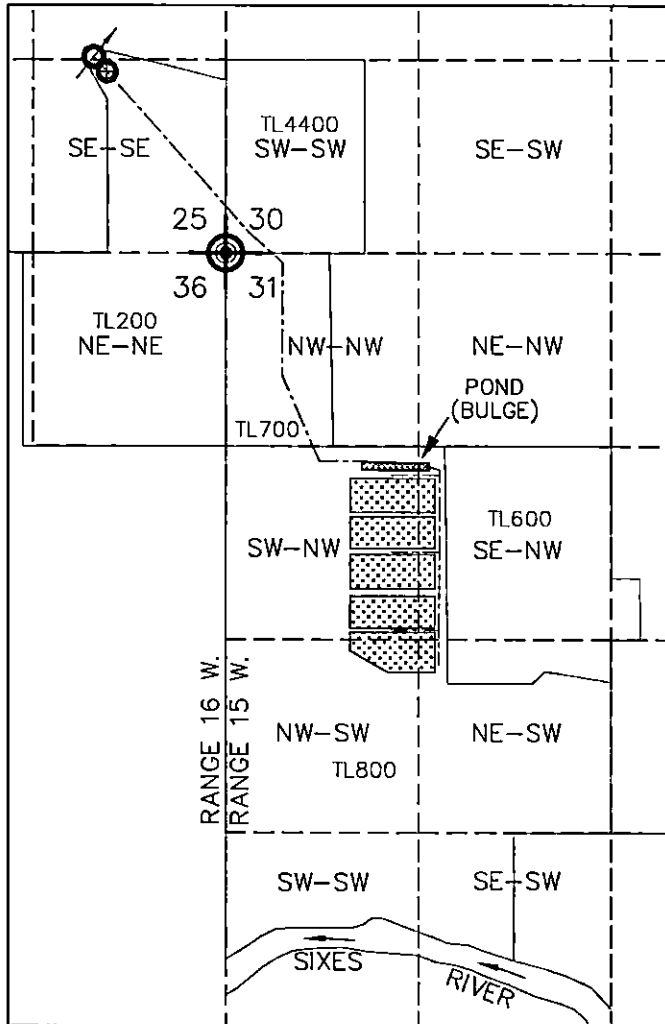

LEGEND




POINT OF BEGINNING (P.O.B.):  
SE COR. SEC. 25, T.31S., R.16W.,  
W.M.




POINT OF APPROPRIATION (P.O.A.):  
P.O.A. #1: 1366 FT. N. & 927 FT.  
W. FROM P.O.B.



TOTALIZING FLOWMETER

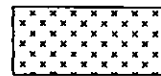

PLACE OF USE:  
CRANBERRY BOGS

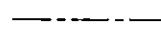

MAINLINE



TAXLOTS



1/16TH SECTION LINES  
(AS PROJECTED)

| CRANBERRY BOGS |       |
|----------------|-------|
| Q-Q, SEC. 31   | ACRES |
| SW-NW          | 10.1  |
| SE-NW          | 2.4   |
| NE-SW          | 0.5   |
| NW-SW          | 2.0   |
| TOTAL          | 15.0  |



NORTH

1"=1320'



EXPIRES 06/30/2024

DISCLAIMER: THIS MAP WAS PREPARED FOR THE PURPOSE OF IDENTIFYING THE LOCATION OF WATER RIGHT ONLY AND IS NOT INTENDED TO PROVIDE LEGAL DESCRIPTIONS OR LOCATIONS OF PROPERTY LINES.

**VCC**

**VAN CAMP CONSULTING**

P.O. Box 995  
Coos Bay, OR 97420  
(541) 297-1880  
vancampconsulting@gmail.com

Prepared For:  
John Sweet  
1291 N. 9TH ST.  
Coos Bay, OR 97420

Project:  
G-16022 Claim of  
Beneficial Use

Date: February 13, 2022