

T. 6 S., R. 5 W., W.M.

FINAL PROOF SURVEY
UNDER

Application S-74408
Application R-74409

Permit 52013
Permit R-11691

IN NAME OF
DELPHIAN SCHOOL
Surveyed June 21, 2024

Received
SEP 20 2024
OWRD

Location:


The NE 1/4 & SE 1/4 SECTION 29,
T. 5 S., R. 6 W., W.M., MARCELLUS
FALCONER D.L.C. #62, YAMHILL
COUNTY, OR

Tax Lot: 5629 - 100

Date: 25 July 2024

North

Scale: 1" = 1320'

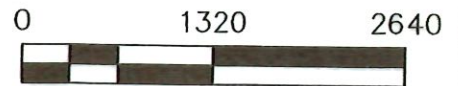

19 20
30 29
Christopher C.
Baker D.L.C. #59

Marcellus Falconer
D.L.C. #62

William C. McClure
D.L.C. #58

U.S.
LOT
1

NW 1/4
NE 1/4

29
NE 1/4
NE 1/4

U.S.
LOT
2

U.S. LOT 3
POND PUMP
HOUSE
P.O.D. METER

SE 1/4
NE 1/4

IRRIGATION
LINES (TYP.)
MAIN
BUILDING

NE
NW CORNER
D.L.C. #62

NE 1/4
SE 1/4

U.S. LOT 4

U.S. LOT 5

U.S. LOT 6

PLACE OF USE TABLE:


LOCATION	TOTAL AREA
U.S. LOT 3	2.80 ACRES
SE 1/4 NE 1/4	1.12 ACRES
NE 1/4 SE 1/4	1.56 ACRES
U.S. LOT 4	9.40 ACRES
D.L.C. #62	0.03 ACRES

POINT OF DIVERSION:
150' S. & 350' E.
NW COR. D.L.C. #62
NE

I CERTIFY THAT THE INFORMATION I HAVE
PROVIDED IN THIS FINAL PROOF SURVEY IS
AN ACCURATE REPRESENTATION OF THE
ACTUAL WATER USE AND IS TRUE AND
CORRECT TO THE BEST OF MY KNOWLEDGE.
THIS MAP IS TO BE USED FOR THE PURPOSE
OF IDENTIFYING THE LOCATION OF WATER
RIGHT ONLY AND IS NOT INTENDED TO
PROVIDE LEGAL DIMENSIONS OR LOCATIONS
OF PROPERTY OWNERSHIP LINES.

LELAND A. MACDONALD, 53226 CWRE

Leland MacDonald & Assoc., LLC
3765 Riverside Drive
McMinnville, Oregon 97128
Phone: 503-472-7904
Email: lee@macdonaldsurveying.com

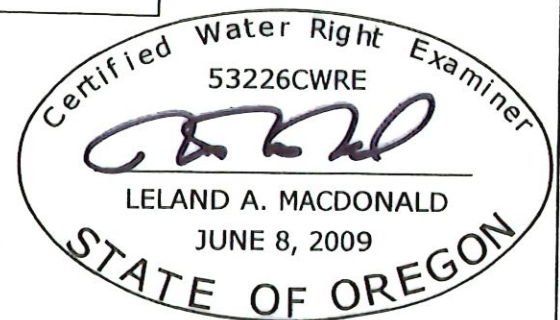

RENEWES: 31 DECEMBER, 2024

11/6/2025 WBD/CH COLLECTION #9147