


CLAIM OF BENEFICIAL USE MAP

TO ADD PLACE OF USE AND
POINTS OF APPROPRIATION
FOR APPLICATION G-15927
TJY PROPERTIES, LLC

TOWNSHIP 8 SOUTH, RANGE 16 EAST, SECTION 20, W.M.
TAX LOT 2700

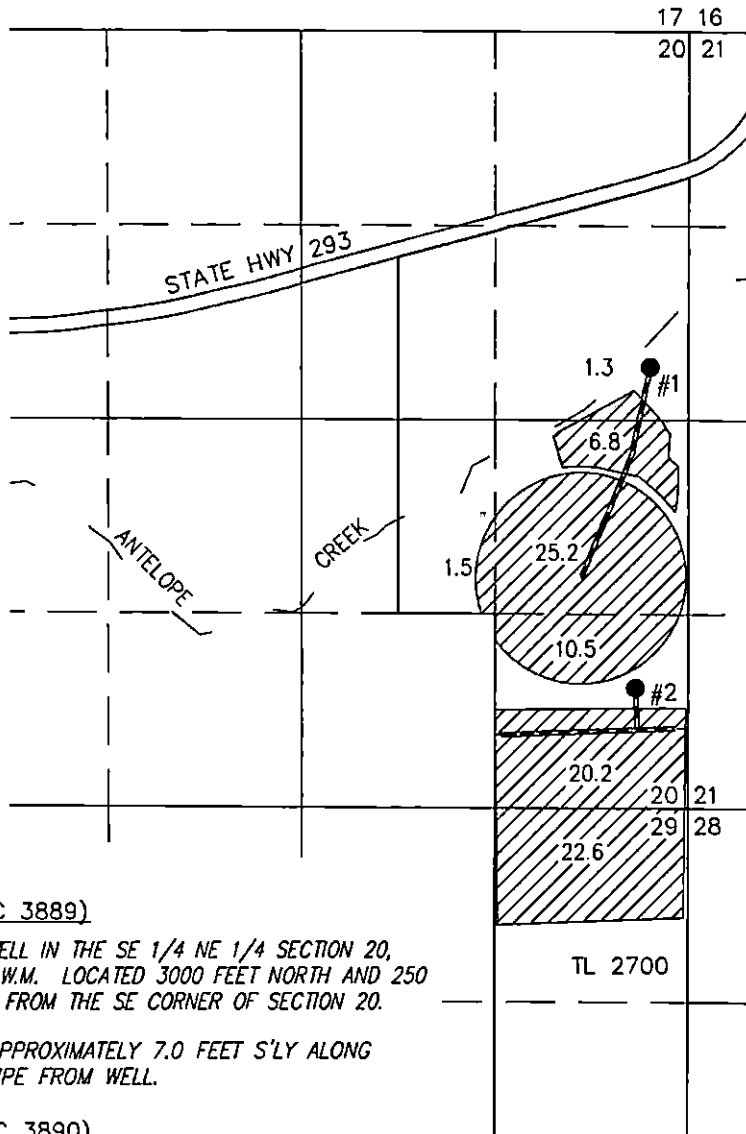

NOV 27 2001
TJY



88.1 ACRES IR FROM PERMIT
G-15521, AS SHOWN.

● #1 (WASC 3889)


EXISTING WELL IN THE SE 1/4 NE 1/4 SECTION 20,
T8S R16E, W.M. LOCATED 3000 FEET NORTH AND 250
FEET WEST FROM THE SE CORNER OF SECTION 20.

METER IS APPROXIMATELY 7.0 FEET S'LY ALONG
DELIVERY PIPE FROM WELL.

● #2 (WASC 3890)

EXISTING WELL IN THE SE 1/4 SE 1/4 SECTION 20,
T8S R16E, W.M. LOCATED 820 FEET NORTH AND 360
FEET WEST FROM THE SE CORNER OF SECTION 20.

METER IS APPROXIMATELY 10.0 FEET W'LY ALONG
DELIVERY PIPE FROM WELL.

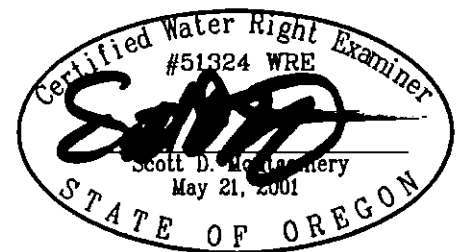

RENEWAL DATE: 12/31/2024

THIS MAP IS FOR THE PURPOSE OF LOCATING A
WATER RIGHT ONLY AND HAS NO INTENT TO
PROVIDE LEGAL DIMENSIONS OR THE LOCATION OF
PROPERTY LINES

PREPARED FOR:

TJY PROPERTIES, LLC
13372 CREST VALLEY DRIVE
RENO, NV 89511

PREPARED BY:



ALL POINTS ENGINEERING AND SURVEYING, INC.
P.O. BOX 767
(541) 548-5833
TERREBONNE, OR 97760
www.APEandS.com