

CLAIM OF BENEFICIAL USE MAP

FOR PERMIT APPLICATION G-17138

MIKE PEILA


TOWNSHIP 24 SOUTH, RANGE 30 EAST, SECTIONS 9, 10, & 16, W.M.

TAX LOT: 300


#2 HARN 52485

LOCATED IN THE SW 1/4 SE 1/4 SECTION 10, T24S R30E, W.M. AND 1470 FEET SOUTH AND 1360 FEET WEST FROM THE E 1/4 CORNER OF SECTION 10.

NEWLY INSTALLED METER IS APPROXIMATELY 6 FEET NORTH ALONG DELIVERY PIPE FROM WELL.

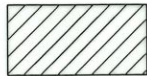

168.8 ACRES IR WATER RIGHTS FROM POA 2 AND PERMIT G-18378, AS SHOWN.

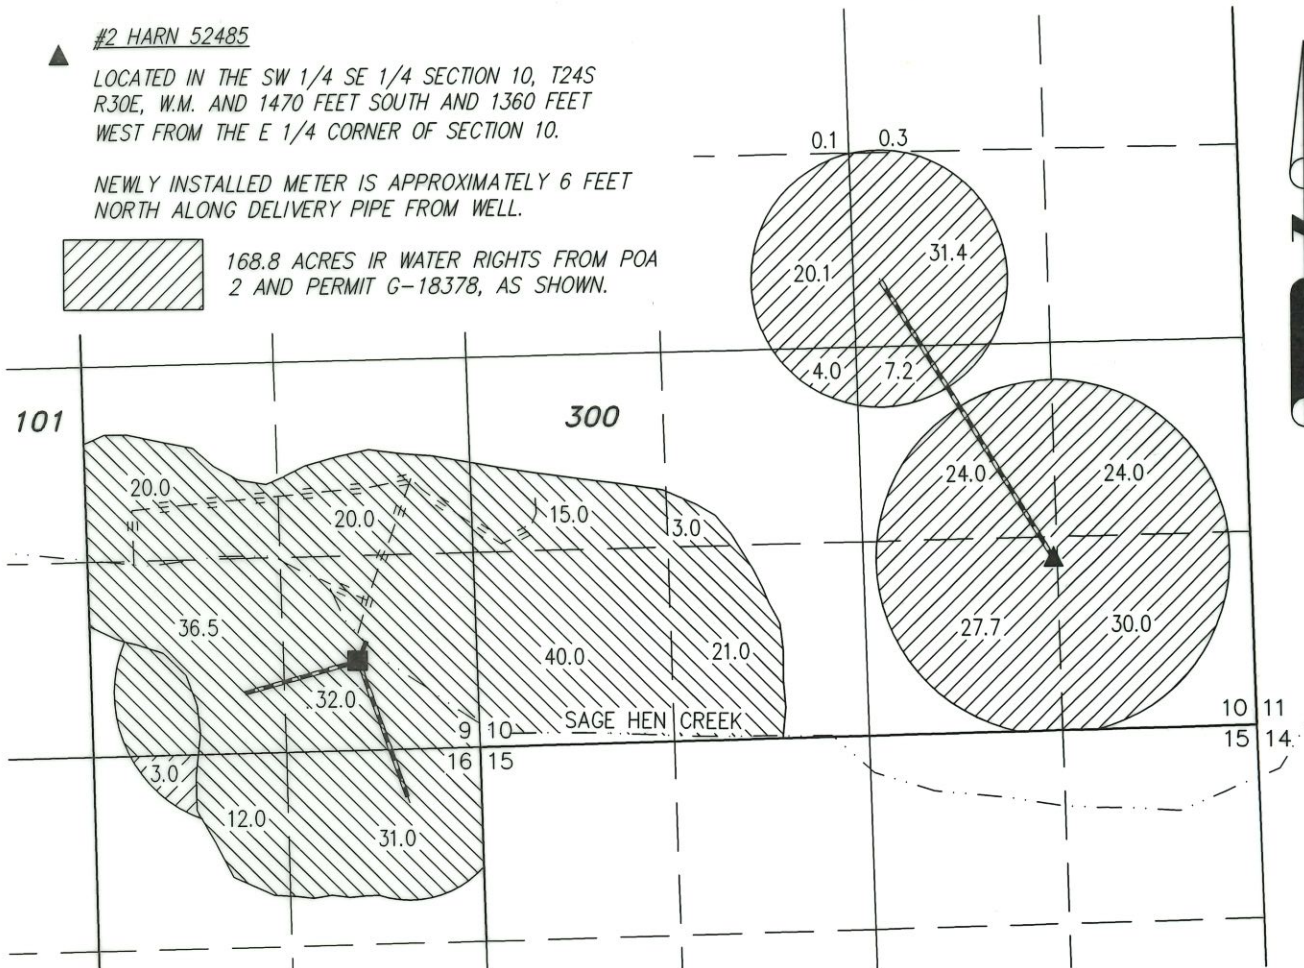

SCALE: 4 INCHES = 1 MILE

#1 HARN 51503/51680

LOCATED IN THE SE 1/4 SE 1/4 SECTION 9, T24S R30E, W.M. AND 630 FEET NORTH AND 850 FEET WEST FROM THE SE CORNER OF SECTION 9.



NEWLY INSTALLED METER IS APPROXIMATELY 7 FEET EAST ALONG DELIVERY PIPE FROM WELL.



3.0 ACRES IR WATER RIGHTS FROM POA 1 AND PERMIT G-18378, AS SHOWN.



230.5 ACRES IS WATER RIGHTS FROM POA 1 AND PERMIT G-18378, AS SHOWN.

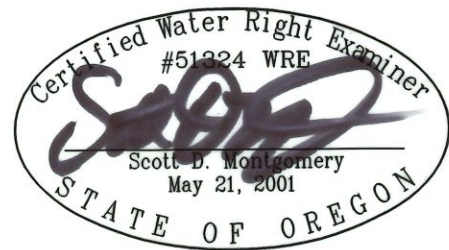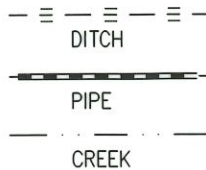

RENEWAL DATE: 12/31/2026

THIS MAP IS FOR THE PURPOSE OF LOCATING A WATER RIGHT ONLY AND HAS NO INTENT TO PROVIDE LEGAL DIMENSIONS OR THE LOCATION OF PROPERTY LINES

PREPARED FOR:

MIKE PEILA
P.O. BOX 537
HINES, OR 97738

PREPARED BY:



ALL POINTS ENGINEERING AND SURVEYING, INC.
P.O. BOX 767
(541) 548-5833
TERREBONNE, OR 97760
www.APEandS.com

Received
JUN 16 2025

OWRD