


**T24S R34E, WM
HARNEY COUNTY, OR**

- Well & Meter
- Pipeline
-  POU IR 11/5/1990 Priority
-  Township
-  Section
- Quarter Quarter
-  Tax Lot

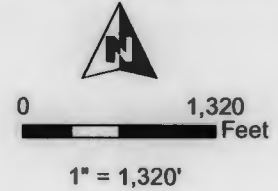


RENEWAL DATE 12/31/2025



Well Locations:

#1 (No Log): 1387' N, 45' E of SW Cor Sec 19

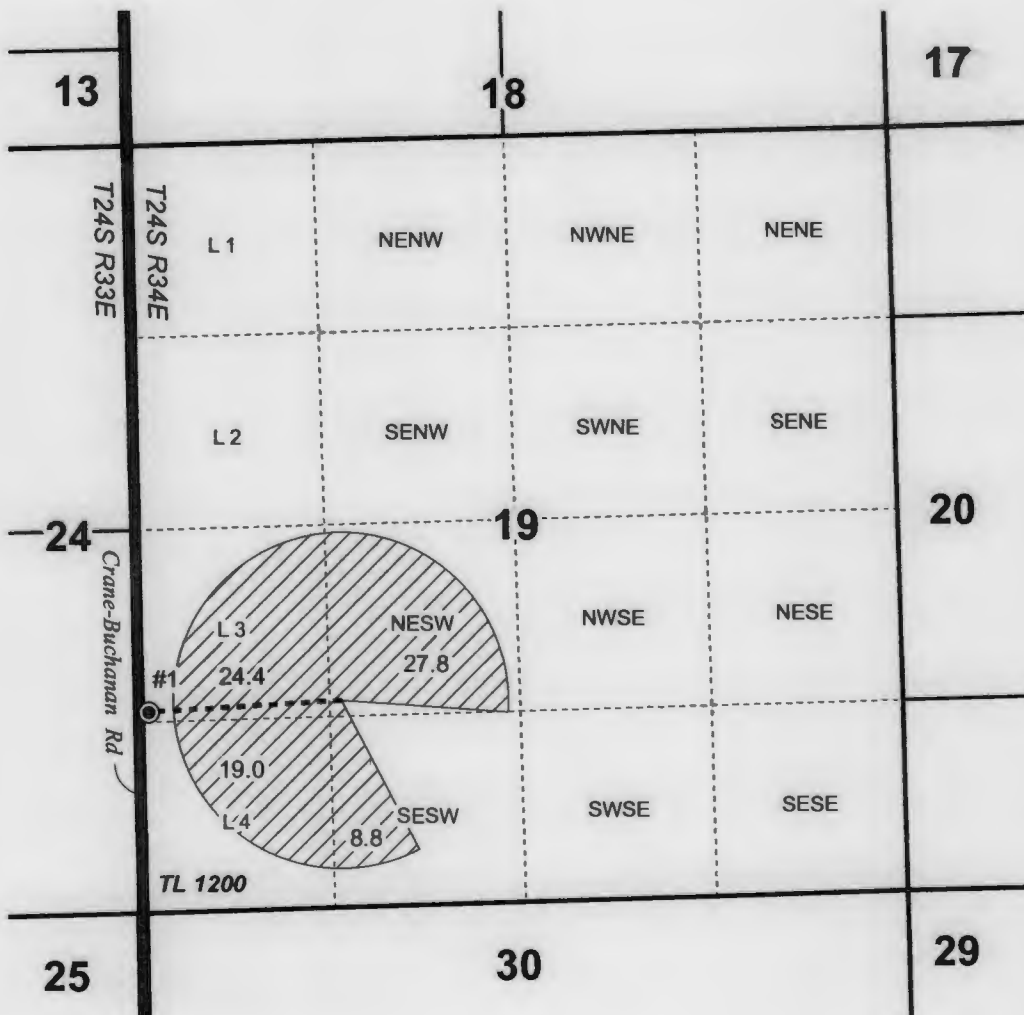

RECEIVED
MAR 26 2024
OWRD



**CLAIM OF BENEFICIAL USE MAP
Potter**

This map is not intended
to provide legal dimensions
or locations of property
ownership lines.

WATER RIGHT SERVICES, LLC
PO BOX 1830, BEND, OR 97709
WWW.OREGONWATER.US CCB # 197121
johnshort@usa.com 541-389-2837

Date: 2/27/2024

T-12508

Project #23073