


JUL 10, 2025

QWRD

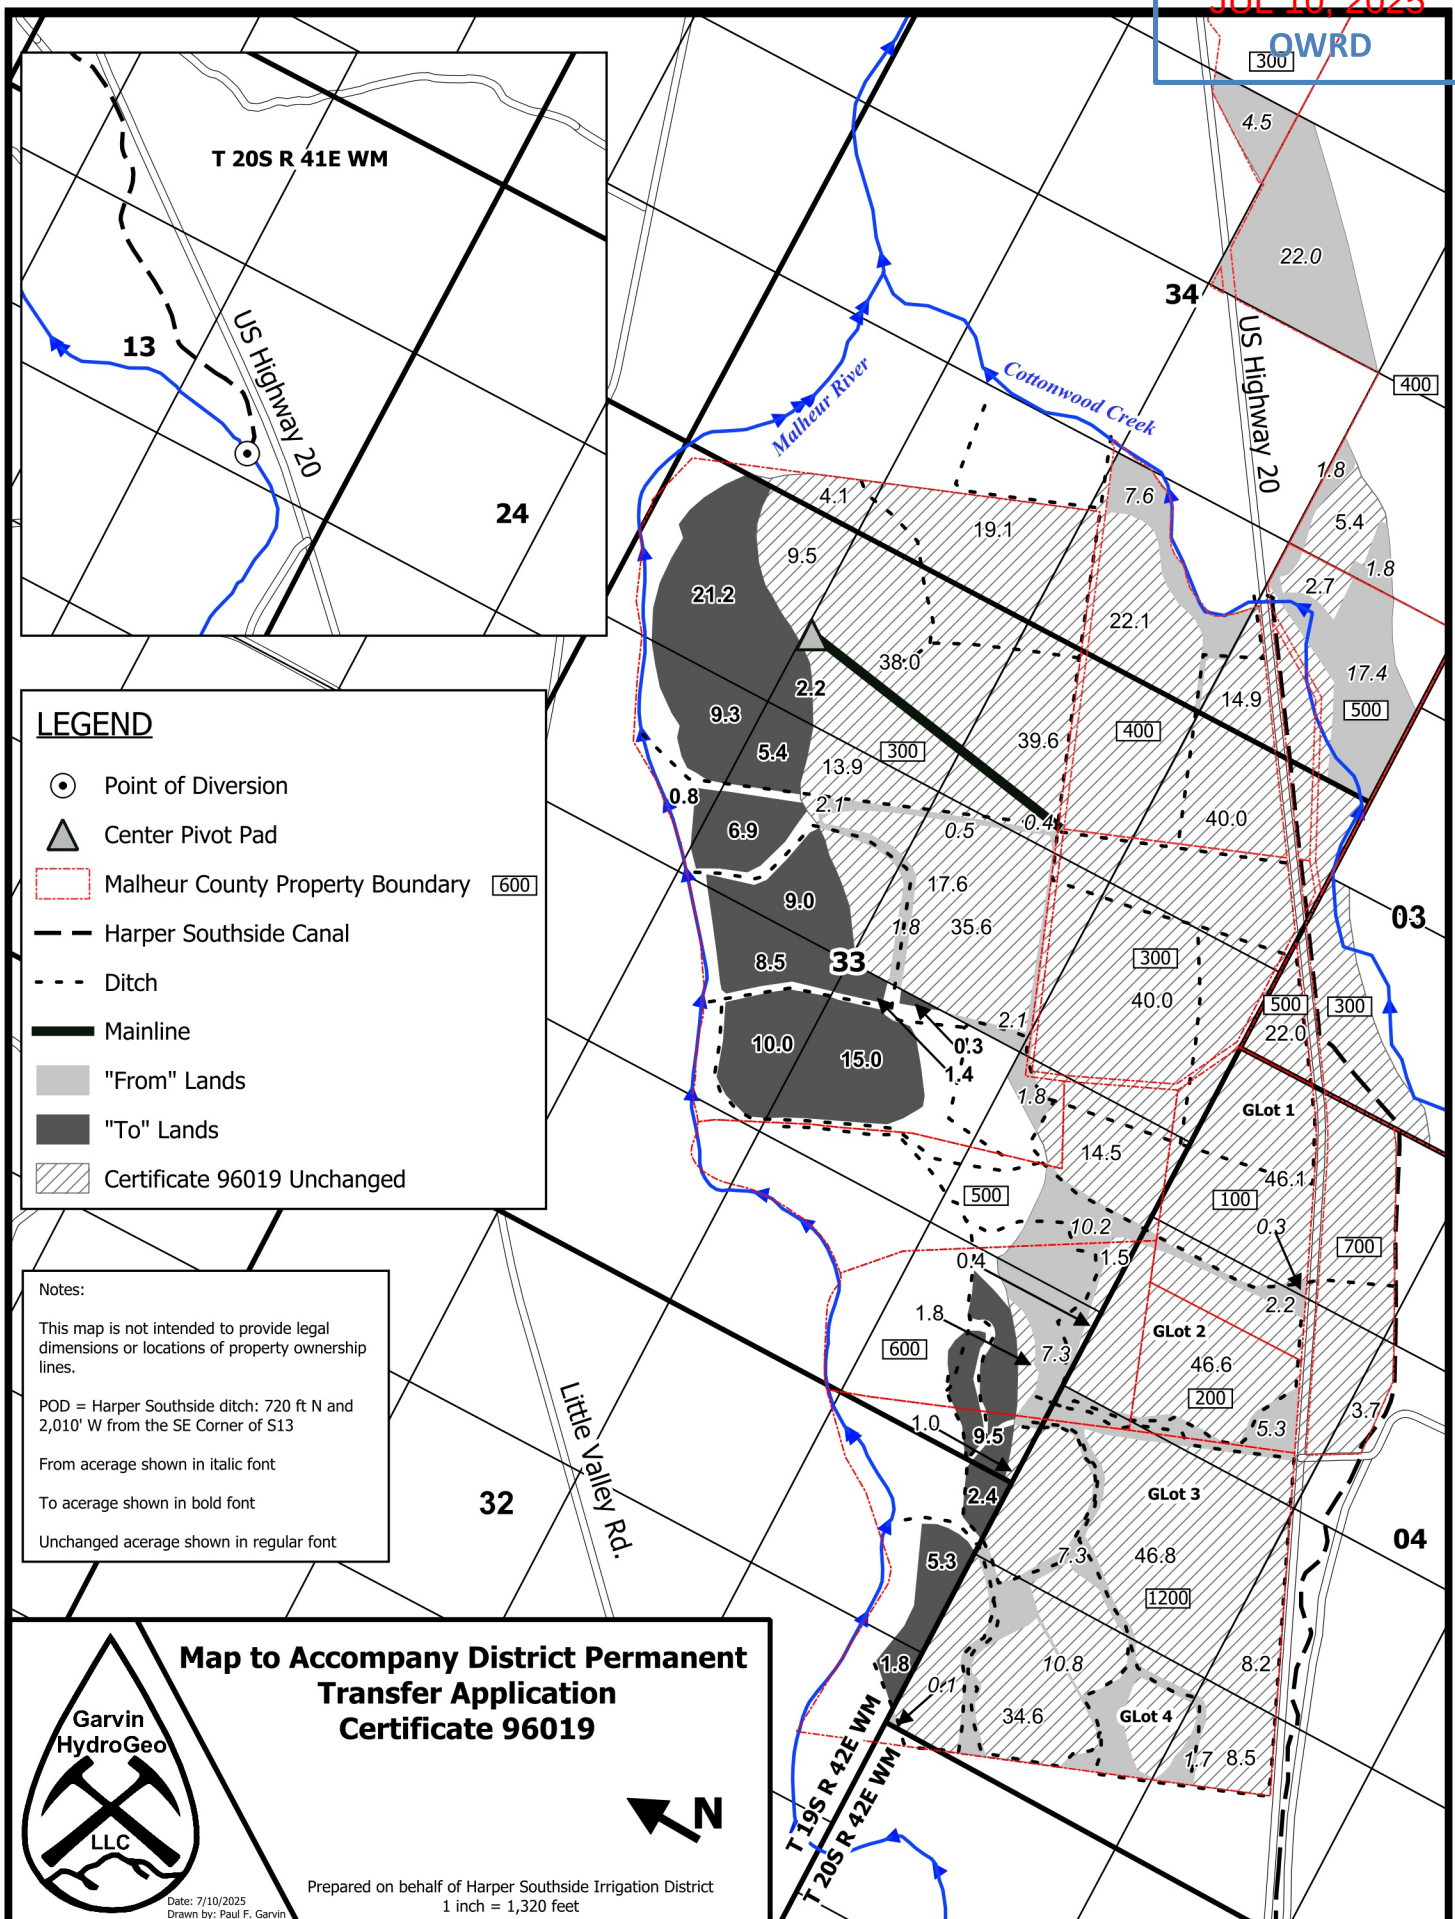




Vale Oregon Irrigation District

T 19 R 42 Sec 32, SESW / T 20 R 42 Sec 5, NWNE & NENE

Robert & Karen Nichols

E-RECEIVED
10/24/2023
OWRD

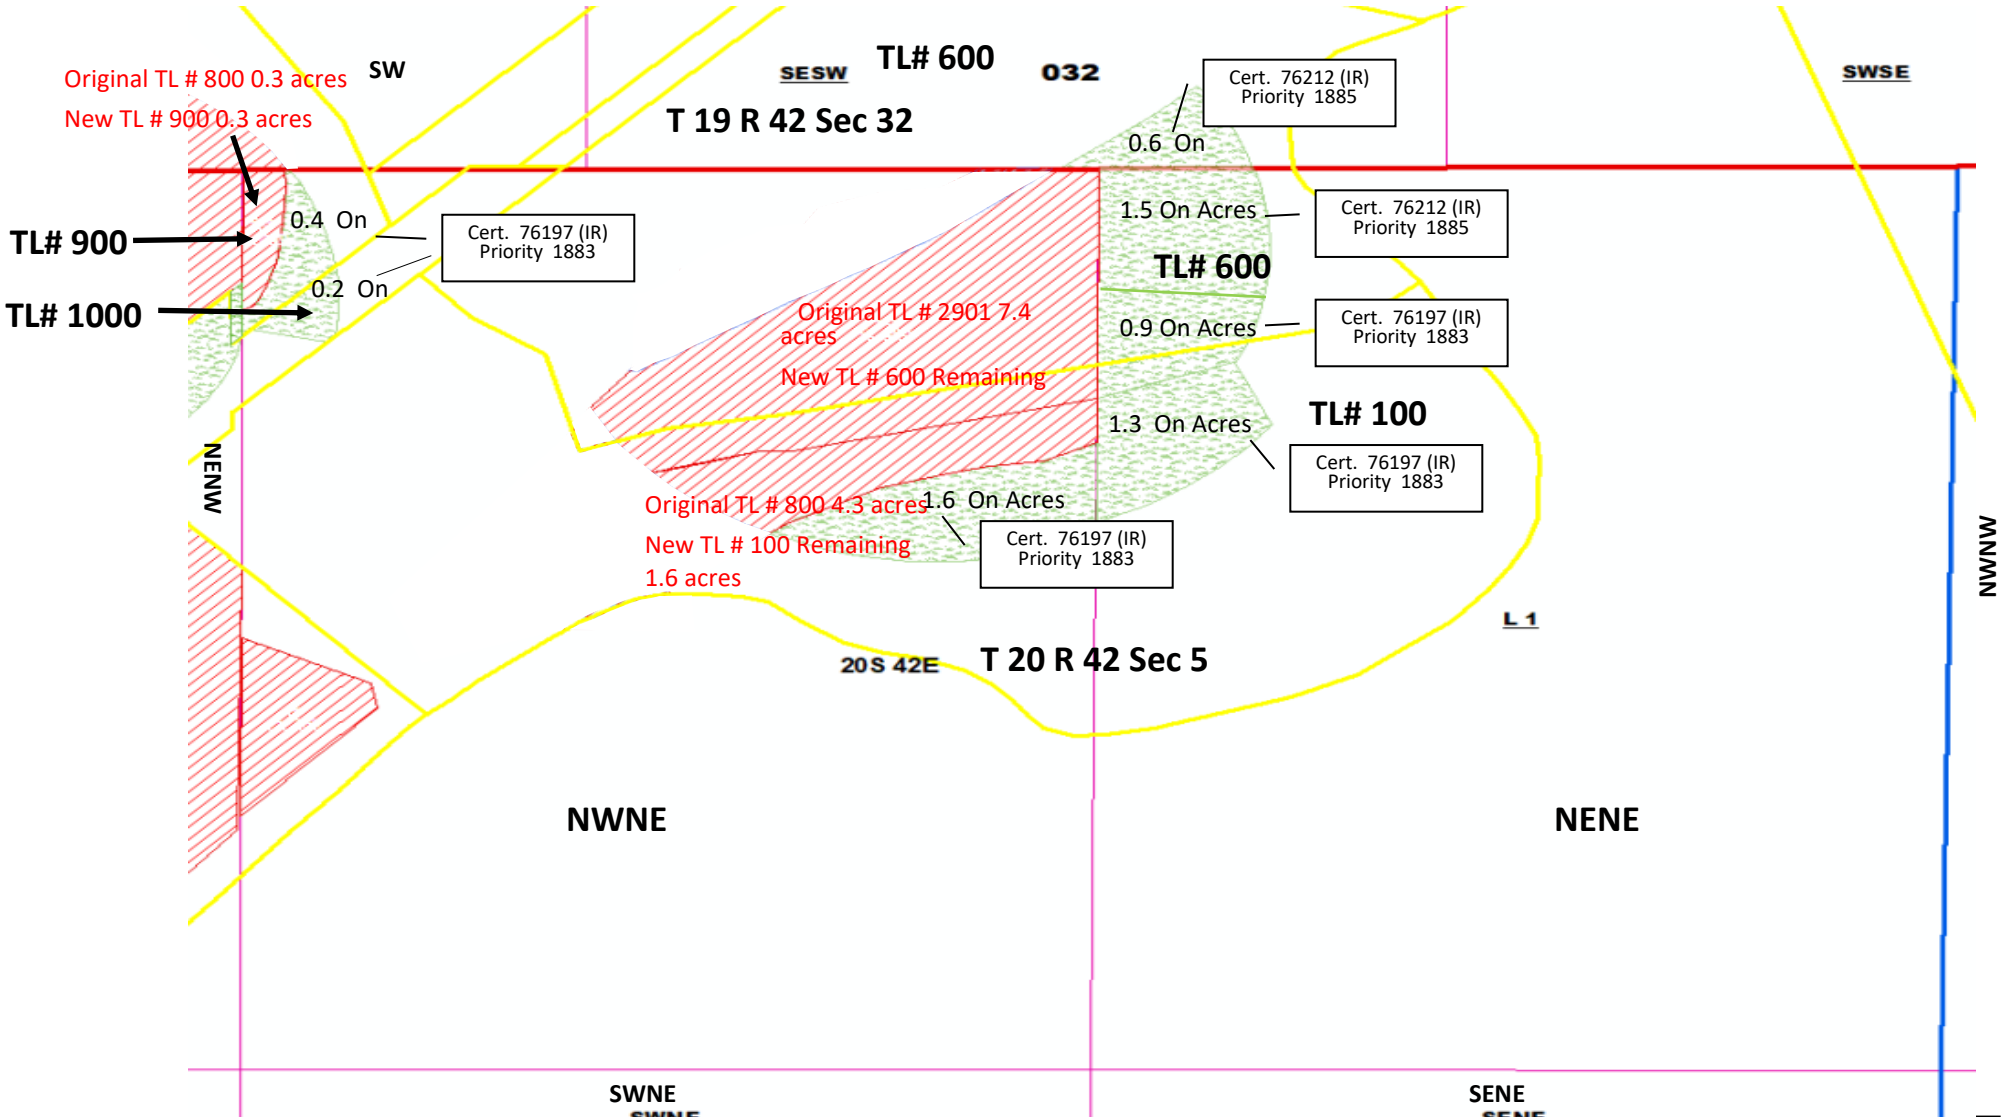

Legend

- RKN_Remaining_ 7.74 Acres
- RKN_To_ 6.5 Acres

Transfer Cert. 76212 (IR) On
74080 (IS)
74081 (IS)

19-42-32 SESW TL #600 0.6 ac

20-42-05 NENE TL #600 1.5 ac

Transfer Cert. 76197 (IR) On Off
74080 (IS)
74081 (IS)

20-42-5 NWNE: TL# 900 .4 ac
TL# 1000 .2 ac
TL# 100 1.6 ac


NENE: TL# 600 0.9 ac
TL# 100 1.3 ac



T 20 R 42 Sec 5

Robert & Karen Nichols

E-RECEIVED
10/24/2023
OWRD

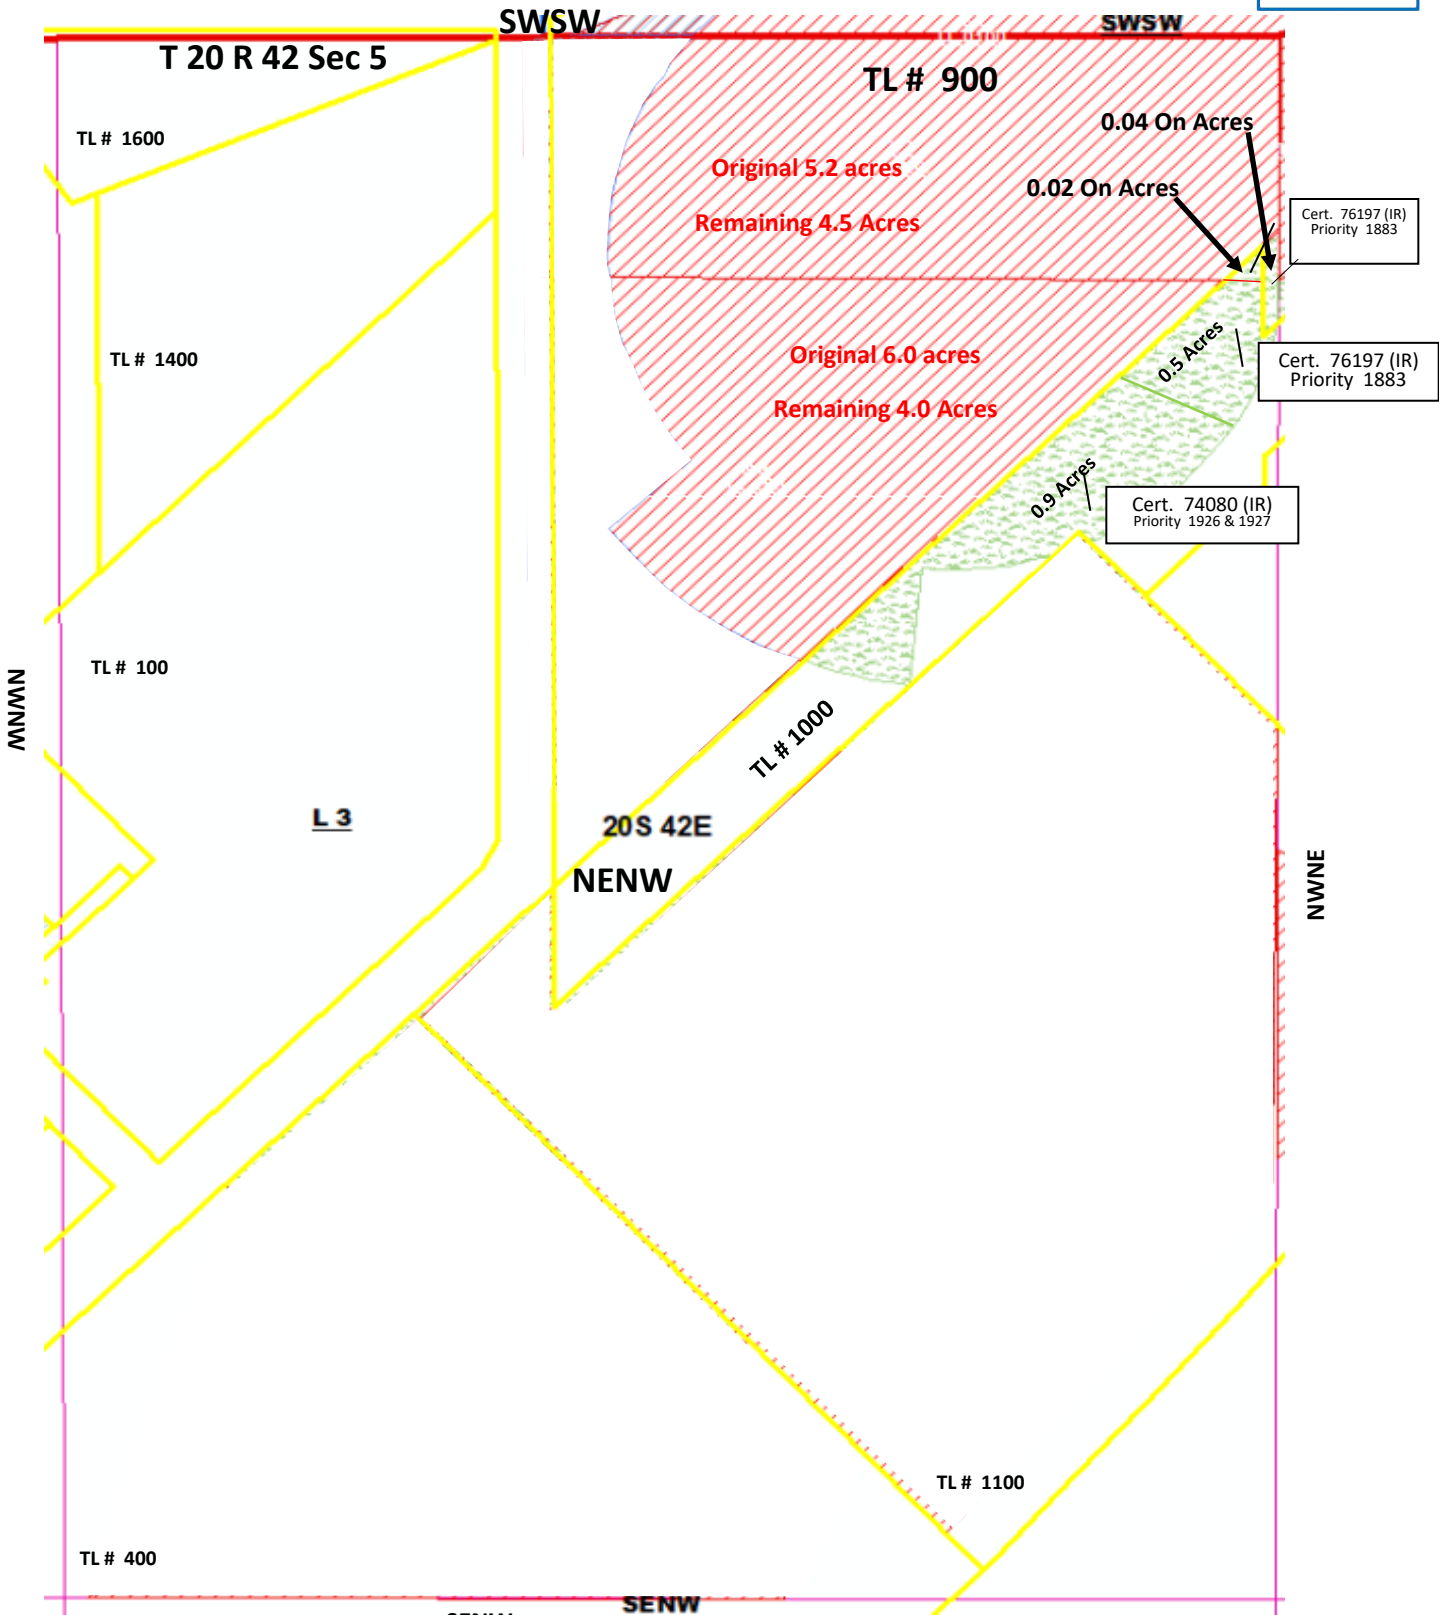

No

Final Proof

Map

Available