

CERTIFICATE HOLDER:
JACKSON FAMILY INVESTMENTS III, LLC
425 AVIATION BLVD
SANTA ROSA, CA 95403

PERMANENT TRANSFER APPLICATION MAP
T2S, R4W, SECTIONS 25+26+35+36, TAX LOT 500 W.M.
19143 NE LAUGHLIN ROAD, YAMHILL, OREGON 97148
YAMHILL COUNTY

- LEGEND**
- SECTION LINE
 - 1/4 1/4 LINE
 - DLC LINE
 - PROPERTY LINE
 - TRIBUTARY
 - SECTION CORNER
 - DLC CORNER
 - SPRING
 - PUMP HOUSE
 - STOCK WATER TROUGH
 - APPROXIMATE LOCATION OF EXISTING 4" DIA. DUCTILE IRON MAIN

REMAINING PRIMARY
APP S-71566
CERTIFICATE 85416

REMAINING SUPPLEMENTAL
APP S-72253
CERTIFICATE 85264

103.12 ACRES

'FROM' PRIMARY
APP S-71566
CERTIFICATE 85416

FROM SUPPLEMENTAL
APP S-72253
CERTIFICATE 85264

2.28 ACRES

'TO' PRIMARY
APP S-71566
CERTIFICATE 85416

FROM SUPPLEMENTAL
APP S-72253
CERTIFICATE 85264

2.28 ACRES

'FROM' PLACE OF USE
CERTIFICATES 85264 & 85416

TWP	RNG	SEC	Q-Q	TL	DLC	AC
2S	4W	36	NW NW	500		0.62
2S	4W	36	NE NW	500		1.66
TOTAL ACRES						2.28

'TO' PLACE OF USE
CERTIFICATES 85264 & 85416

TWP	RNG	SEC	Q-Q	TL	DLC	AC
2S	4W	26	NW SE	500		2.28
TOTAL ACRES						2.28

POINTS OF DIVERSION PER CERTIFICATES 85264 & 85416


POD	TWP	RNG	SEC	Q-Q	MEASURED DISTANCE
SPRING 1	2S	4W	26	NE SE	1370' NORTH AND 80' EAST FROM NW CORNER, SE SE, SECTION 26
SPRING 2	2S	4W	26	SE SE	1330' NORTH AND 80' EAST FROM NW CORNER, SE SE, SECTION 26
SPRING 3	2S	4W	26	SE SE	940' NORTH AND 510' WEST FROM SE CORNER, SECTION 26
SPRING 4	2S	4W	26	NE SE	1800' NORTH AND 200' WEST FROM SE CORNER, SECTION 26
SPRING 5	2S	4W	25	SW SW	1110' NORTH AND 70' EAST FROM SW CORNER, SECTION 25
SPRING 6	2S	4W	26	SE SE	25' NORTH AND 270' WEST FROM SE CORNER, SECTION 26
LACROUTE RESERVOIR	2S	4W	26	NW SE	1770' NORTH AND 1520' WEST FROM SE CORNER, SECTION 26

MAP BASED ON TAX MAPS 2S R4 SECTIONS 25, 26, 35, 36 AND CERTIFICATE 85416
NOTE: THIS MAP IS PRODUCED TO APPLY FOR THE BENEFICIAL USE OF A WATER RIGHT. IT IS NOT INTENDED TO PROVIDE INFORMATION RELATIVE TO THE LOCATION OF PROPERTY LINES.

BLUNDON ENGINEERING, LLC.
PO BOX 786
HILLSBORO, OREGON 97123
541-510-5910
NICK@BLUNDONENGINEERING.COM
DWG: TRANSFER APP-A
DATE: 9-16-2024

BLUNDON
ENGINEERING, LLC


Received by OWRD
SEP 19 2024
Salem, OR

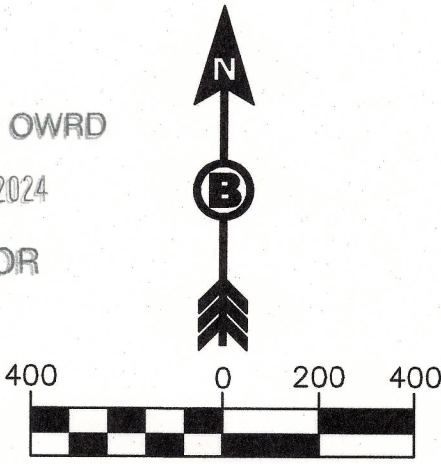

1 inch = 400 ft.
PRINT SCALE=24"x18" (LxW)

Certified Water Right Examiner
#83725
Nicholas Gordon Blundon
NICHOLAS GORDON BLUNDON
MAY 14, 2019
STATE OF OREGON
EXPIRES 12/31/2025

SECTION 25, 26, 35 & 36, T.2 S., R.4 W., W.M.
YAMHILL COUNTY, OREGON

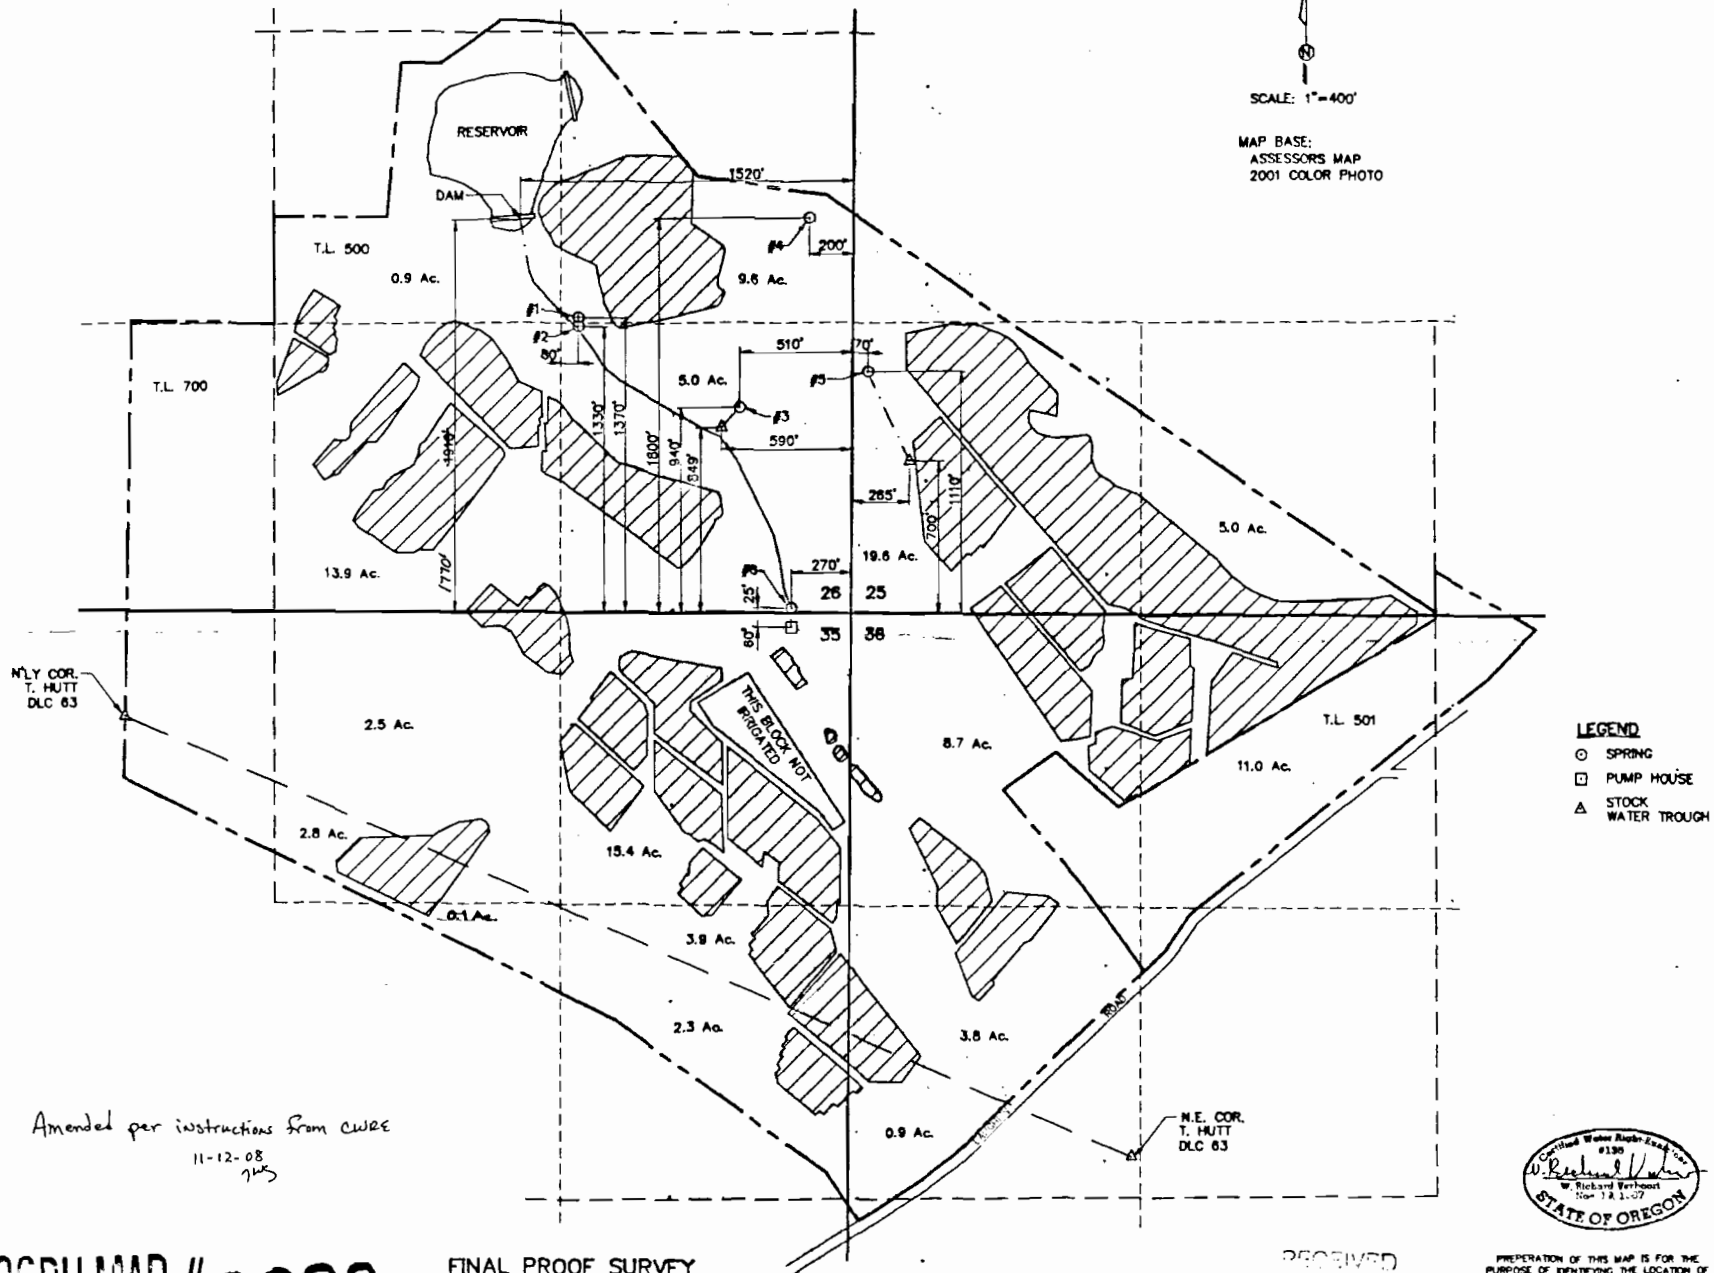

Amended per instructions from CWEE
11-12-08
JMS

CCBU MAP #0099

FINAL PROOF SURVEY
SURVEYED MARCH 5, 2002
APPLICATIONS S-71568, S-72253
PERMITS 51282, 51586

RECEIVED



PREPARATION OF THIS MAP IS FOR THE PURPOSE OF IDENTIFYING THE LOCATION OF THE WATER RIGHT ONLY. THERE IS NO INTENT TO PROVIDE DIMENSIONS OR LOCATION OF PROPERTY OWNERSHIP LINES.

BERNARD J. & RONNI S. LACROUTE
19143 N.E. LAUGHLIN RD
YAMHILL, OR 97148

date	04/23/02
by	WRV
designed	WRV
drawn	JER
checked	WRV
drawing no.	02-C-01
sheet no.	1 / 1

VERBOORT ENGINEERING
AGRICULTURE - CIVIL - WATER RESOURCES
HILLSBORO, OREGON