


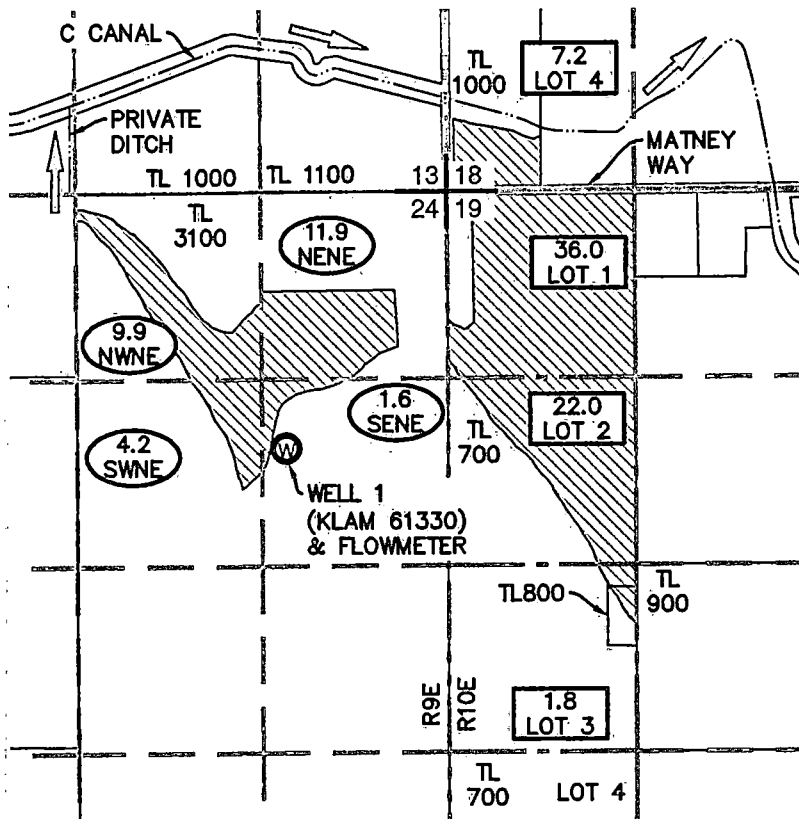

LEGEND	
	RANGE LINE
	SECTION LINE
	1/4 1/4 LINE
	GOVERNMENT LOT LINE
	TAX LOT LINE
	CANAL/CREEK
	ROAD
	FLOW DIRECTION
	SECTION CORNER
	TAX LOT NUMBER
	GOVERNMENT LOT NUMBER
	POA (WELL)
	PRIMARY AND SUPPLEMENTAL IRRIGATION LANDS UNDER TRANSFER T-13501
	AUTHORIZED ACRES
	1/4 1/4 SECTION
	AUTHORIZED ACRES
	GOVERNMENT LOT

NOTES:



1. THIS MAP WAS PREPARED FROM FIELD MEASUREMENTS, NAIP 2024 AERIAL PHOTOGRAPH, KLAMATH COUNTY TAX MAPS, AND OREGON GLO MAPS.
2. THE PURPOSE OF THIS MAP IS TO IDENTIFY THE LOCATION OF THE WATER RIGHT ONLY, AND IS NOT INTENDED TO PROVIDE DIMENSIONS OR LOCATION OF PROPERTY LINES.
3. THIS TRANSFER CHANGED THE POINT OF APPROPRIATION FOR TWO LAYERED WATER RIGHTS: CERTIFICATE 31787 (PRIMARY IRRIGATION) AND CERTIFICATE 37578 (SUPPLEMENTAL IRRIGATION).
4. DATE OF PRIORITY FOR CERTIFICATE 31787 WAS MAY 9, 1957.
5. DATE OF PRIORITY FOR CERTIFICATE 37578 WAS MARCH 17, 1965.

WELL LOCATION:

WELL 1 (KLAM 61330): 1820' SOUTH & 1150' WEST OF NE CORNER OF SECTION 24.

Received by OWRD

MAR 13 2024

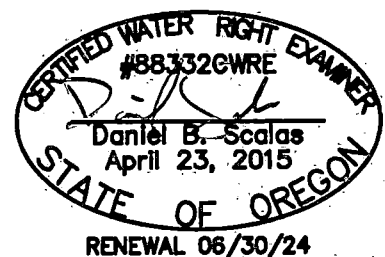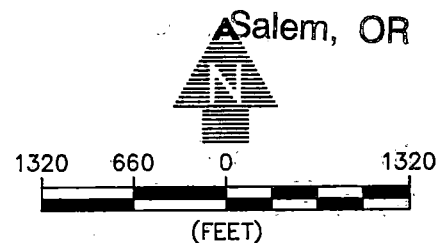

AL ADKINS o / 541.884.4666
ENGINEERING & SURVEYING w / AdkinsEngineering.com

1435 ESPLANADE AVENUE, KLAMATH FALLS, OR 97601

SERVING S. OREGON & N. CALIFORNIA

ENGINEERING • SURVEYING • PLANNING • TESTING

CLAIM OF BENEFICIAL USE MAP

FOR
GUTHRIE FARMS LLC
T40S, R9E, SEC. 24, WM
T40S, R10E, SECS. 18 & 19, WM
KLAMATH COUNTY
TRANSFER T-13501