


Section 16, T35S, R01W, WM (Jackson County)

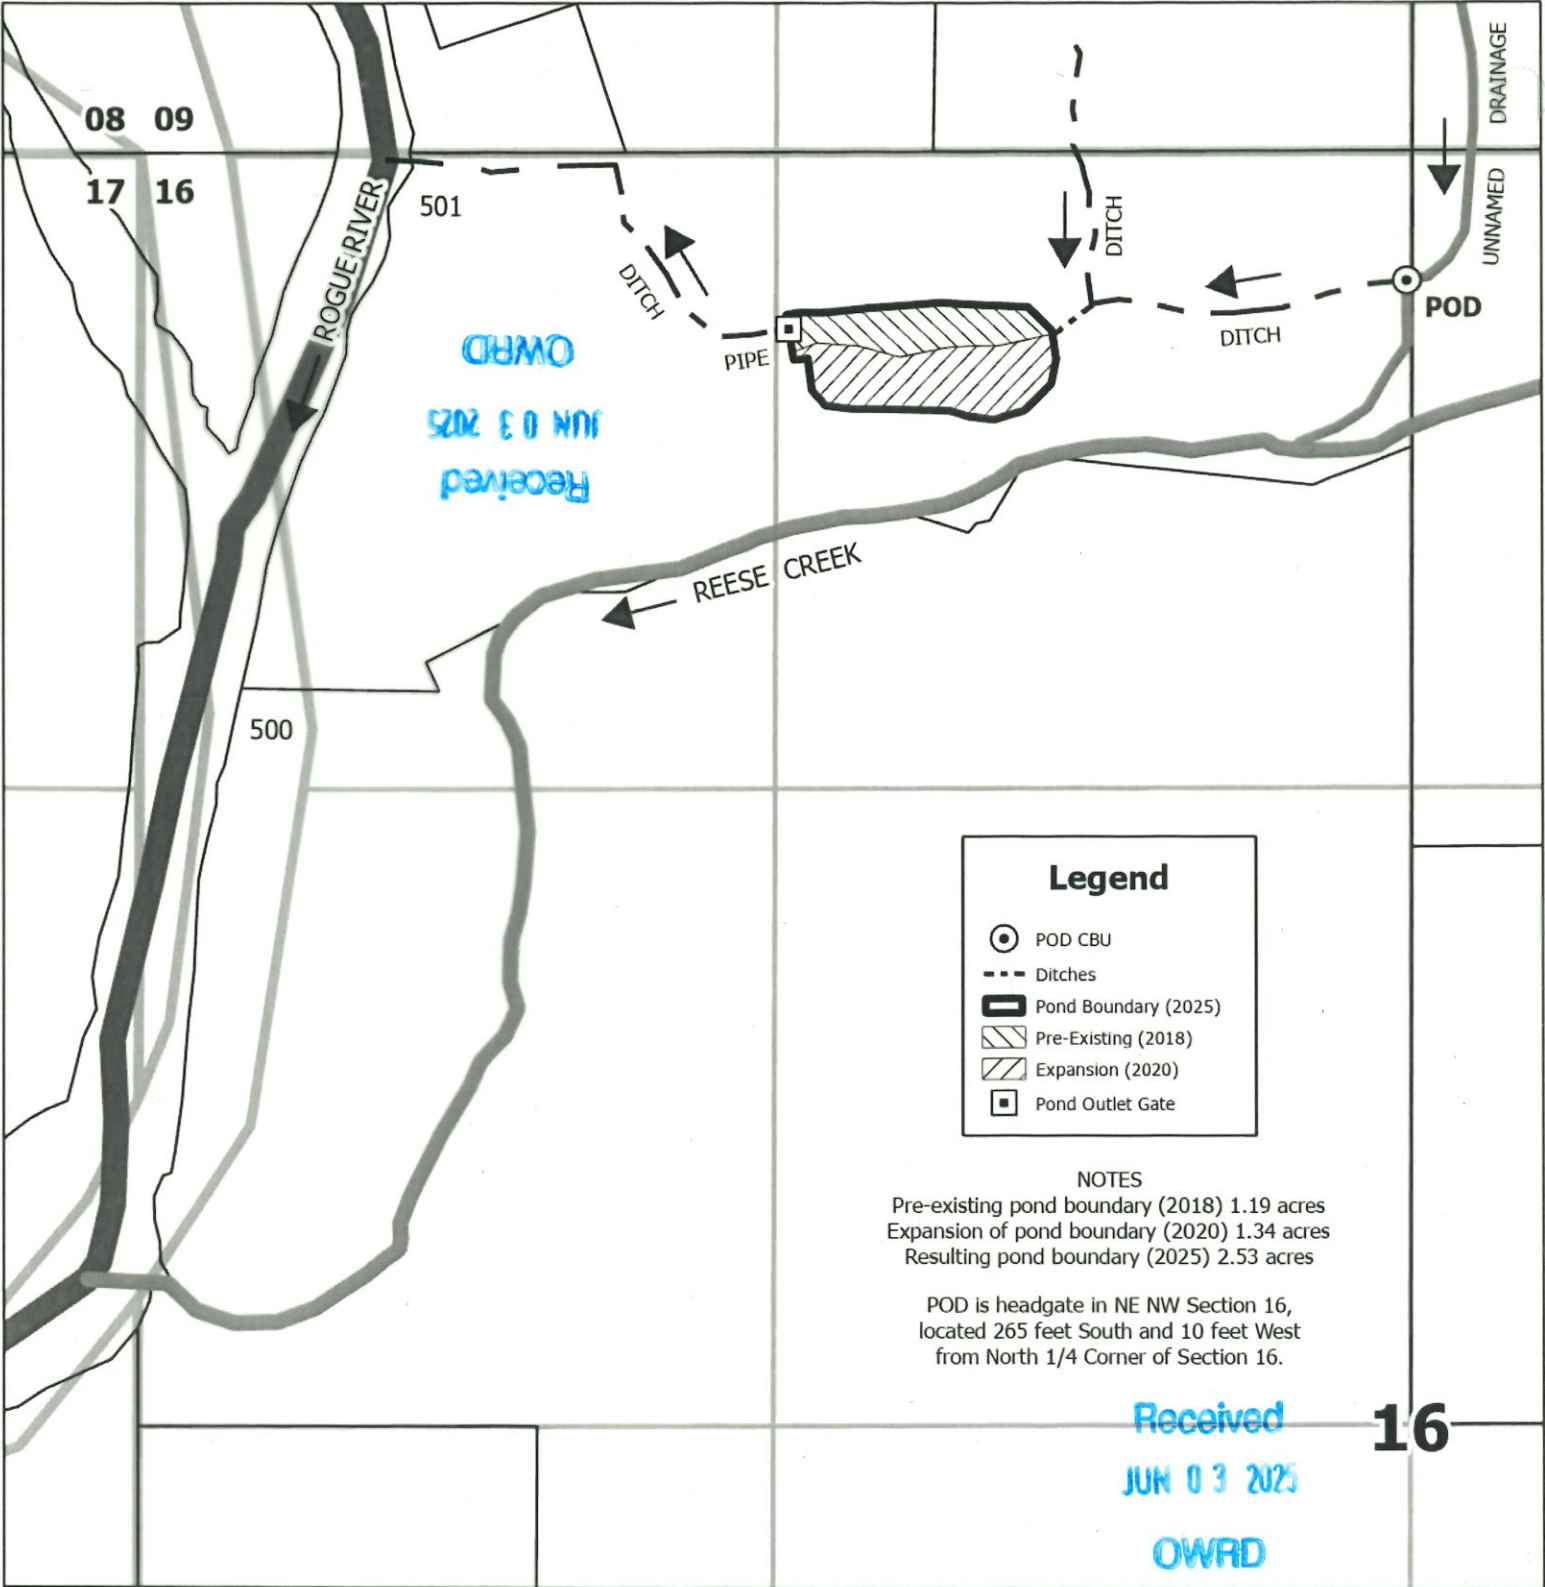

DISCLAIMER
This map is not intended
to provide legal dimensions
or locations of property
ownership lines.



0 100 200 400 US Feet
|-----|



WATERSOLVING LLC
johnw@watersolving.com
(541) 815-4103 mobile

CLAIM OF BENEFICIAL USE MAP

**APPLICATION R-88307
PERMIT R-15233**

KC PROPERTY HOLDINGS LLC

Revised 2025-04-29