


# CLAIM of BENEFICIAL USE MAP

FOR: POOPAK DOKHANCHI  
 BY: NATHAN REED, PE, CWRE  
 T26S, R4W, W.M. SECTION 13  
 APPLICATION NO. S-72929  
 PERMIT NO. S-51808



SCALE: 1" = 400'

DATE OF SURVEY: AUGUST 8, 2024

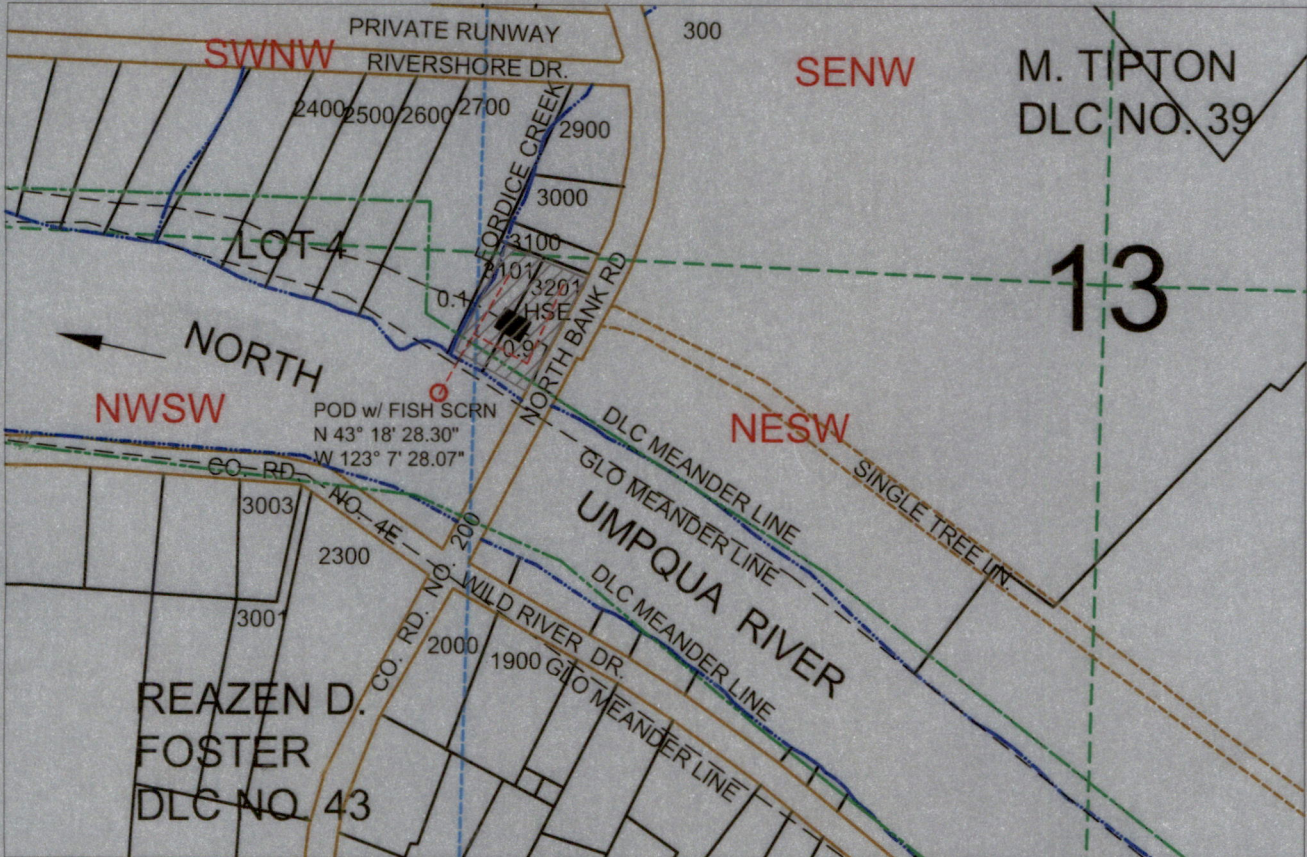








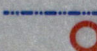


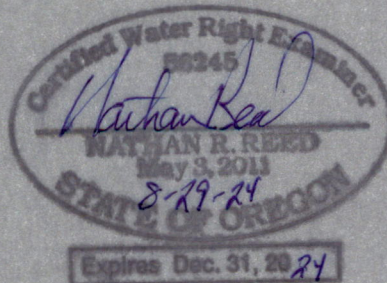
POD IS LOCATED 297 FEET SOUTH & 1380 FEET WEST OF C1/4 CORNER OF SECTION 13 .

Received  
 OCT 09 2024  
 OWRD

Received  
 SEP 09 2024  
 OWRD

**LEGEND**

-  WATER
-  POD
-  WATERLINE
-  SECTION
-  QUARTER
-  SIXTEENTH
-  DLC
-  GLOT
-  PARCEL
-  IRRIGATION AREA



MAP PREPARED FOR:  
 POOPAK DOKHANCHI  
 14341 SAN PABLO AVE  
 SAN PABLO, CA 94806

MAP PREPARED BY:  
 NATHAN REED PE, CWRE  
 157 WEST BODIE STREET  
 ROSEBURG, OR 97471

THE PURPOSE OF THIS MAP IS TO IDENTIFY THE LOCATION OF THE WATER RIGHT. IT IS NOT INTENDED TO PROVIDE INFORMATION RELATIVE TO THE LOCATION OF PROPERTY OWNERSHIP BOUNDARY LINES.