


- Meter
-  Reservoir
- Township
- Section
- Quarter Quarter
-  Tax Lot

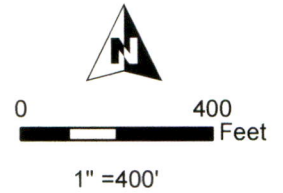


RENEWS: 06/30/2026

**T31S R15W &
T32S R 15W, WM
CURRY COUNTY, OR**



Received
OCT 24 2024
OWRD

**Center of Reservoir Location:
180' N, 1000' E of S 1/4 Cor Sec 33**

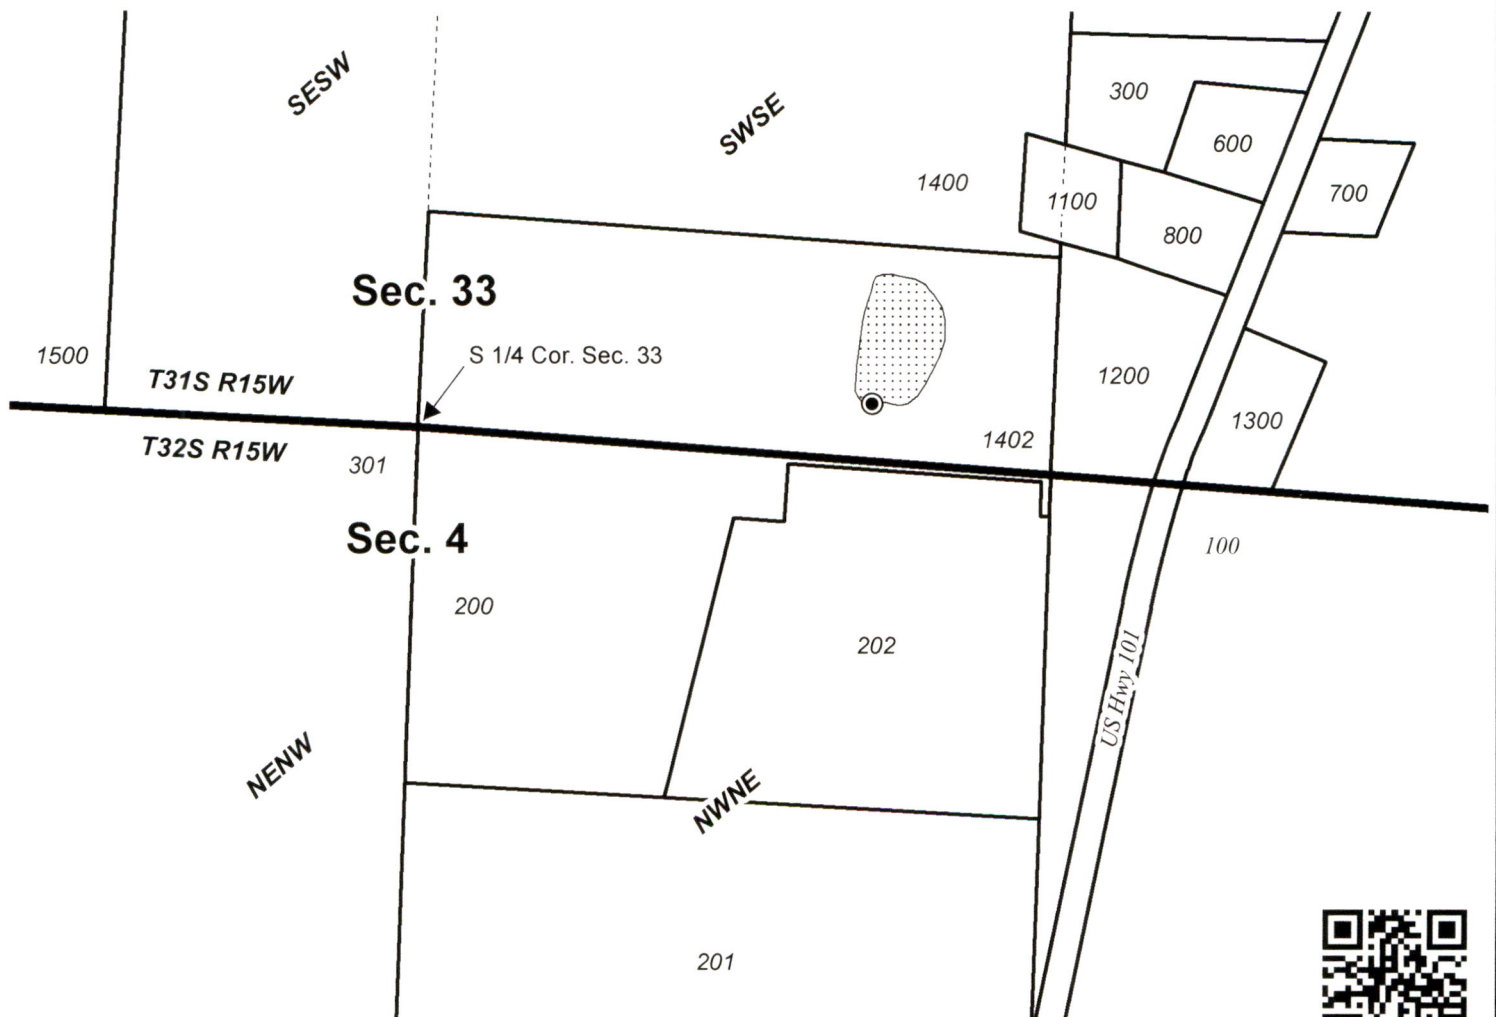

**Claim of Beneficial Use Map
LOSHBAUGH**

Ap R-86130 Permit R-14247

Date: 10/8/2024

This map is not intended
to provide legal dimensions
or locations of property
ownership lines.

WATER RIGHT SERVICES, LLC
PO BOX 1830, BEND, OR 97709
WWW.OREGONWATER.US CCB # 197121
johnshort@usa.com 541-389-2837