


**CLAIM OF BENEFICIAL USE MAP
FOR: MELVIN A. & CAROL M. JAMES
BY: NATHAN R. REED
T28S, R5W, W.M. SECTION 22 & 23
TRANSFER NO. 11304**

DATE SURVEYED: JULY 19, 2014

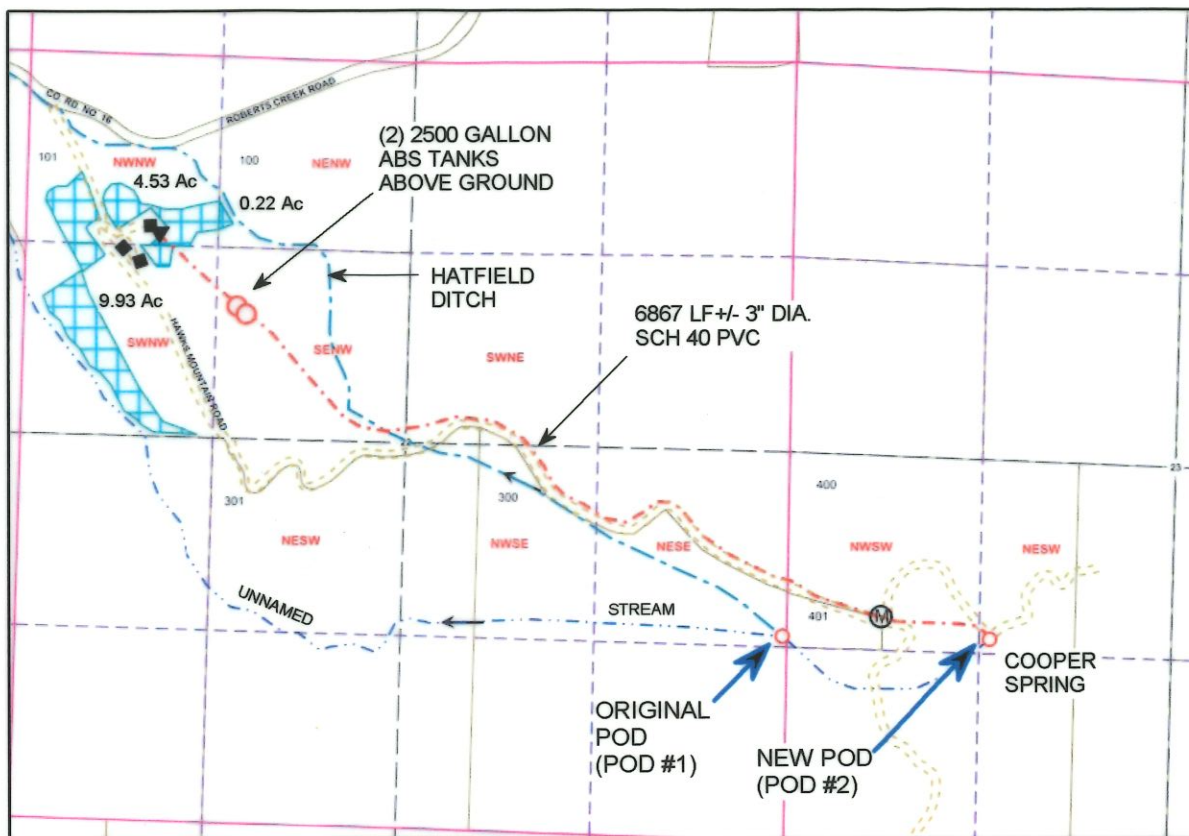

Scale: 1" = 1320'



SALEM, OR

JUL 31 2014


RECEIVED BY OWRD

OLD POD OF RECORD IS LOCATED 20 FEET WEST AND 1,280 FEET SOUTH OF THE WEST 1/4 CORNER OF SECTION 23.
NEW POD IS LOCATED 1380 FEET EAST AND 1260 FEET SOUTH OF THE WEST 1/4 CORNER OF SECTION 23.

Legend

■	Structure	---	Pipeline	→	Flow_arrow
○	Water_tank		Irrigation Area		Section
○	POD	---	Stream	---	Quarter
Ⓜ	Meter	---	Roads	---	Sixteenth
▼	Flow Restrictor	---	Ditch Line		Parcels

MAP PREPARED FOR:
MELVIN & CAROL JAMES
6385 ROBERTS CREEK ROAD
ROSEBURG, OR 97470

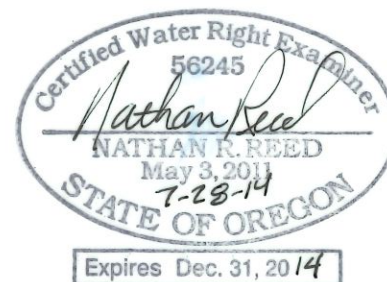

THE PURPOSE OF THIS MAP IS TO IDENTIFY THE LOCATION OF THE WATER RIGHT. IT IS NOT INTENDED TO PROVIDE INFORMATION RELATIVE TO THE LOCATION OF PROPERTY OWNERSHIP BOUNDARY LINES.

MAP PREPARED BY:
NATHAN REED, P.E., CWRE
1113 SE CASS AVE
ROSEBURG, OR 97470