


# T.3S. R.2W. Section 22, W.M.

**RECEIVED**

APR 27 2015

WATER RESOURCES DEPT  
SALEM, OREGON

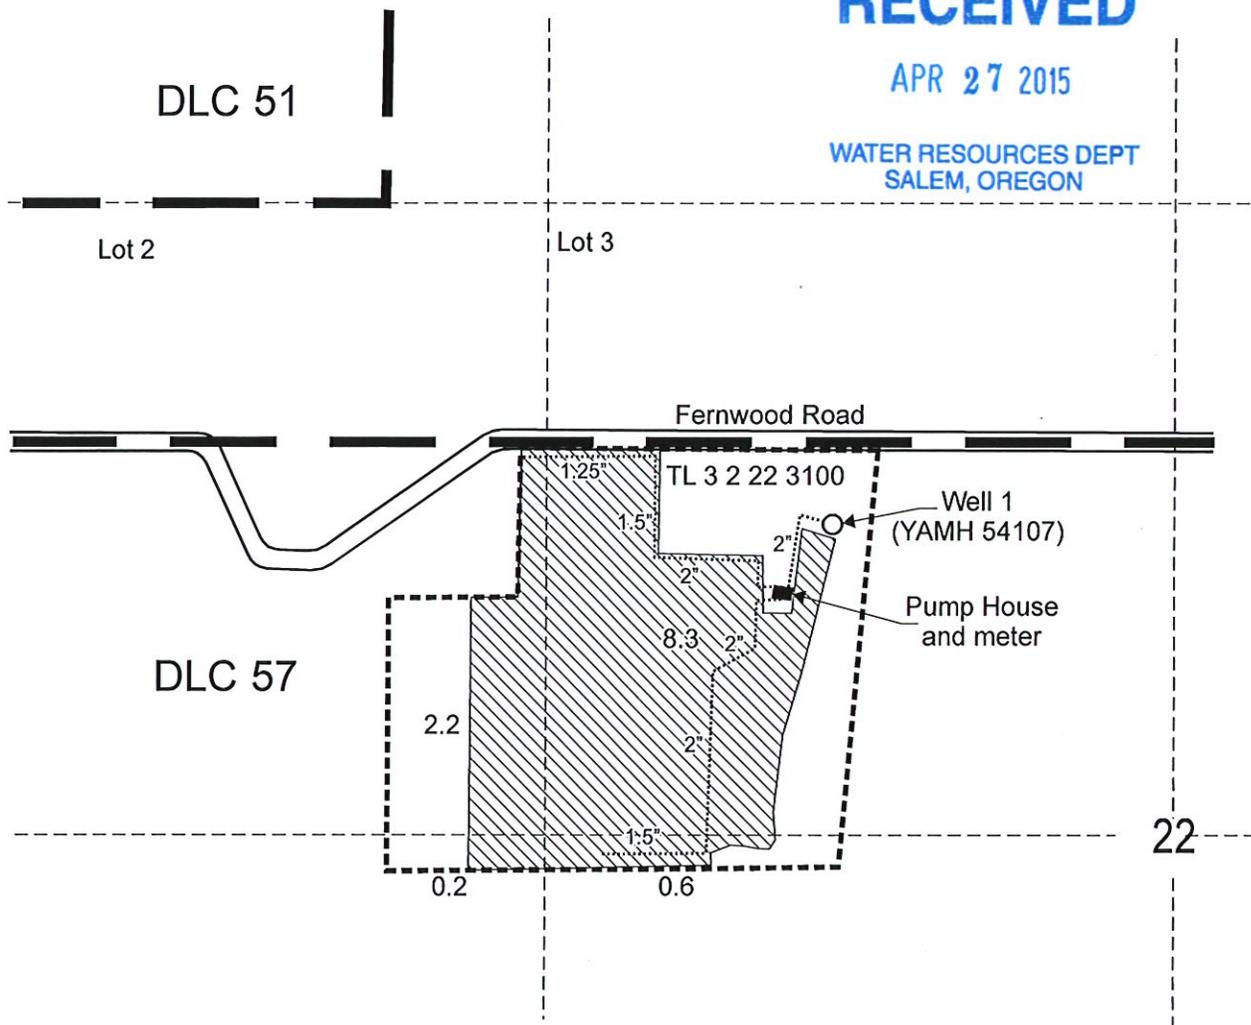

Well 1 is located 650 feet south and 970 feet east from the SE corner, DLC 51.

 Area (11.3 acres) irrigated under Application G-17244, Permit G-16656.

 Tax lot boundary


 Donation Land Claim

 Irrigation mainline, buried



RENEWS June 30 2015

Scale: 1" = 400'

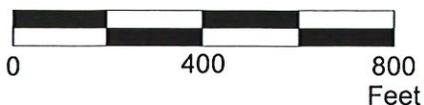

This map was prepared for the purpose of identifying the location of a water right only and is not intended to provide legal dimensions or location of property ownership lines.

Claim of Beneficial Use Map  
Application G-17244, Permit G-16656

James Dennis Pierce  
T.3S. R.2W. Section 22, W.M.

Pacific Hydro-Geology Inc.

02/2015 rev 03/30/2015