LOCATION DESCRIPTION

POD (Cert. 25327)
Located 550 feet South and 840 feet West from the E ¼ corner of Section 26, Township 8 South, Range 19 East (W.M.)

POD (Cert. 55361)
Located 1,340 feet North and 1,240 feet West from the E ¼ corner of Section 26, Township 8 South, Range 19 East (W.M.)

POD (Cert. 67096)
Located 1,340 feet South and 1,240 feet West from the NE corner of Section 26, Township 8 South, Range 19 East (W.M.)

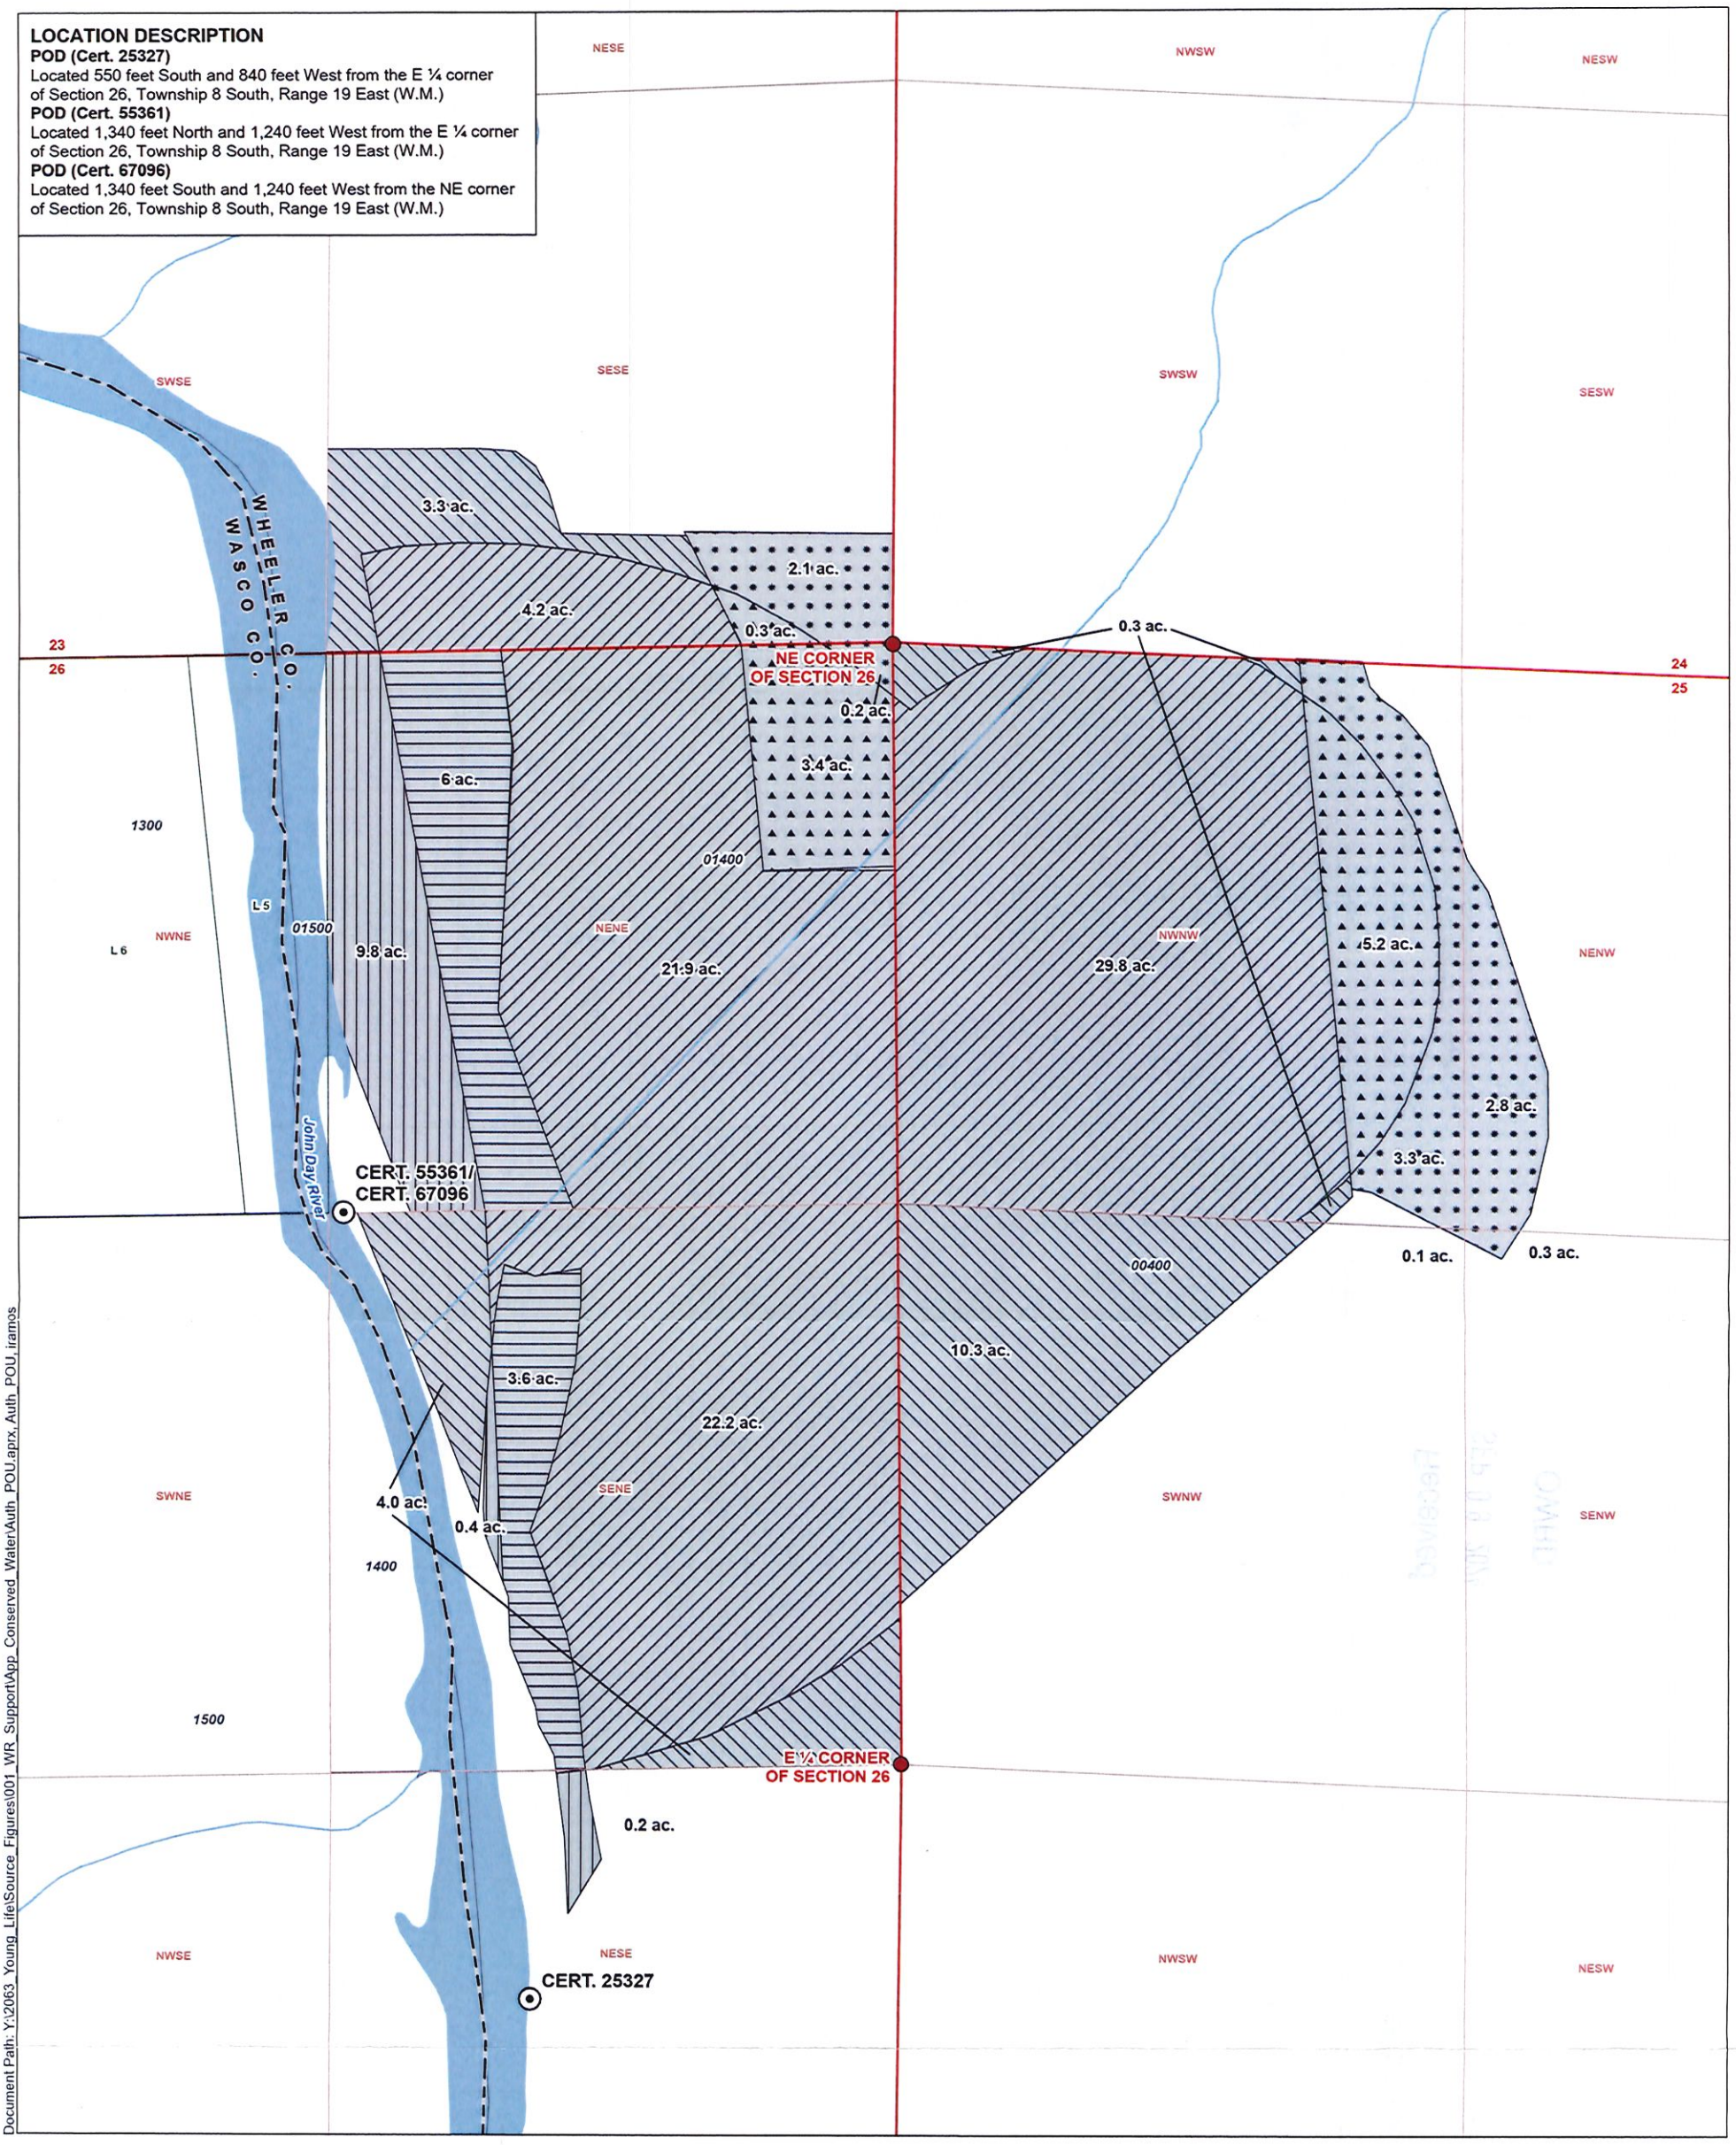

Document Path: Y:\2063_Young_Life\Source_Figures\001_WR_Support\App_Conserved_Water\Auth_POU.aprx, Auth_POU_iramos

LEGEND

Authorized Point of Diversion

Authorized Place of Use, Certificate 25327

Included in the Allocation of Conserved Water

Not Included in the Allocation of Conserved Water

Authorized Place of Use, Certificate 55361

Included in the Allocation of Conserved Water

Not Included in the Allocation of Conserved Water

Authorized Place of Use, Certificate 67096

Included in the Allocation of Conserved Water

Not Included in the Allocation of Conserved Water

All Other Features

Tax Lot

Government Lot (GL)

County Boundary

Watercourse

Application for an Allocation of Conserved Water Certificates 25327, 55361, and 67096

Authorized Place of Use Map

Township 8 South, Range 19 East (W.M.)

Received
SEP 09 2024
OWRD

DISCLAIMER
This map was prepared for the purpose of identifying the location of a water right only and it is not intended to provide legal dimensions or location of property ownership lines.
Date: July 2, 2024
Data Sources: BLM, ESRI, OWRD, USGS

N

0 200 400 600
1 INCH = 400 FEET

GSI Water Solutions, Inc.

P-44743
67089
67108
67096

T.8S., R.19E., W.M.

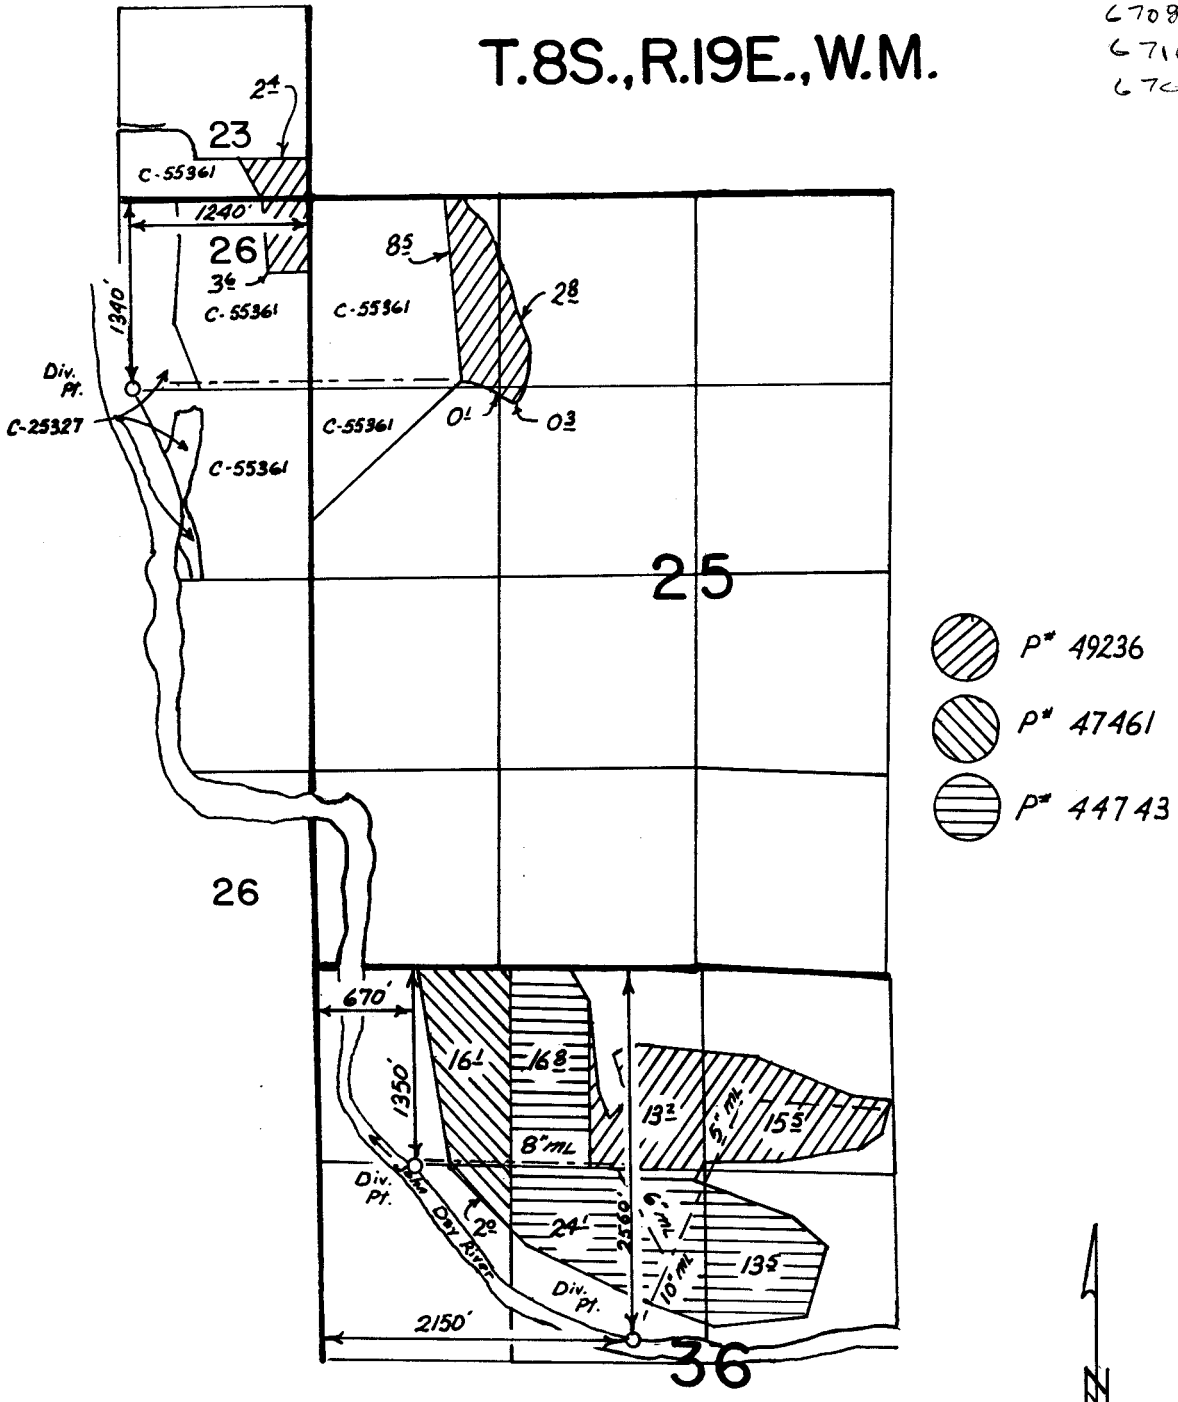

Scale: 1" = 1320'

FINAL PROOF SURVEY

UNDER

59731 44743
64970 47461

Application No. 68246 Permit No. 49236

IN NAME OF

OREGON DEPARTMENT OF TRANSPORTATION
BILLY M. CROSS

Surveyed 1-31 19 91, by K. Kemp

PTS # 41065-179-213R 3/91 KK