


Township 3 South, Range 26 East, W.M.
Sections 11, 12, and 14
Morrow County

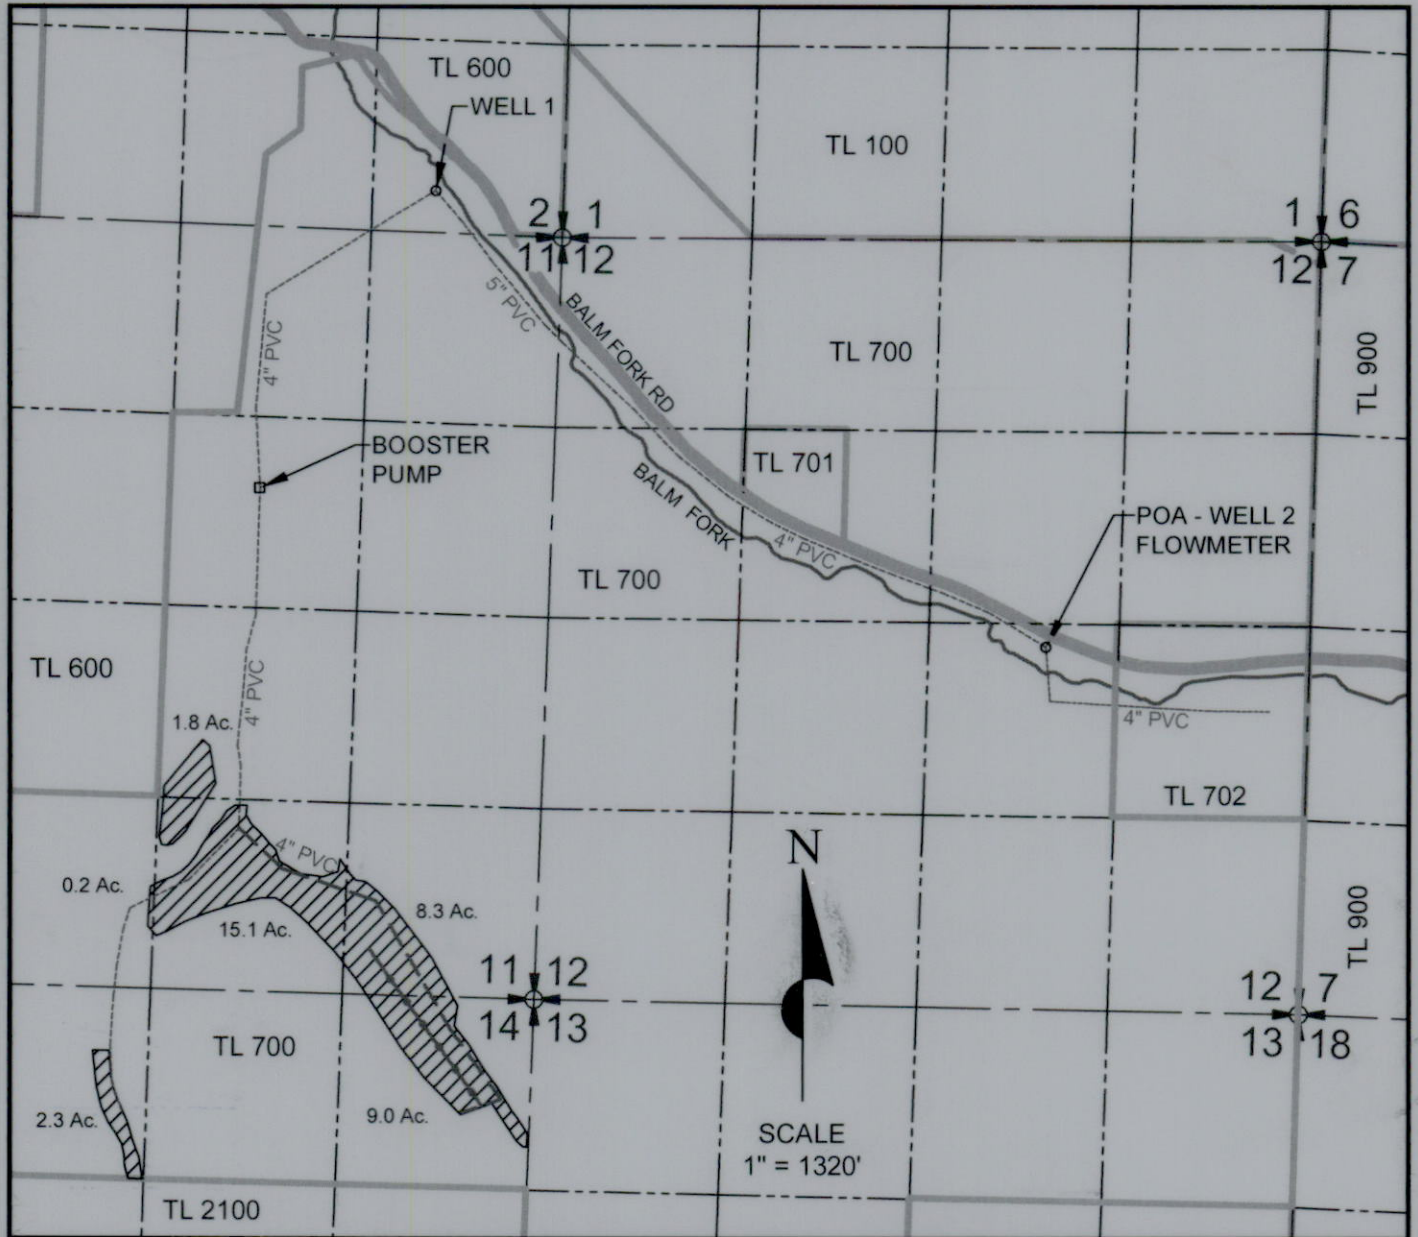


LEGEND

- SECTIONS
- - - QTR-QTR SECTIONS
- TAX LOTS
- - - BURIED PIPELINES (NEW)
- - - BURIED PIPELINES (EXISTING)
- - - PORTABLE LINES
- WELLS
- BOOSTER PUMP
- ▨ 36.7 ACRES IRRIGATED

POA - WELL 2 LOCATION: TOWNSHIP 3 SOUTH, RANGE 26 EAST,
SECTION 12; 2790 FEET SOUTH AND 3430 FEET EAST FROM NW
CORNER OF SECTION 12.

COBU Map
in name of
ALBERT L. OSMIN
2022

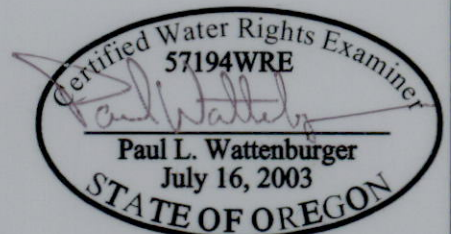

THIS MAP WAS PREPARED FOR THE PURPOSE OF
LOCATING A WATER RIGHT ONLY AND DOES NOT
SHOW LEGAL DIMENSIONS OR LOCATION OF PROPERTY

RECEIVED

AUG 26 2022

OWRD

EXPIRES: 6/30/24