



**Claim of Beneficial Use Map -  
Points of Appropriation  
Avion Water Company, Inc.**

**Application G-18608,  
Permit G-18198**

**Township 14 South,  
Range 11 East (W.M.)**

*Received*

*MAY 30 2025*

**OWRD**

*RECEIVED*

*MAY 01 2025*

*OKED*

**LEGEND**

- Point of Appropriation (POA)
- △ Reservoir
- Meter
- Pipeline
- ▨ Place of Use (POU)
- All Other Features
- Tax Lot
- Government Lot (GL)
- ~~~~ Watercourse

**LOCATION DESCRIPTION**

**Well 1**

Located 1,120 feet North and 650 feet East from the SW corner of Section 17, Township 14 South, Range 11 East (W.M.)


**Well 2**

Located 950 feet North and 695 feet East from the SW corner of Section 17, Township 14 South, Range 11 East (W.M.)

**Well 3**


Located 925 feet North and 630 feet East from the SW corner of Section 17, Township 14 South, Range 11 East (W.M.)

**CERTIFIED WATER RIGHTS EXAMINER STAMP**

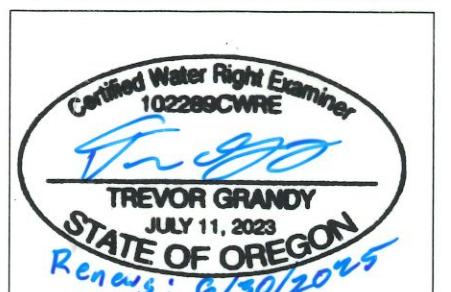


**DISCLAIMER**

This map was prepared for the purpose of identifying the location of a water right only and it is not intended to provide legal dimensions or location of property ownership lines.

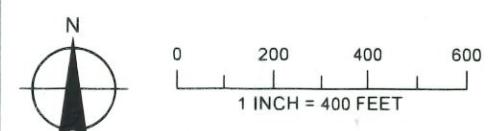

Date: April 16, 2025  
Data Sources: BLM, ESRI, ODOT, USGS, Imagery (2022)



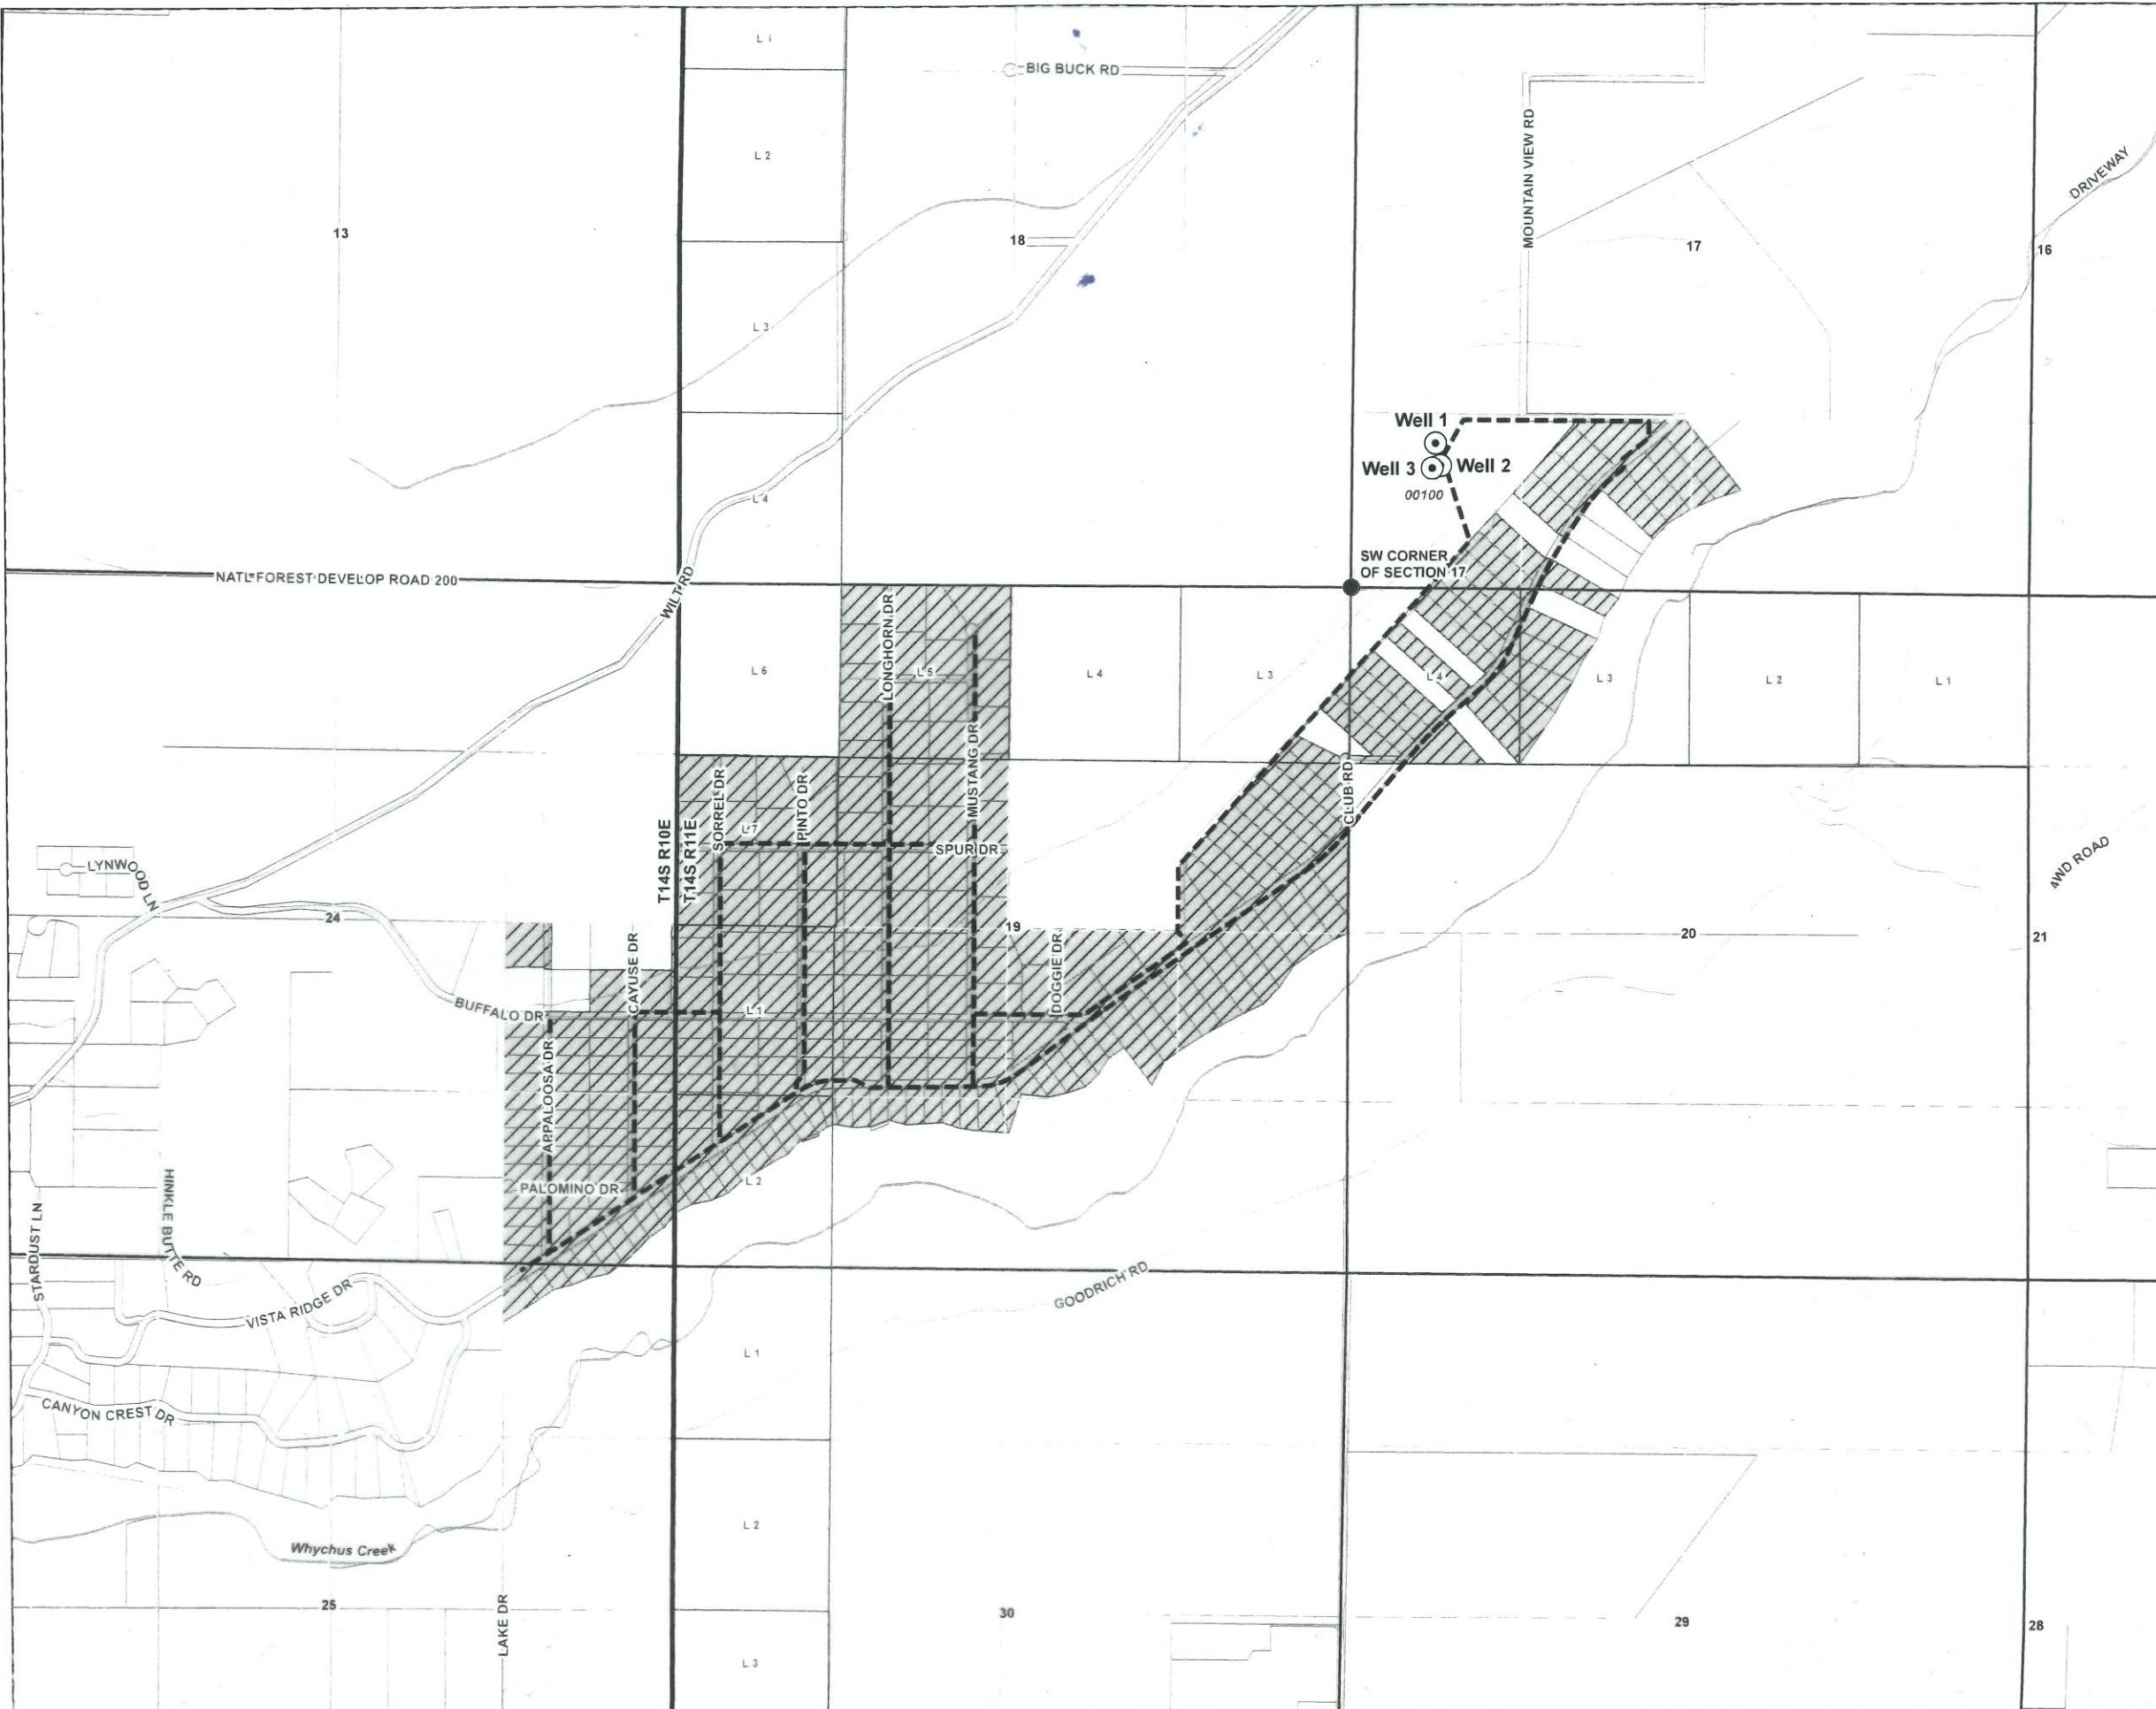

Document Path: Y:\0238\_Avion\_Water\_Co\Source\_Figures\001\_WR\_Regulatory\COBU\_G18608\_G18198.aprx, COBU\_G18608\_G18198\_bramos

**Claim of Beneficial Use Map  
Avion Water Company, Inc.**

**Application G-18608,  
Permit G-18198**

**Township 14 South,  
Range 10/11 East (W.M.)**

**Received  
MAY 30 2025**


**Received  
MAY 01 2025**


**LEGEND**

- Point of Appropriation (POA)
- Pipeline
- ▨ Place of Use (POU)
- All Other Features
- Tax Lot
- Government Lot (GL)
- 曲线 Watercourse

**LOCATION DESCRIPTION**

**Well 1**

Located 1,120 feet North and 650 feet East from the SW corner of Section 17, Township 14 South, Range 11 East (W.M.)

**Well 2**

Located 950 feet North and 695 feet East from the SW corner of Section 17, Township 14 South, Range 11 East (W.M.)

**Well 3**


Located 925 feet North and 630 feet East from the SW corner of Section 17, Township 14 South, Range 11 East (W.M.)

**CERTIFIED WATER RIGHTS EXAMINER STAMP**



**DISCLAIMER**

This map was prepared for the purpose of identifying the location of a water right only and it is not intended to provide legal dimensions or location of property ownership lines.

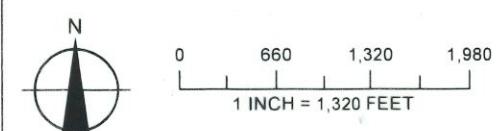

Date: April 16, 2025  
Data Sources: BLM, ESRI, ODOT, USGS, Imagery (2022)

