


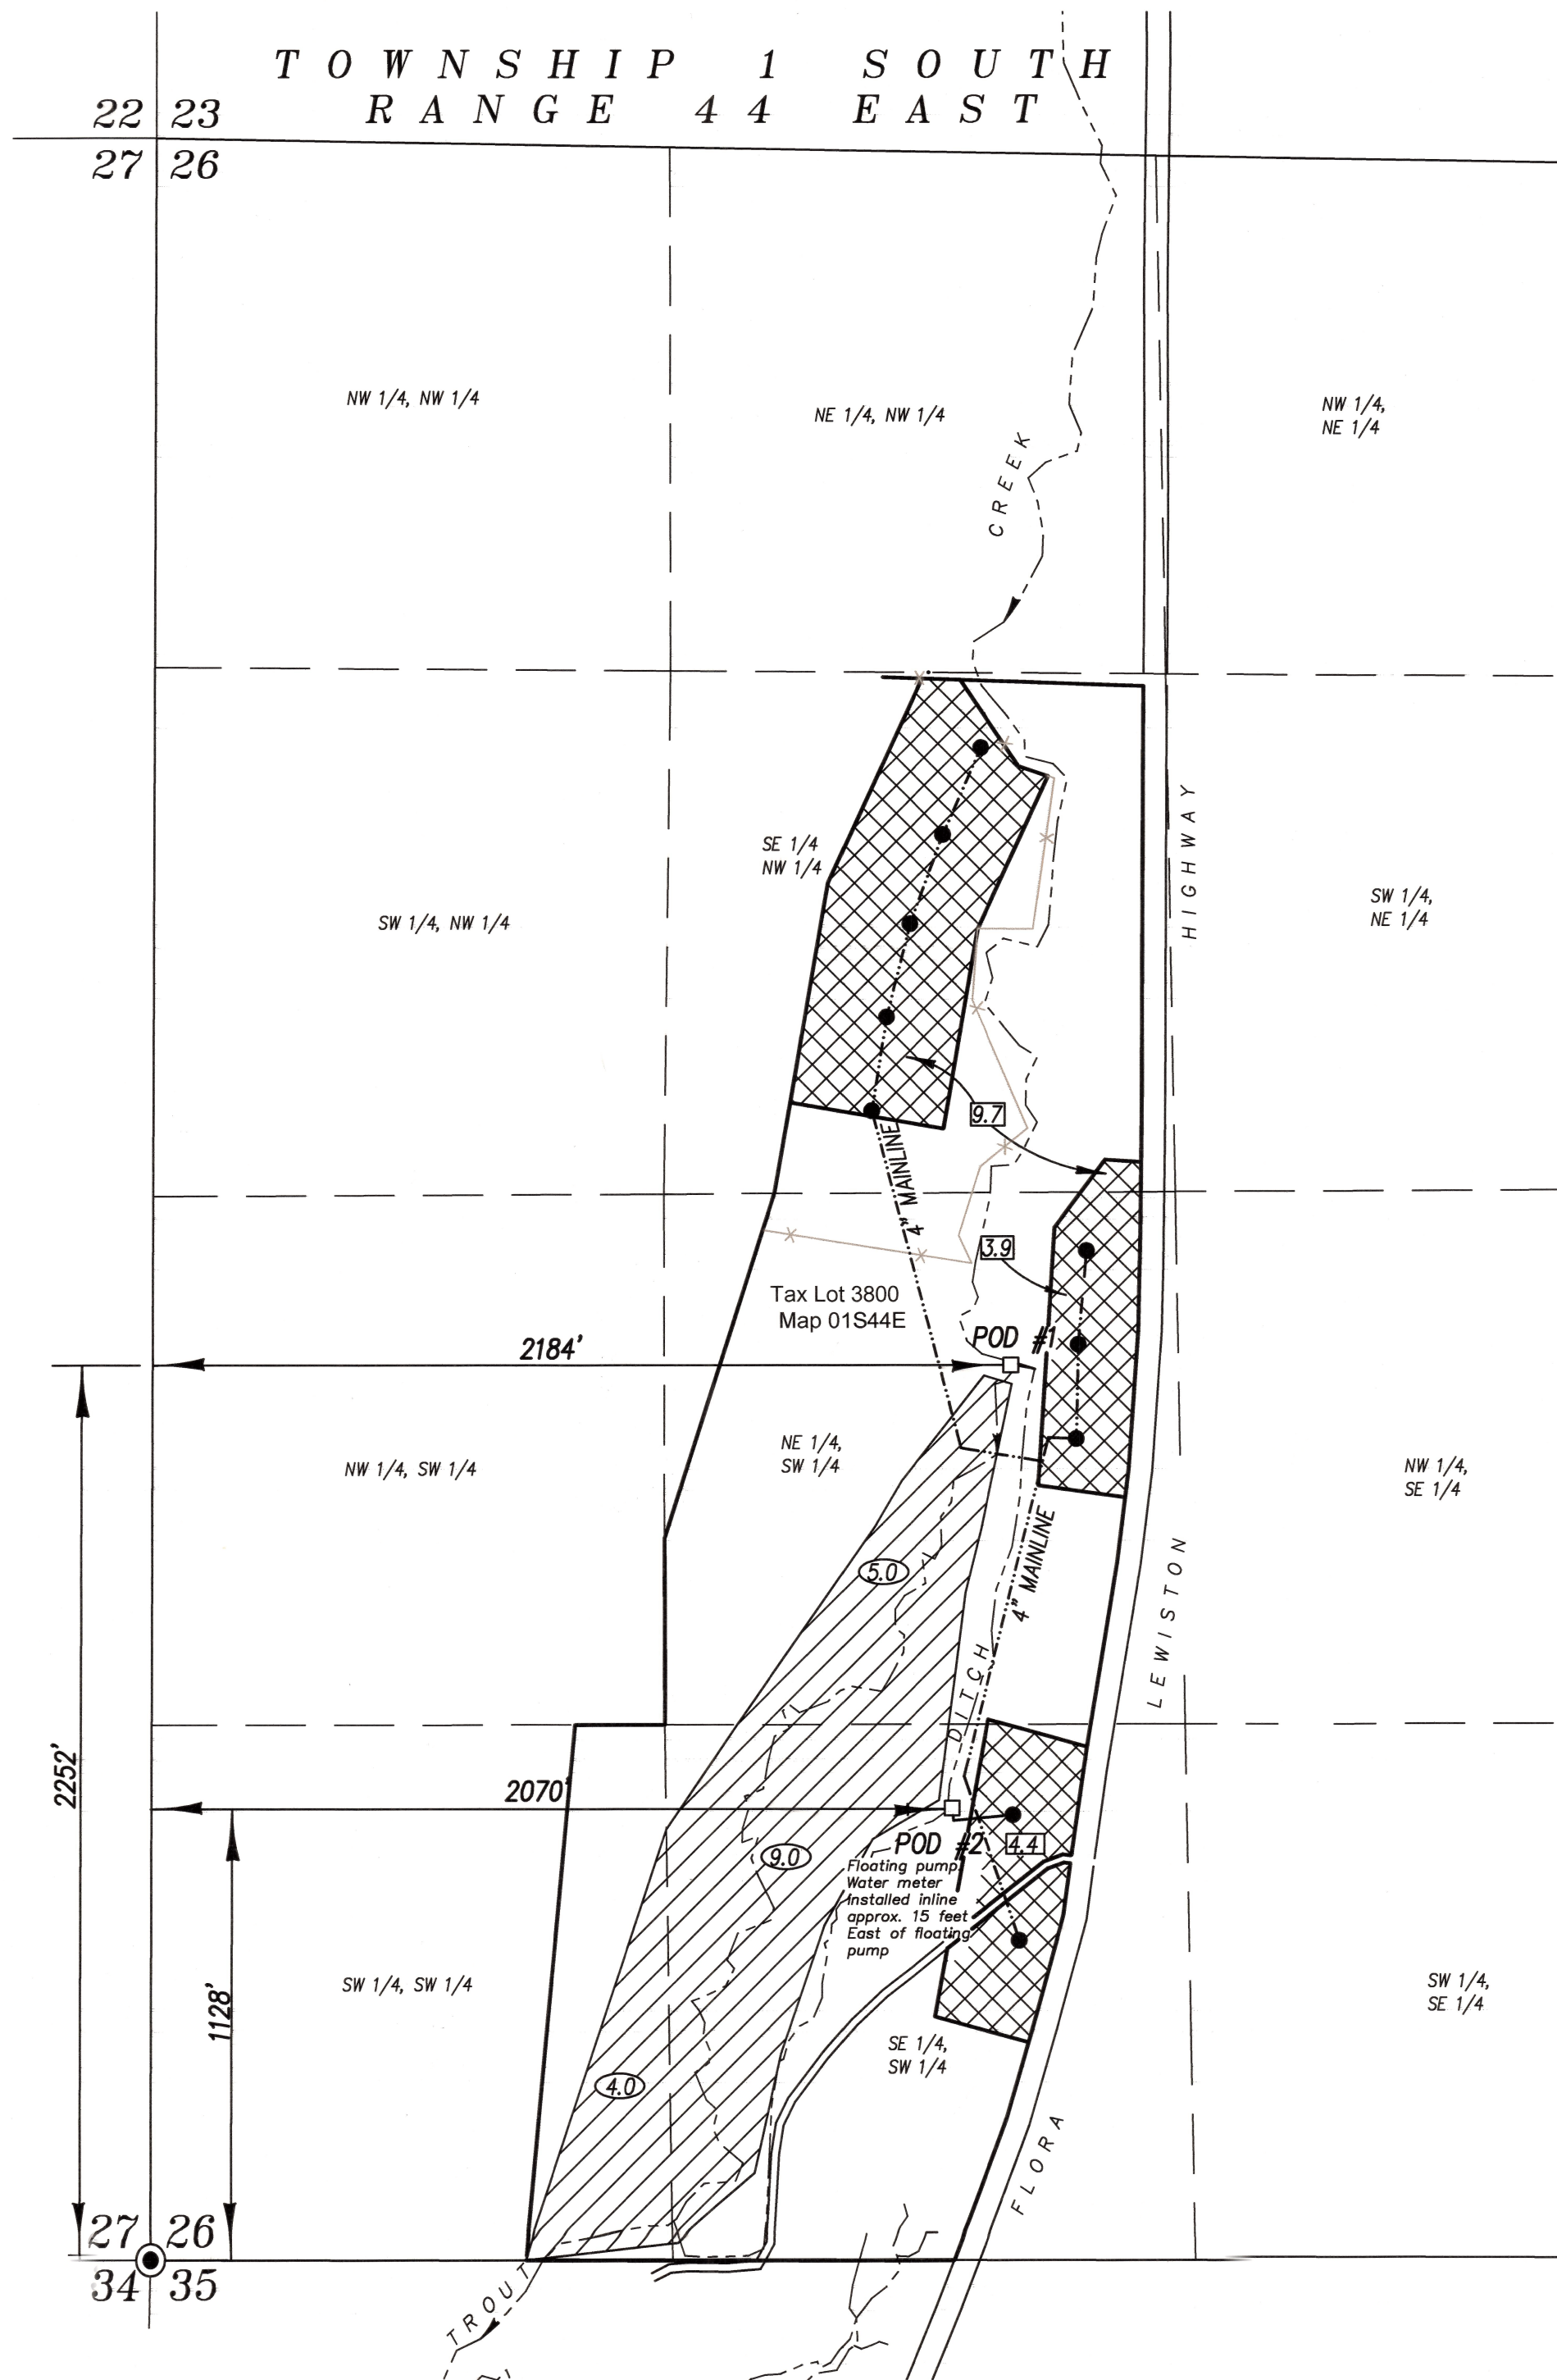

August 12, 2024
**FINAL PROOF FOR CHANGE
 OF A PLACE OF USE
 for
 STANGEL INDUSTRIES**

PREPARED BY
 BAGETT GRIFFITH AND BLACKMAN
 2006 ADAMS AVE.
 LA GRANDE, OR 97850

SCALE: 1"=400'

LEGEND

- Lands with primary rights under Certificate #3821 (priority date July 17, 1922) to be transferred
- Lands to receive water rights from Certificate #3821
- Point of Diversion
- Mainline
- Creek
- Survey Monument of record
- Irrigation Riser
- Area of rights to be transferred
- Area receiving rights



NOTE: The preparation of this map was for the purpose of identifying the location of the proposed water right and has no intent to provide dimensions or location of property ownership lines. Location information shown hereon was furnished by the applicant.

Application No. T-12654
 Permit Number 108-1004

Received
 AUG 29 2024
 OWRD

COBU MAP # 2116