


T.7S. R.1E. Section 10, W.M.

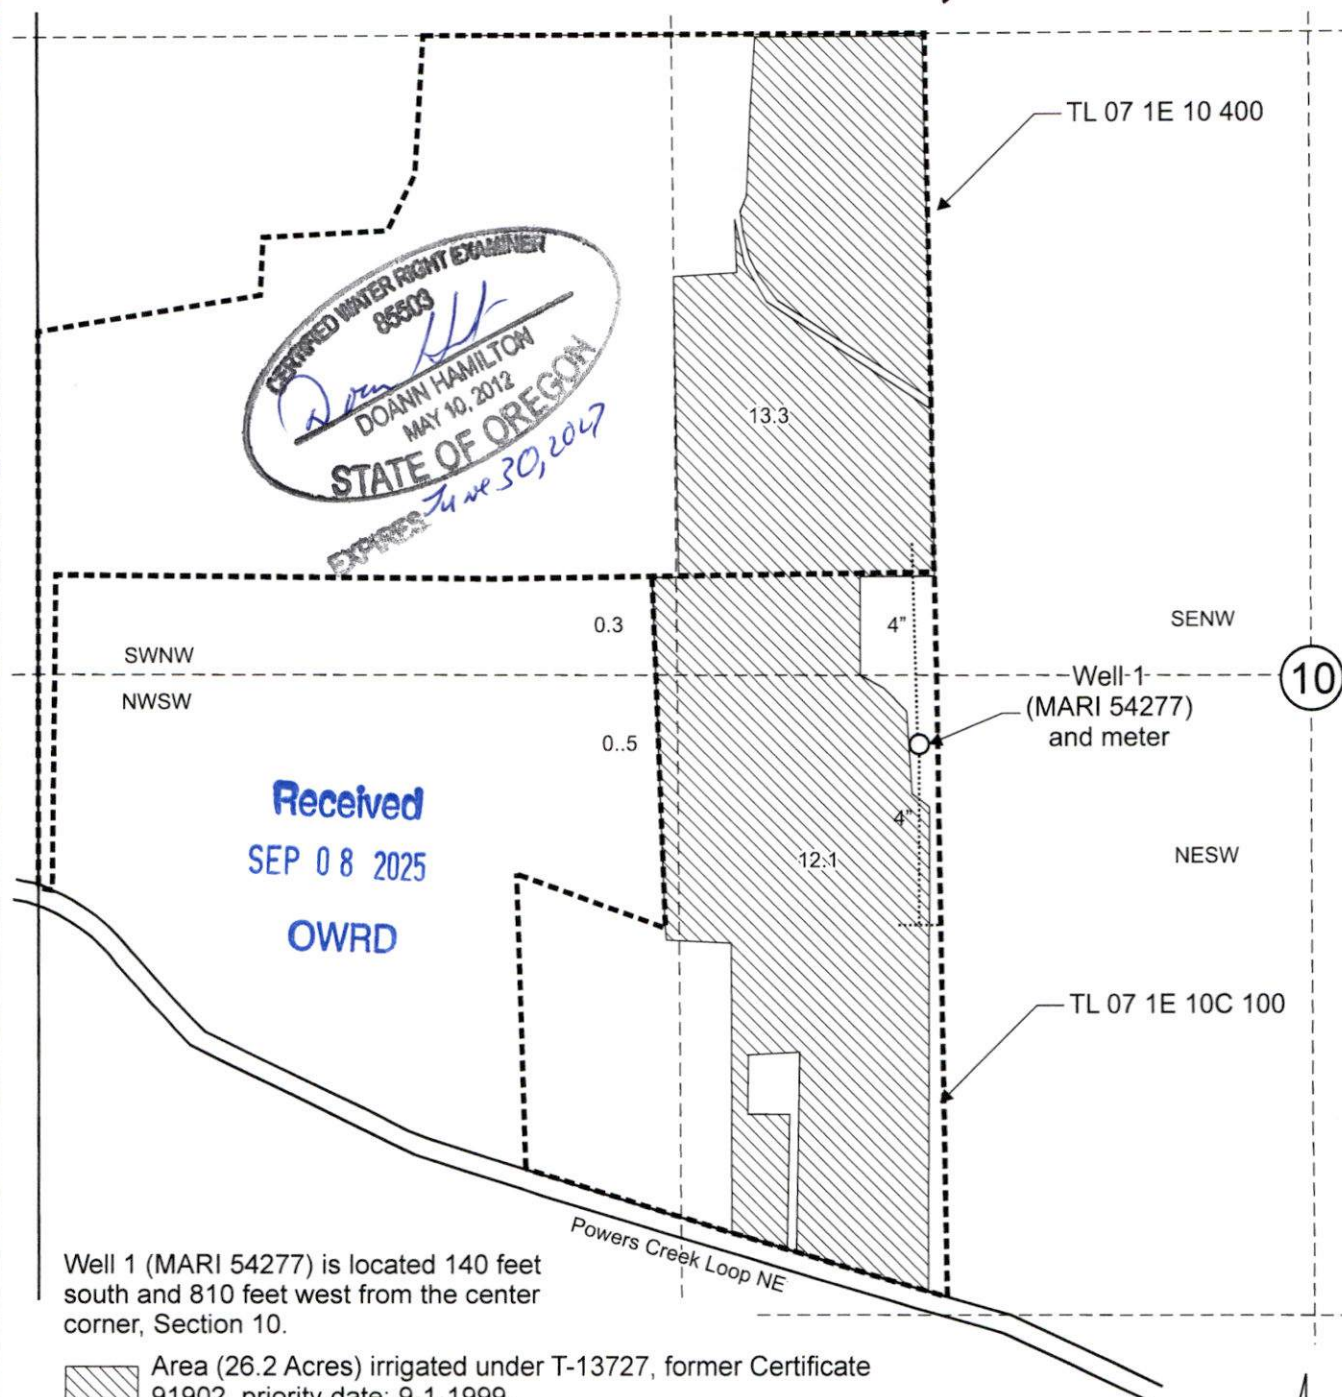

Claim of Beneficial Use Map T-13727, formerly Certificate 91902

Jan and Cynthia Hupp
T.7S. R.1E. Section 10, W.M.

Pacific Hydro-Geology Inc.

09/2025