


Transfer Application - McKee - Certificate 23923

Township 9S, Range 5W, Section 16, W.M.

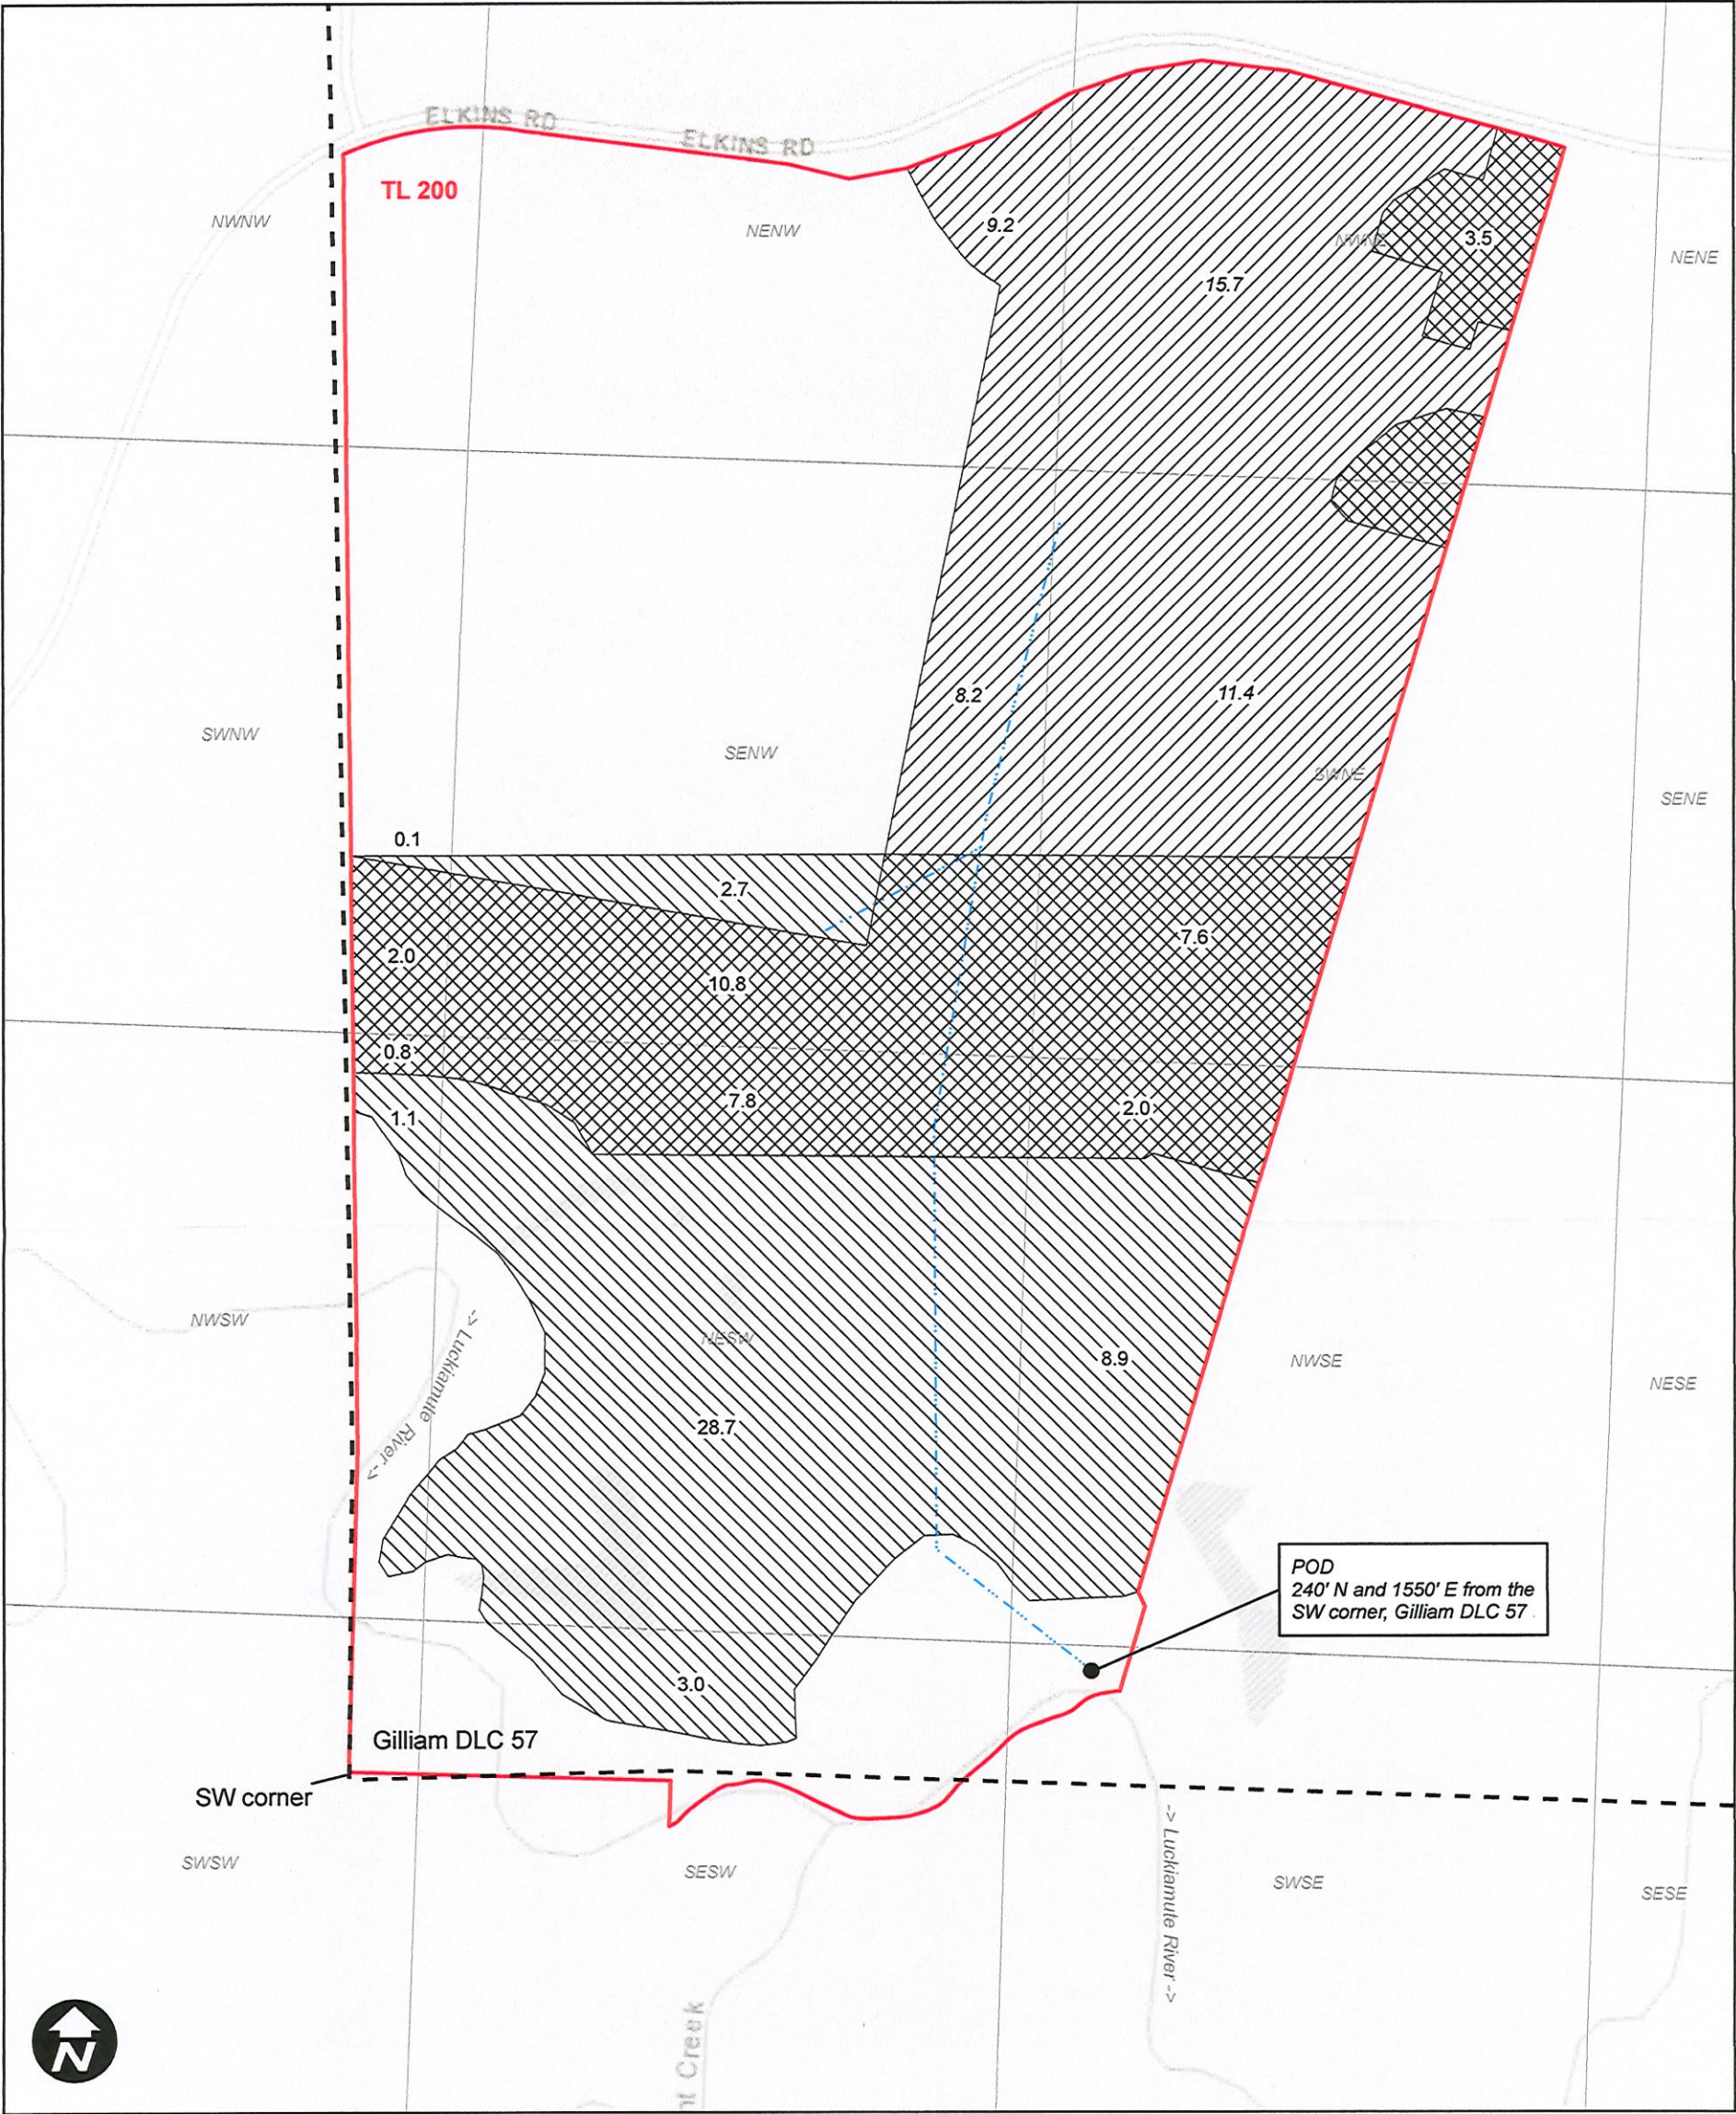


Legend

-  Cert. 23923 From
-  Cert. 23923 No Change
-  Cert. 23923 To
-  DLC
-  Taxlot
-  Mainline

0 200 400 800 Feet



T. 9 S. R. 5 W. W. M.

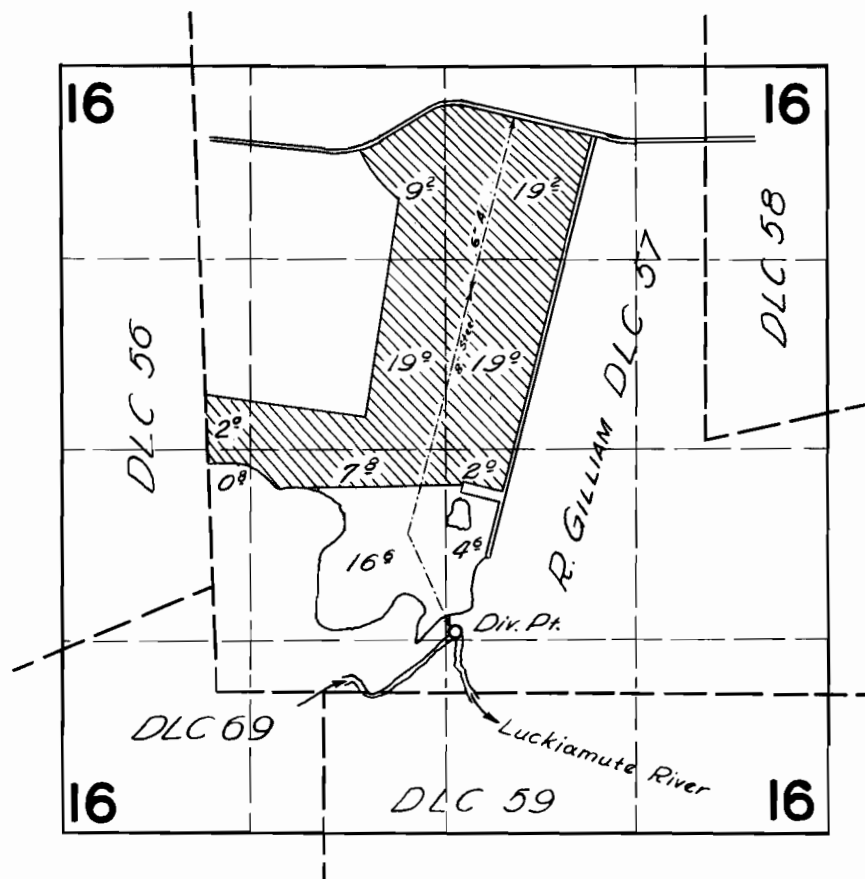

FINAL PROOF SURVEY

UNDER

Application No. 28882 Permit No. 22749

IN NAME OF

IVAN H. LOUGHARY

Surveyed 16 Aug 1956, by [Signature]