



Transfer Application - McKee - Certificate 32589

Township 9S, Range 5W, Section 16, W.M.

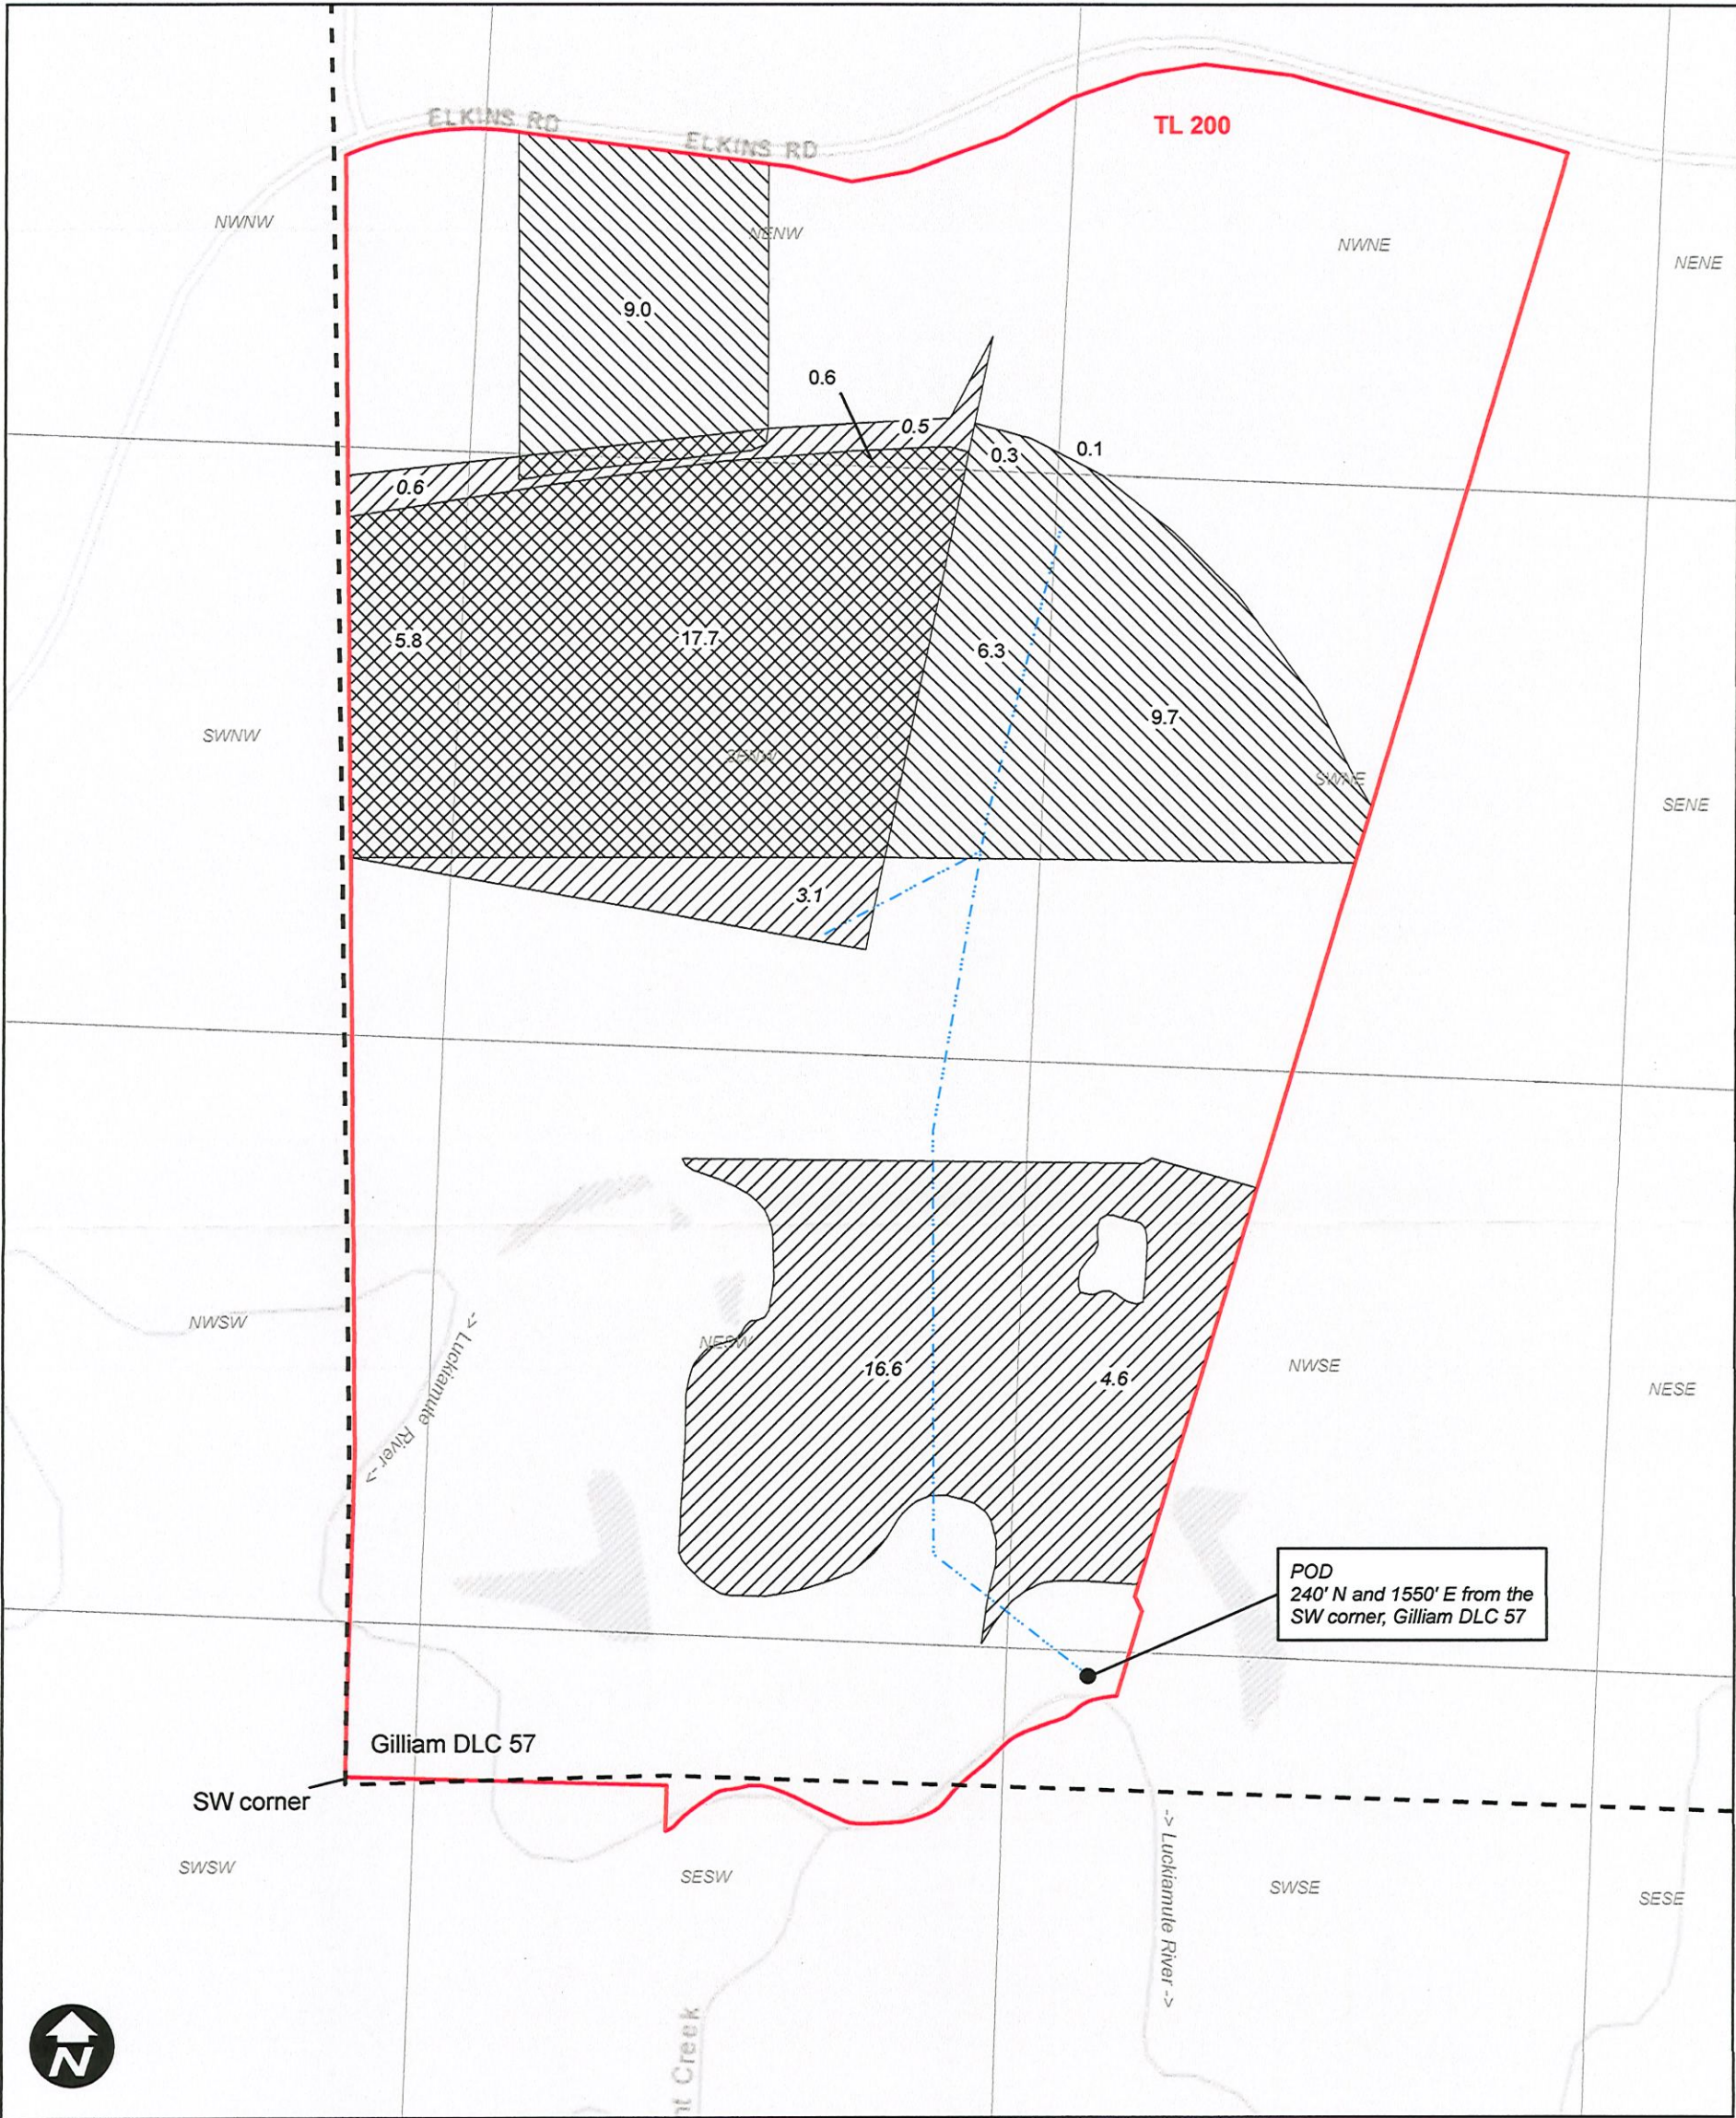


Legend

- Cert. 32589 From
- Cert. 32589 No Change
- Cert. 32589 To
- DLC
- Taxlot
- Mainline

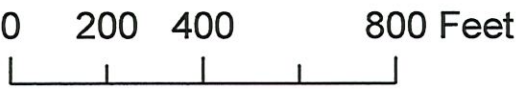

T.9S.R.5W.W.M.

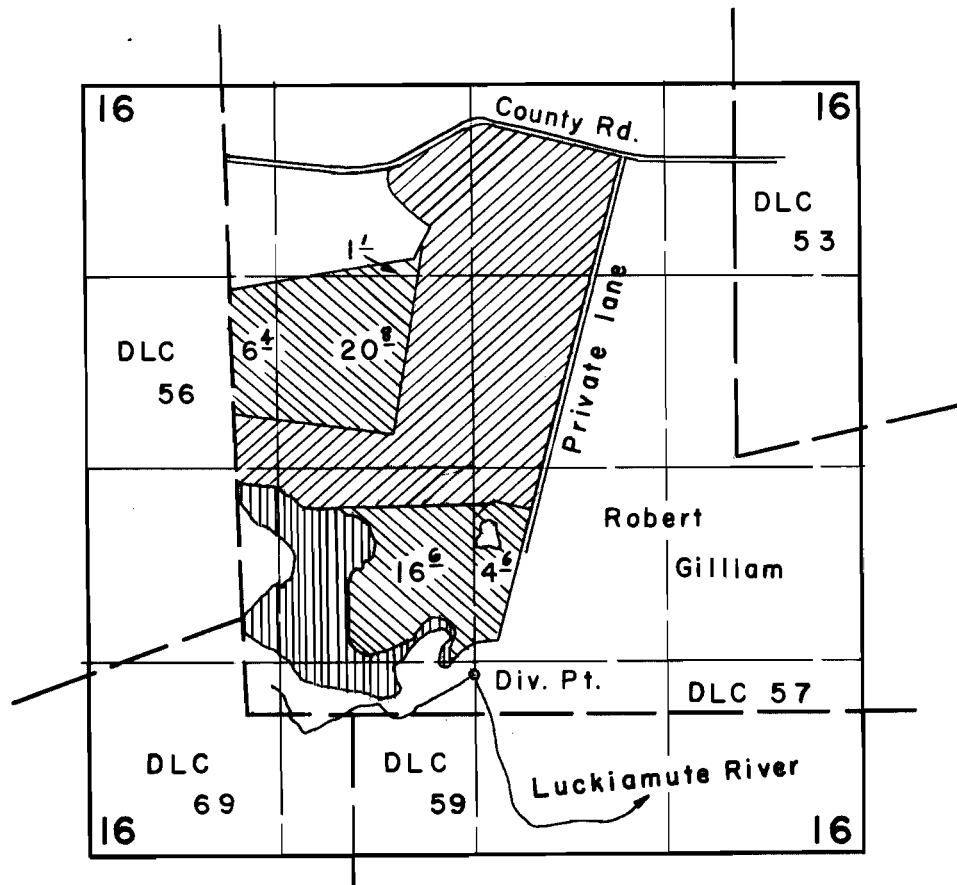

Permit No. 22749



Permit No. 28464



Irrigated but no permit

FINAL PROOF SURVEY
UNDER

Application No. 38196... Permit No. 28464...
IN NAME OF

..... Ivan H. Loughary

Surveyed Sept. 23 1964, by C.J. Gardner.....