



Transfer Application - McKee - Certificate 45701

Township 9S, Range 5W, Section 16, W.M.

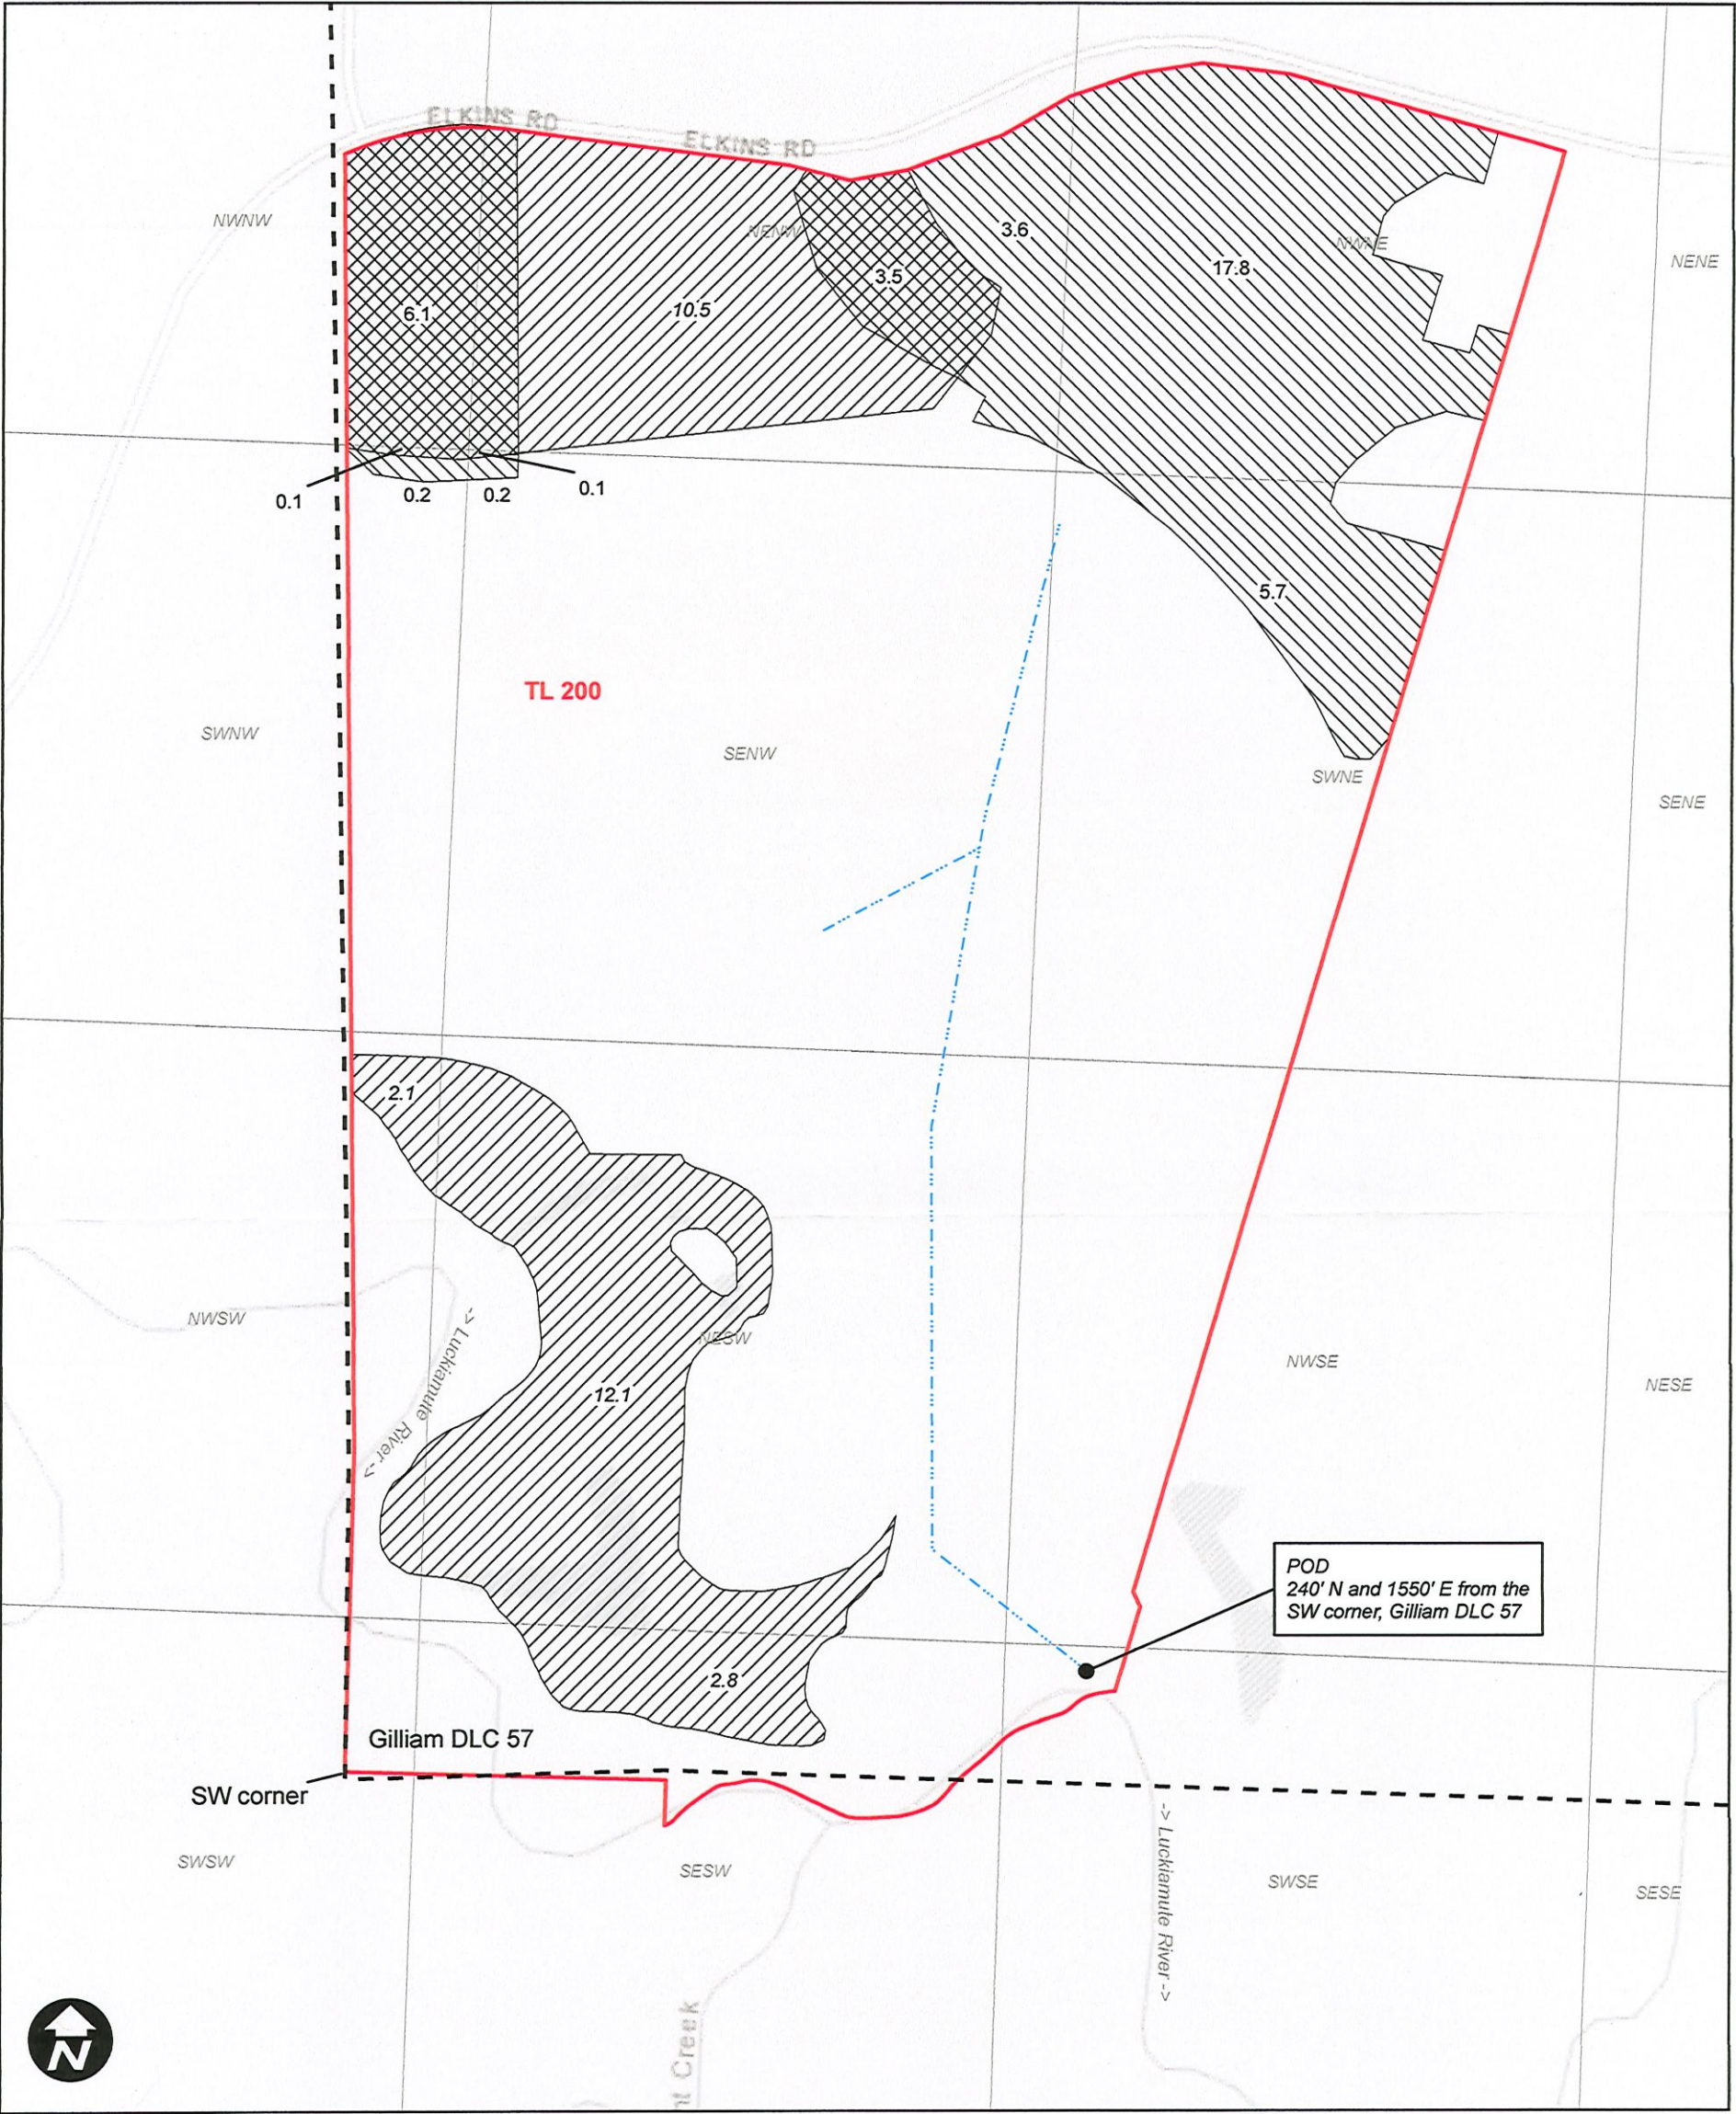


Legend

- Cert. 45701 From
- Cert. 45701 No Change
- Cert. 45701 To
- Mainline
- DLC
- Taxlot

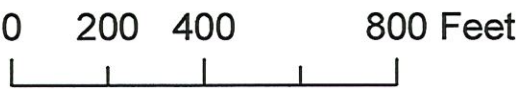

T.9S.R.5W.W.M.

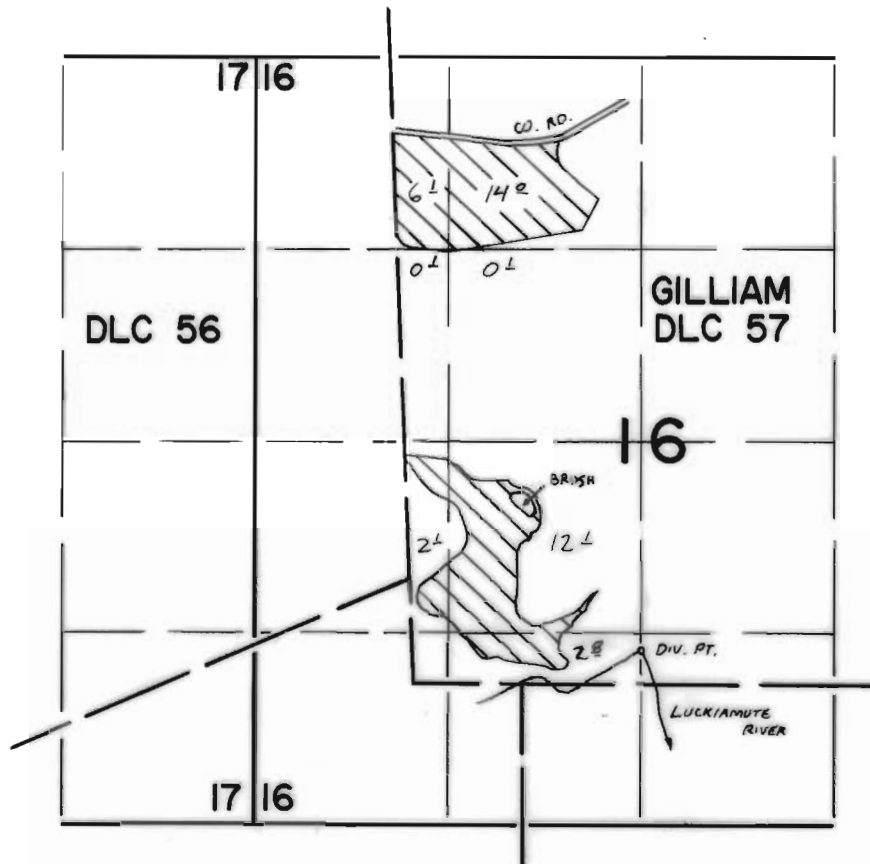

DIVERSION POINT LOCATED 240' N & 1550' W FROM THE SW COR
GILLIAM DLC 57

FINAL PROOF SURVEY
UNDER

Application No. 47785 Permit No. 35804
IN NAME OF

SILVERIO & IDA MANZI

Surveyed MAY 17 1976 by C. R. KING