
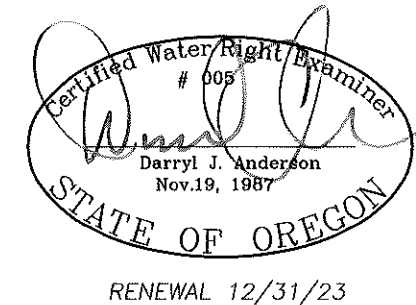


CLAIM OF BENEFICIAL
USE MAP
FOR
THE CON J FLYNN CREDIT
SHELTER TRUST
& D JACK FLYNN
SECTION 34, T36S R24E W.M.
LAKE COUNTY, OREGON

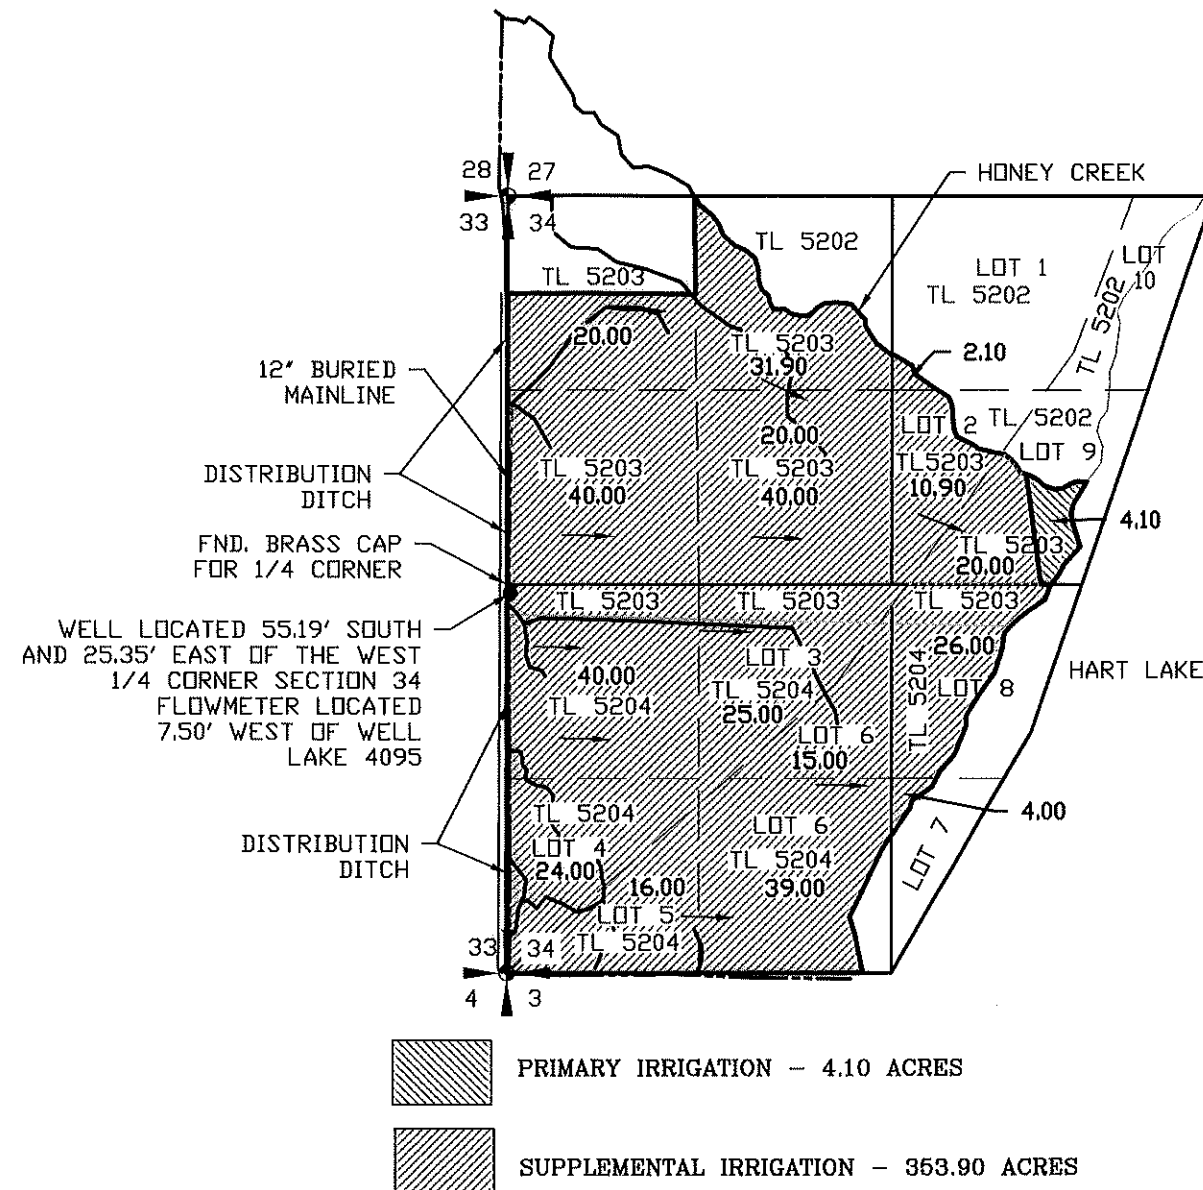

LEGEND

- SECTION LINE
- 1/4 SECTION LINE
- 1/16 SECTION LINE
- TAXLOT LINE
- WATERWAY
- MAINLINE
- FLOODING DIRECTION

SCALE: 1"=1320'

APPLICATION NO. G-16380

PERMIT NO. G-15953

NOTE:
PREPARATION OF THIS MAP IS FOR IDENTIFYING PROPOSED
WATER RIGHTS ONLY. IT HAS NO INTENT TO PROVIDE
LOCATIONS OR DIMENSIONS OF PROPERTY BOUNDARIES.

REVISION	BY

ANDERSON ENGINEERING
AND SURVEYING, INC.
P.O. BOX 28
LAKEVIEW, OREGON 97630
(541) 947-4407/FAX: 947-2321
WWW.ANDERSONENGINEERING.COM

FOR:
JACKIE MATHIS
28571 HOGBACK ROAD
FLUSH, OR 97637
541-947-2463

CLAIM OF BENEFICIAL USE MAP
APPLICATION NO. G-16380
PERMIT NO. G-15953

DATE: 2/3/2022
SCALE: 1" = 1320'
DWG. BY: R.C.
JOB: 2021-179
FILE: 2021-179
SHEET: 1 OF 1