


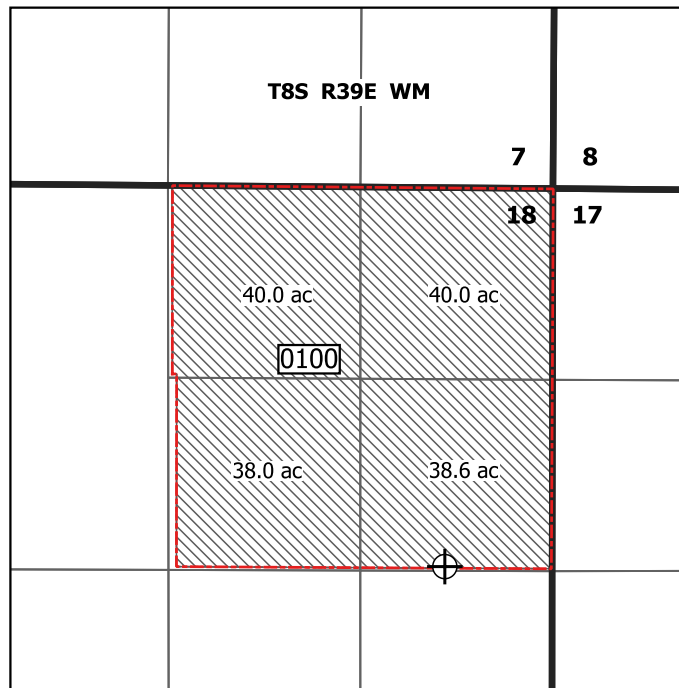

LEGEND

-  Authorized Place of Use (IS)
-  Well
-  Baker County Taxlot Boundary 0100



Claim of Beneficial Use Map Transfer T-11665 Baker County, OR

Prepared on Behalf of Brad Allen

Date: 10/23/2025
Drawn by: Paul F. Garvin

1 inch = 1,320 feet




Notes:

Well 2 (L-113685): 27 feet North and 736 feet West from E1/4 Corner, Section 18, T8S, R39E, W.M.

Flow measurement device is located within a 10 foot radius of Well 2



This map is not intended to provide legal dimensions or locations of property ownership lines.

**TRANSFER MAP TO ACCOMPANY
APPLICATION FOR AN ADDITIONAL
POINT OF APPROPRIATION
FOR
VIRGIL BORGER**

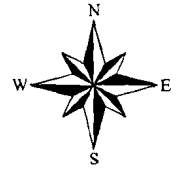


Scale: 1" = 1320'

T. 8S, R. 39E, WM

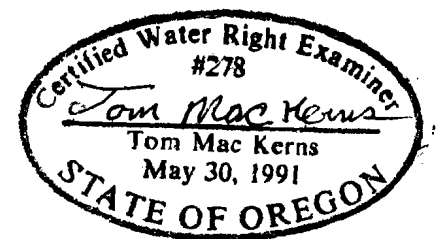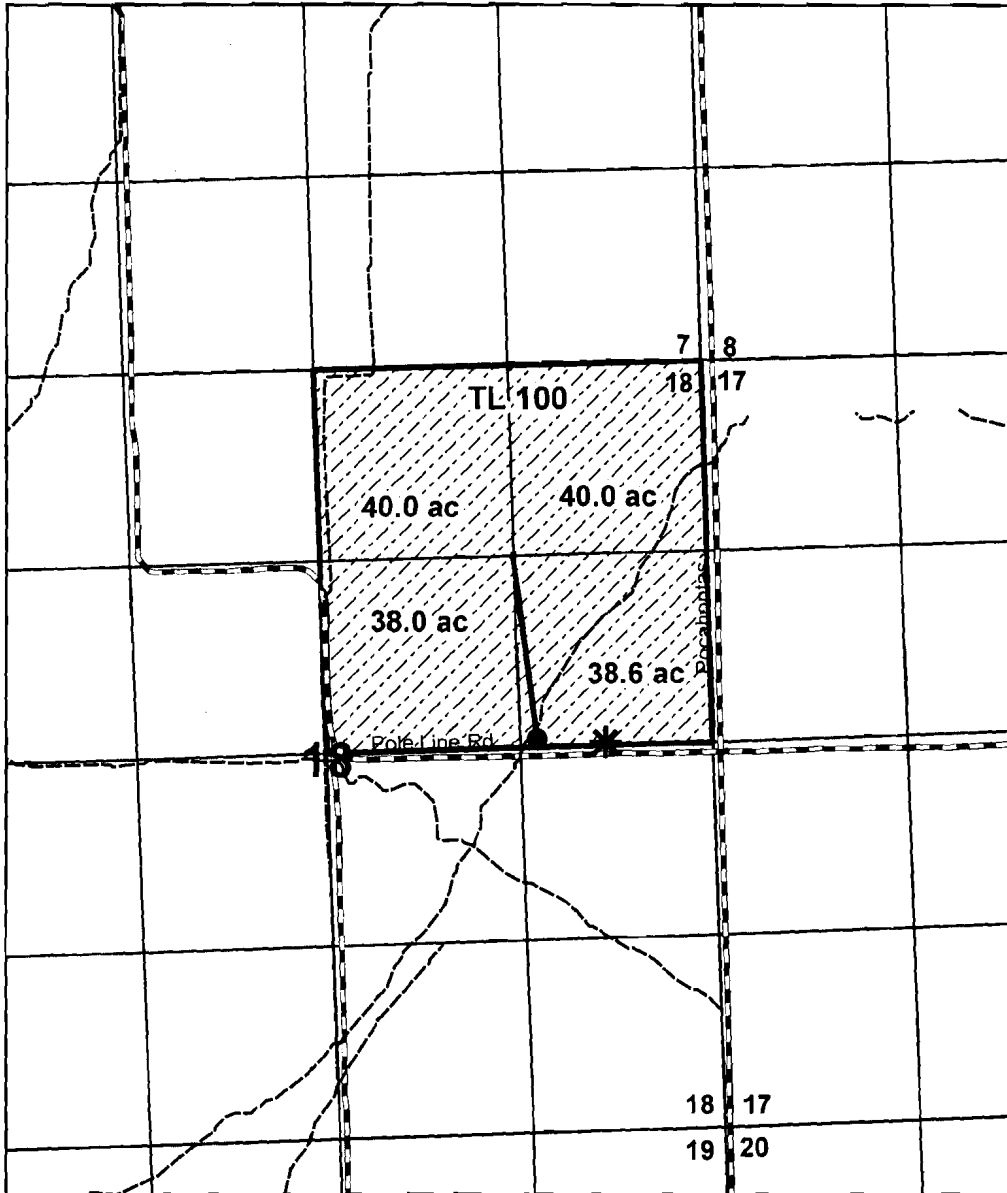

1011665

● Existing POA: Well #1: Located in SE 1/4 NE 1/4
50°N & 1260°W fr. E 1/4 Sect. 18,
T.8S, R.39E, WM

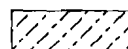

C-60027 12-27-1977
Supplemental Irrigation

* Proposed Add. POA: Well #2: Located in SE 1/4 NE 1/4
22°N & 736°W fr. E 1/4 Sect. 18,
T.8S, R.39E, WM



Mainline pipe system



Ditches



Roads

RECEIVED BY OWRD

SEP 23 2013

SALEM, OR