


Sections 17, 18, 19 & 20, T12S, R4W, W.M.,
Linn County, Oregon

Application G-18503, Permit G-18715
CLAIM OF BENEFICIAL USE MAP
Benjamin Verhoeven and Kathryn E. Weeks

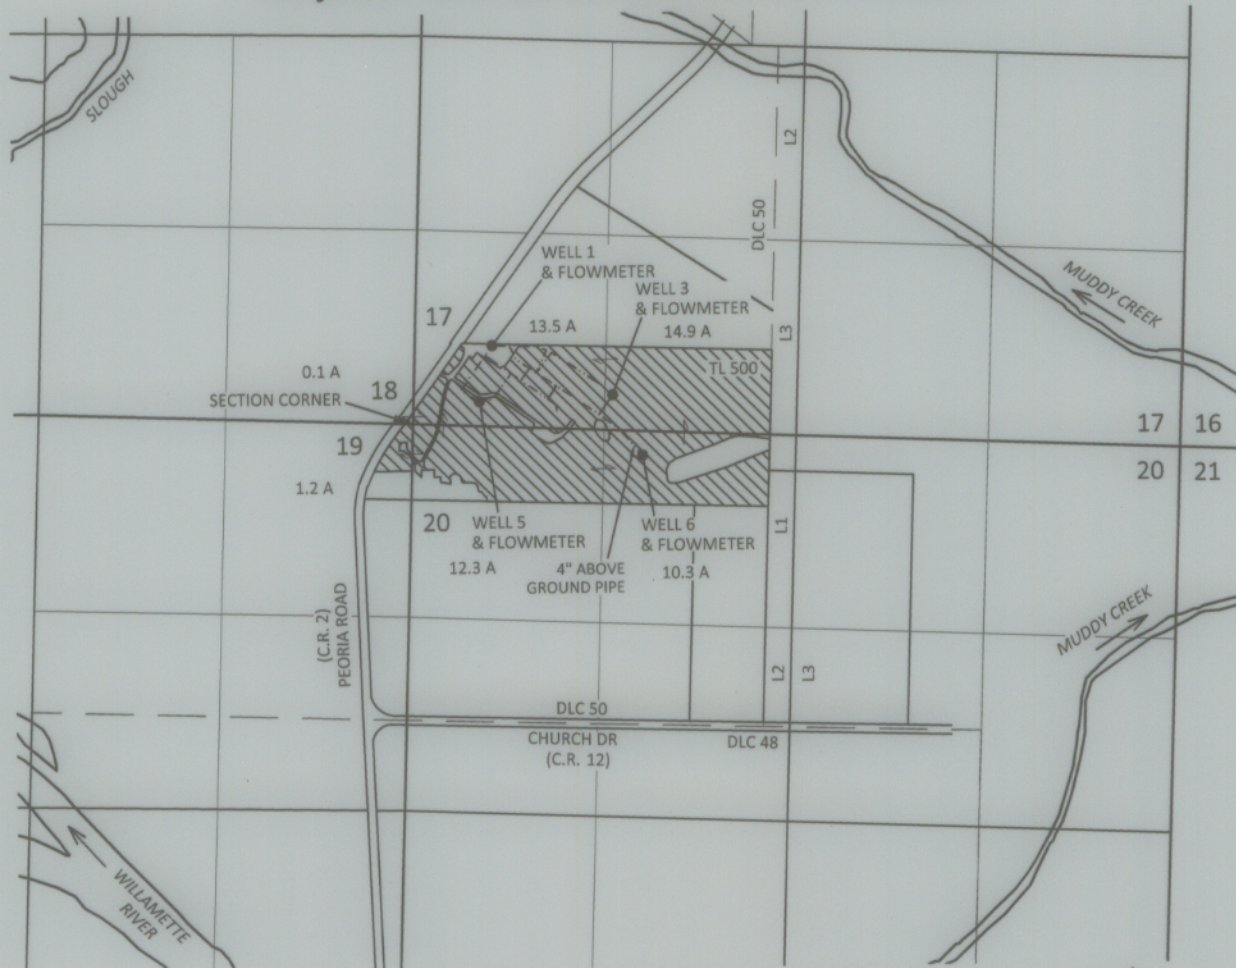

- WELL 1 LOCATION: 530 FT N AND 550 FT E FROM SW CORNER OF SECTION 17
- WELL 3 LOCATION: 180 FT N AND 1370 FT E FROM SW CORNER OF SECTION 17
- WELL 5 LOCATION: 150 FT N AND 460 FT E FROM SW CORNER OF SECTION 17
- WELL 6 LOCATION: 230 FT S AND 1570 FT E FROM NW CORNER OF SECTION 20

EXPLANATION




NURSERY PLACE OF USE
PRIORITY: MAY 5, 2017
52.3 ACRES



WELL & FLOWMETER



3" UNDERGROUND PIPELINE (APPROX.),
UNLESS OTHERWISE NOTED

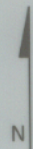


Site Inspection Conducted
10/24/2024

March 20, 2025

This map is not intended to provide legal
dimensions or locations of property
ownership lines

Figure 1

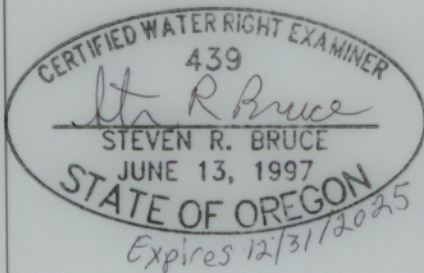

STEVEN R. BRUCE, RG, CWRE
1626 VICTORIAN WAY
EUGENE, OR 97401
(503) 319-8926

Received

MAR 26 2025

KPFF 2200002.36

OWRD