



Transfer T-13583
(T17S, R11E, Section 13)

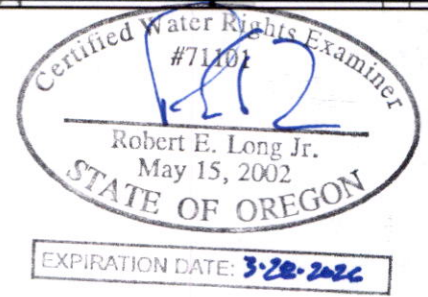

Well-1 (DESC-59909/64727)
Meter at wellhead
1,490 ft S and 1,350 ft W
of N1/4 Corner, Section 13

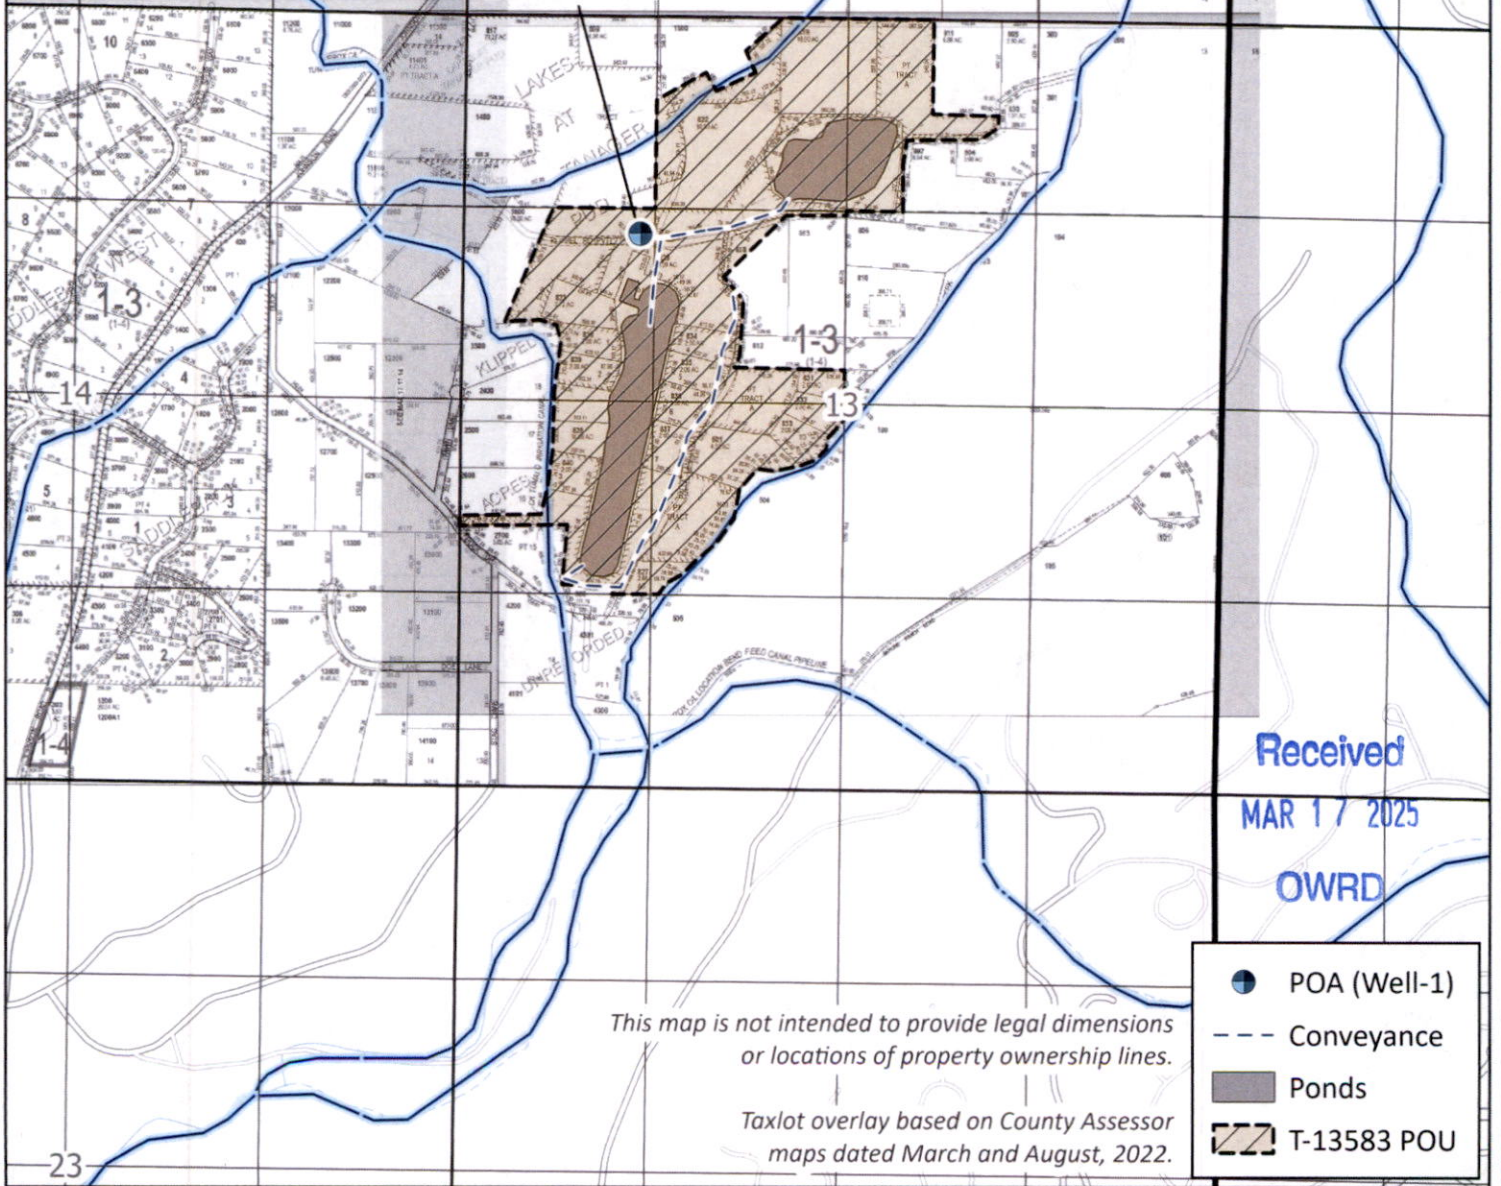

Received
MAR 17 2025
OWRD

- POA (Well-1)
- Conveyance
- Ponds
- ▨ T-13583 POU

This map is not intended to provide legal dimensions
or locations of property ownership lines.

Taxlot overlay based on County Assessor
maps dated March and August, 2022.

CwM-H2O
Complete Water Management

311 B Avenue, Suite P
Lake Oswego, Oregon 97034
(503) 954-1326

Figure 1
Claim of Beneficial Use Map for
Transfer with Multiple Changes ("To" Lands)

1	DATE	AUTH	DRAFT
No.	Date	By	Revisions

N
0 500 1,000 2,000 ft
Scale is 1" : 1,320'

Proj#: 1707005
KC Development Group COBU
KC Development Group, LLC
63560 Johnson Road
Bend, OR 97703