



MAP TO ACCOMPANY APPLICATION TO CHANGE PLACE OF USE & POINT OF DIVERSION FOR DUNBAR SILVIES RIVER RANCH, LLC


TAX LOT 4600
IN SECTION 27, TOWNSHIP 23 SOUTH, RANGE 32 EAST, W.M.
HARNEY COUNTY, OREGON

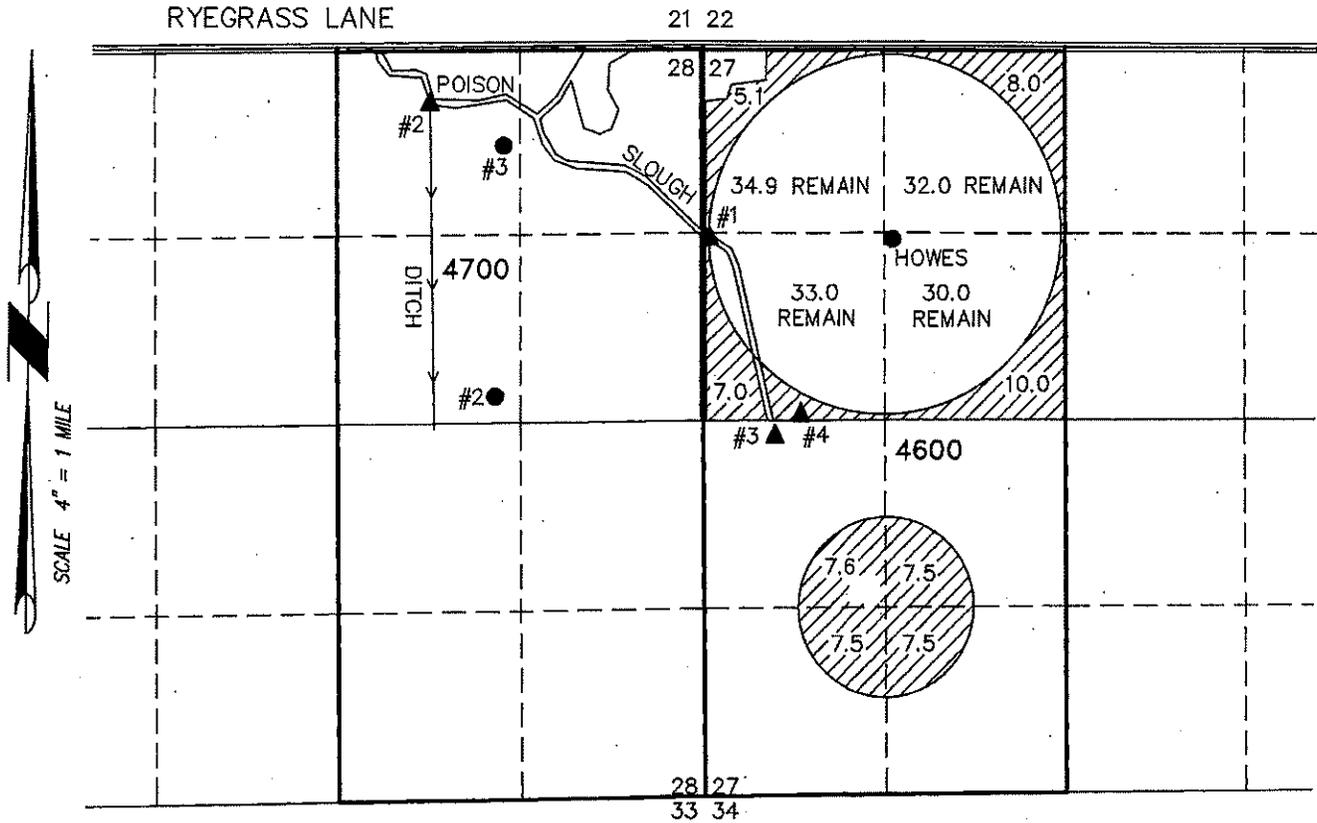

▲ AUTHORIZED POD #1 IN THE SW 1/4 OF THE NW 1/4 SECTION 27. GRAPHICALLY LOCATED MIDWAY BETWEEN N 1/16 & W 1/4 CORNERS OF SECTION 27.

▲ PROPOSED POD #4 IN THE SW 1/4 OF THE NW 1/4 SECTION 27. GEODETIC COORDINATES ARE 43°32'54.84" N & 118°52'46.84" W IN WGS84 PROJECTION.

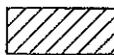 30.1 ACRES 'IR' FROM POISON CREEK SLOUGH CERTIFICATE 1991 (PERMIT 3372) TRANSFERRED.

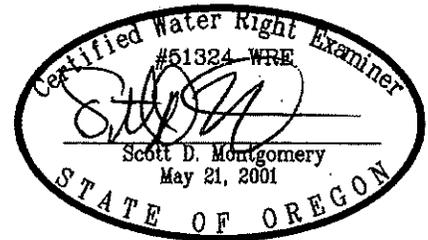

RENEWAL DATE: 12/31/2022

THIS MAP IS FOR THE PURPOSE OF LOCATING A WATER RIGHT ONLY AND HAS NO INTENT TO PROVIDE LEGAL DIMENSIONS OR THE LOCATION OF PROPERTY LINES.

PROJECT No. 18-003

PREPARED AT THE REQUEST OF:
DUNBAR SILVIES RIVER RANCH
9622 VICTOR ROAD
ANCHORAGE, AK 99515

**ALL POINTS ENGINEERING
& SURVEYING, INC.**




P.O. BOX 767
TERREBONNE, OREGON 97760
(541) 548-5833 PH
scott@apeands.com
www.APEandS.com


CLAIM OF BENEFICIAL USE MAP

TO CHANGE PLACE OF USE AND
POINT OF DIVERSION
FOR APPLICATION T-13395
DUNBAR'S SILVIES RIVER RANCH, LLC

TOWNSHIP 23 SOUTH, RANGE 32 EAST, SECTION 27, W.M.
TAX LOT: 4600 HARNEY COUNTY, OREGON

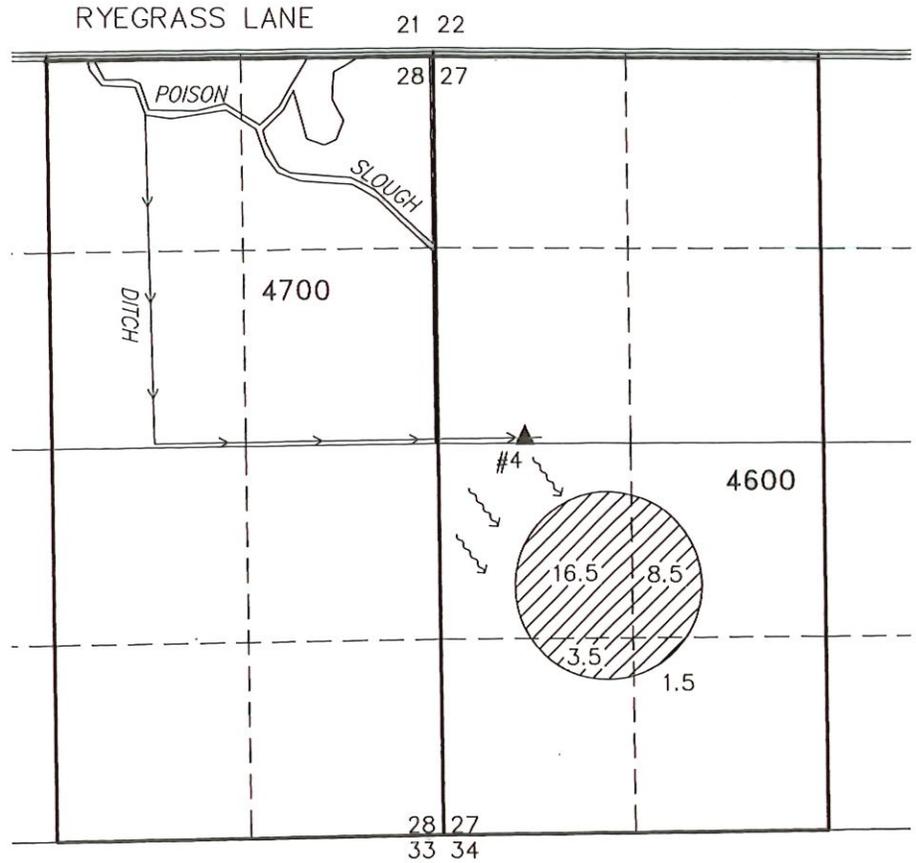

Received
OCT 10 2024
OWRD

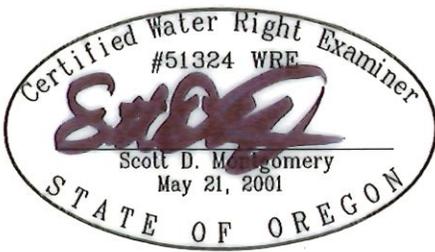

RENEWAL DATE: 12/31/2024

THIS MAP IS FOR THE PURPOSE OF LOCATING A WATER
RIGHT ONLY AND HAS NO INTENT TO PROVIDE LEGAL
DIMENSIONS OR THE LOCATION OF PROPERTY LINES

▲ POD #4 IN THE SW 1/4 OF THE NW 1/4 SECTION 27
LOCATED 2600' SOUTH & 590' EAST FROM THE NW
CORNER OF SECTION 27.

MEASURING DEVICE LOCATED 30' NORTH FROM POD.

 30.1 ACRES 'IR' FROM POISON CREEK
SLOUGH PER T-13395 (PERMIT 3372)

<p>PREPARED FOR:</p> <p>DUNBAR'S SILVIES RIVER RANCH, LLC 9622 VICTOR ROAD ANCHORAGE, AK 99516</p>	<p>PREPARED BY:</p>  <p>ALL POINTS ENGINEERING AND SURVEYING, INC. P.O. BOX 767 TERREBONNE, OR 97760 (541) 548-5833 www.APEandS.com</p>
--	--