


MAP TO ACCOMPANY APPLICATION TO CHANGE PLACE OF USE & ADD POINTS OF APPROPRIATION FOR DUNBAR SILVIES RIVER RANCH, LLC

TAX LOT 4600
IN SECTION 27, TOWNSHIP 23 SOUTH, RANGE 32 EAST, W.M.
HARNEY COUNTY, OREGON

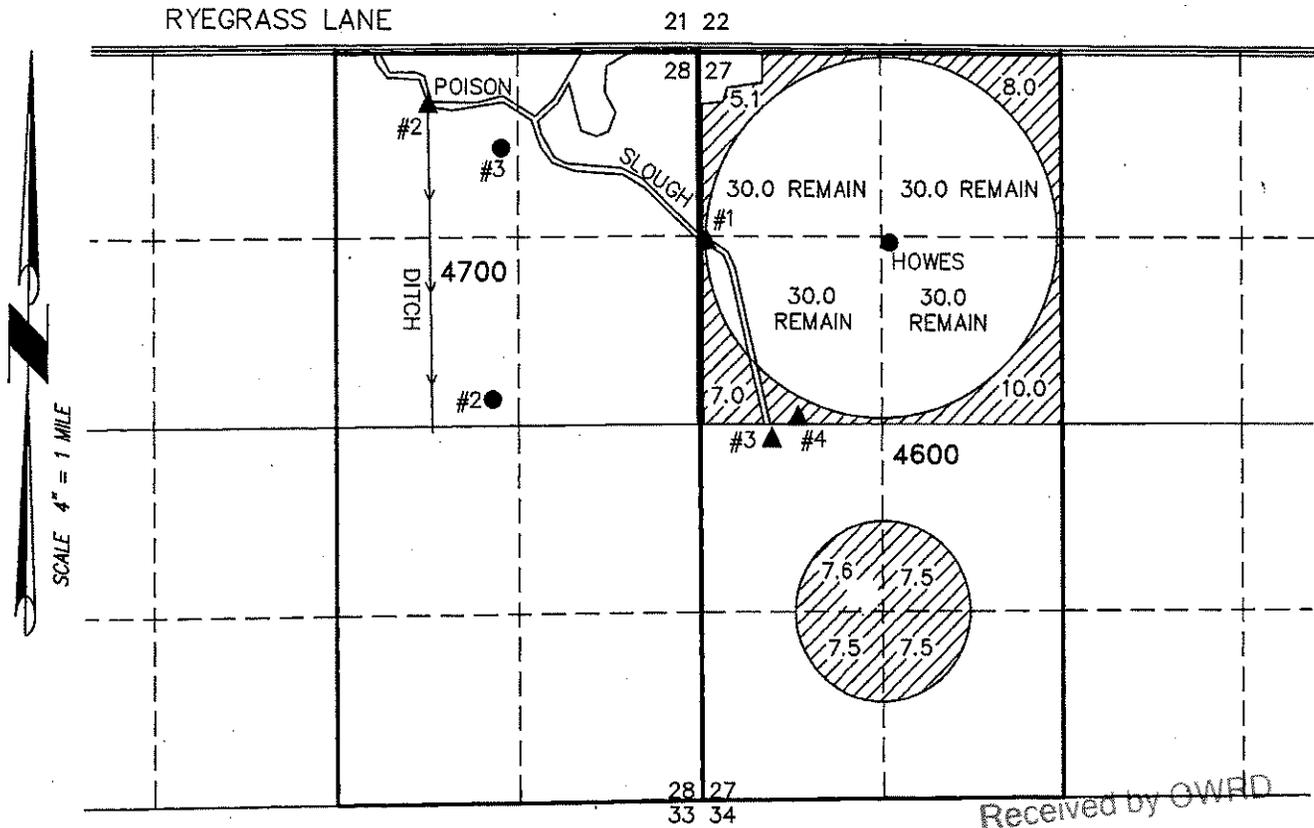


Received by OWRD

AUG 07 2021

Salem, OR

- WELL #2 (HARN 602) IN THE SW 1/4 OF THE NE 1/4 SECTION 28 & 2890' NORTH & 1520' WEST FROM THE SE CORNER SECTION 28.
- HOWES WELL (HARN 592) IN THE SE 1/4 OF THE NW 1/4 SECTION 27 & 20.5 CHAINS SOUTH & 21 CHAINS EAST FROM THE NW CORNER SECTION 27.
- WELL #3 (HARN 52832) IN THE NW 1/4 OF THE NE 1/4 SECTION 28 AT 43°33'14.87" N 118°53'16.62" W.

 30.1 ACRES 'IS' FROM HOWES WELL CERTIFICATE 28656 (PERMIT G-47) TRANSFERRED.

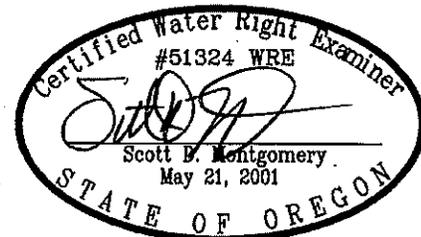

RENEWAL DATE: 12/31/2022

THIS MAP IS FOR THE PURPOSE OF LOCATING A WATER RIGHT ONLY AND HAS NO INTENT TO PROVIDE LEGAL DIMENSIONS OR THE LOCATION OF PROPERTY LINES.

PROJECT No. 18-003

PREPARED AT THE REQUEST OF:

DUNBAR SILVIES RIVER RANCH
9622 VICTOR ROAD
ANCHORAGE, AK 99515

ALL POINTS ENGINEERING
& SURVEYING, INC.



P.O. BOX 767
TERREBONNE, OREGON 97760
(541) 548-5833 PH
scott@apeands.com
www.APEandS.com

CLAIM OF BENEFICIAL USE MAP



TO CHANGE PLACE OF USE AND
ADD POINTS OF APPROPRIATION
FOR APPLICATION T-13395
DUNBAR'S SILVIES RIVER RANCH, LLC

TOWNSHIP 23 SOUTH, RANGE 32 EAST, SECTION 27, W.M.
TAX LOT: 4600 HARNEY COUNTY, OREGON



30.1 ACRES 'IS' FROM WELLS
HOWE, #2, & #3 PER
T-13395 (PERMIT G-47)

Received
OCT 10 2024
OWARD

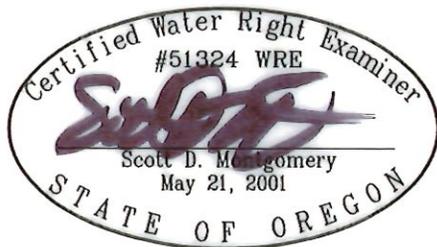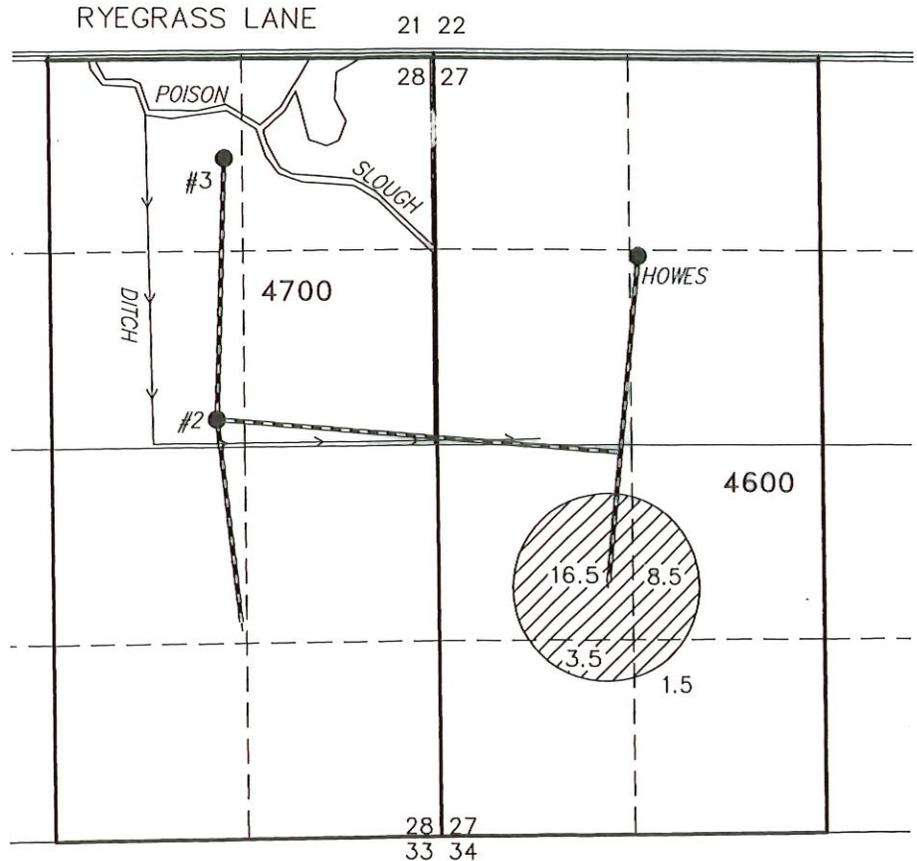

RENEWAL DATE: 12/31/2024

THIS MAP IS FOR THE PURPOSE OF LOCATING A WATER
RIGHT ONLY AND HAS NO INTENT TO PROVIDE LEGAL
DIMENSIONS OR THE LOCATION OF PROPERTY LINES

- WELL #2 (HARN 602) IN THE SW 1/4 OF THE NE 1/4 SECTION 28 & 2890' NORTH & 1520' WEST FROM THE SE CORNER SECTION 28.
FLOWMETER IS LOCATED 4.0' SE'LY FROM WELL.
- HOWES WELL (HARN 592) IN THE SE 1/4 OF THE NW 1/4 SECTION 27 & 20.5 CHAINS SOUTH & 21 CHAINS EAST FROM THE NW CORNER SECTION 27.
FLOWMETER IS LOCATED 6.0' S'LY FROM WELL.
- WELL #3 (HARN 52832) IN THE NW 1/4 OF THE NE 1/4 SECTION 28 & 700' SOUTH & 1450' WEST FROM THE NE CORNER OF SECTION 28.
FLOWMETER IS LOCATED 7.0' S'LY FROM WELL.

PREPARED FOR:

DUNBAR'S SILVIES RIVER RANCH, LLC
9622 VICTOR ROAD
ANCHORAGE, AK 99516

PREPARED BY:



ALL POINTS ENGINEERING AND SURVEYING, INC.
P.O. BOX 767 TERREBONNE, OR 97760
(541) 548-5833 www.APEandS.com